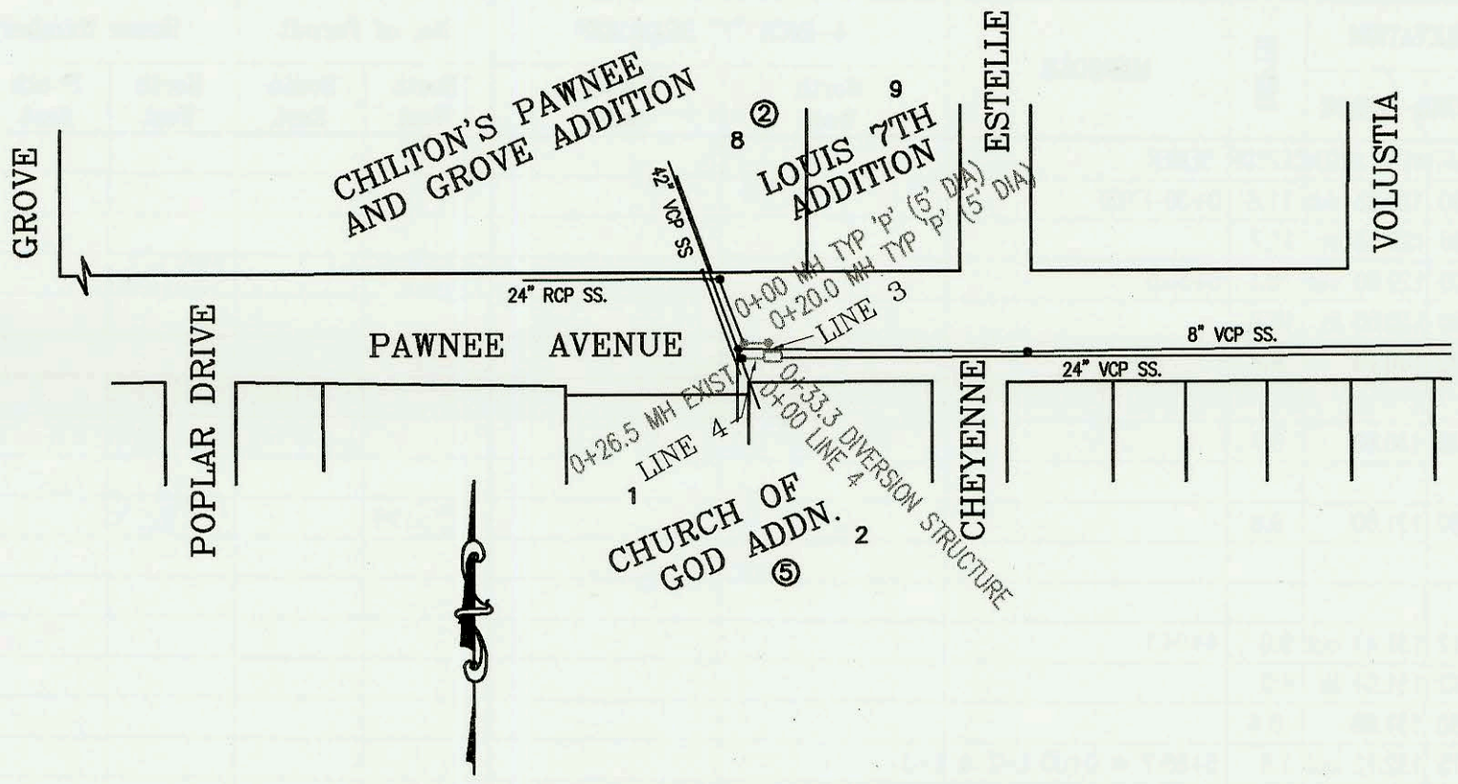

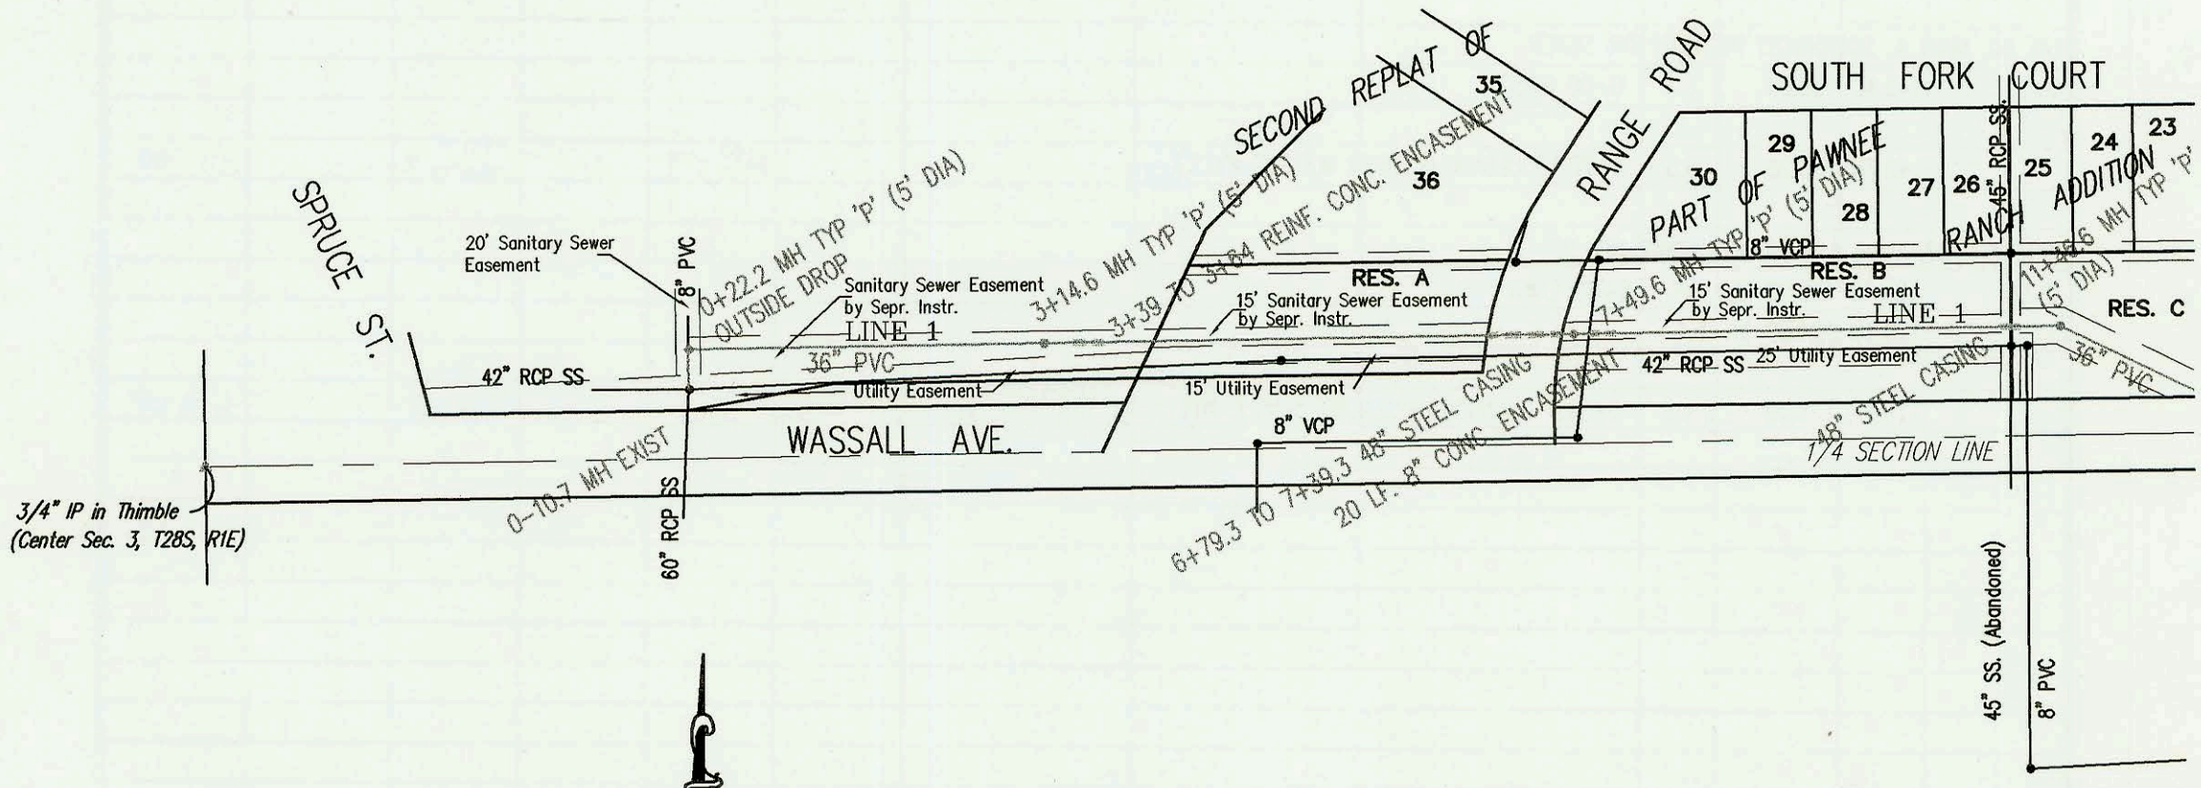

WAR INDUSTRIES RELIEF SEWER (PHASE 1A)
PROJECT NO. 468-82928 (623306)
BUILT BY W.B. CARTER CONSTRUCTION CO.
5/10/00 PER AS BUILT PLAN

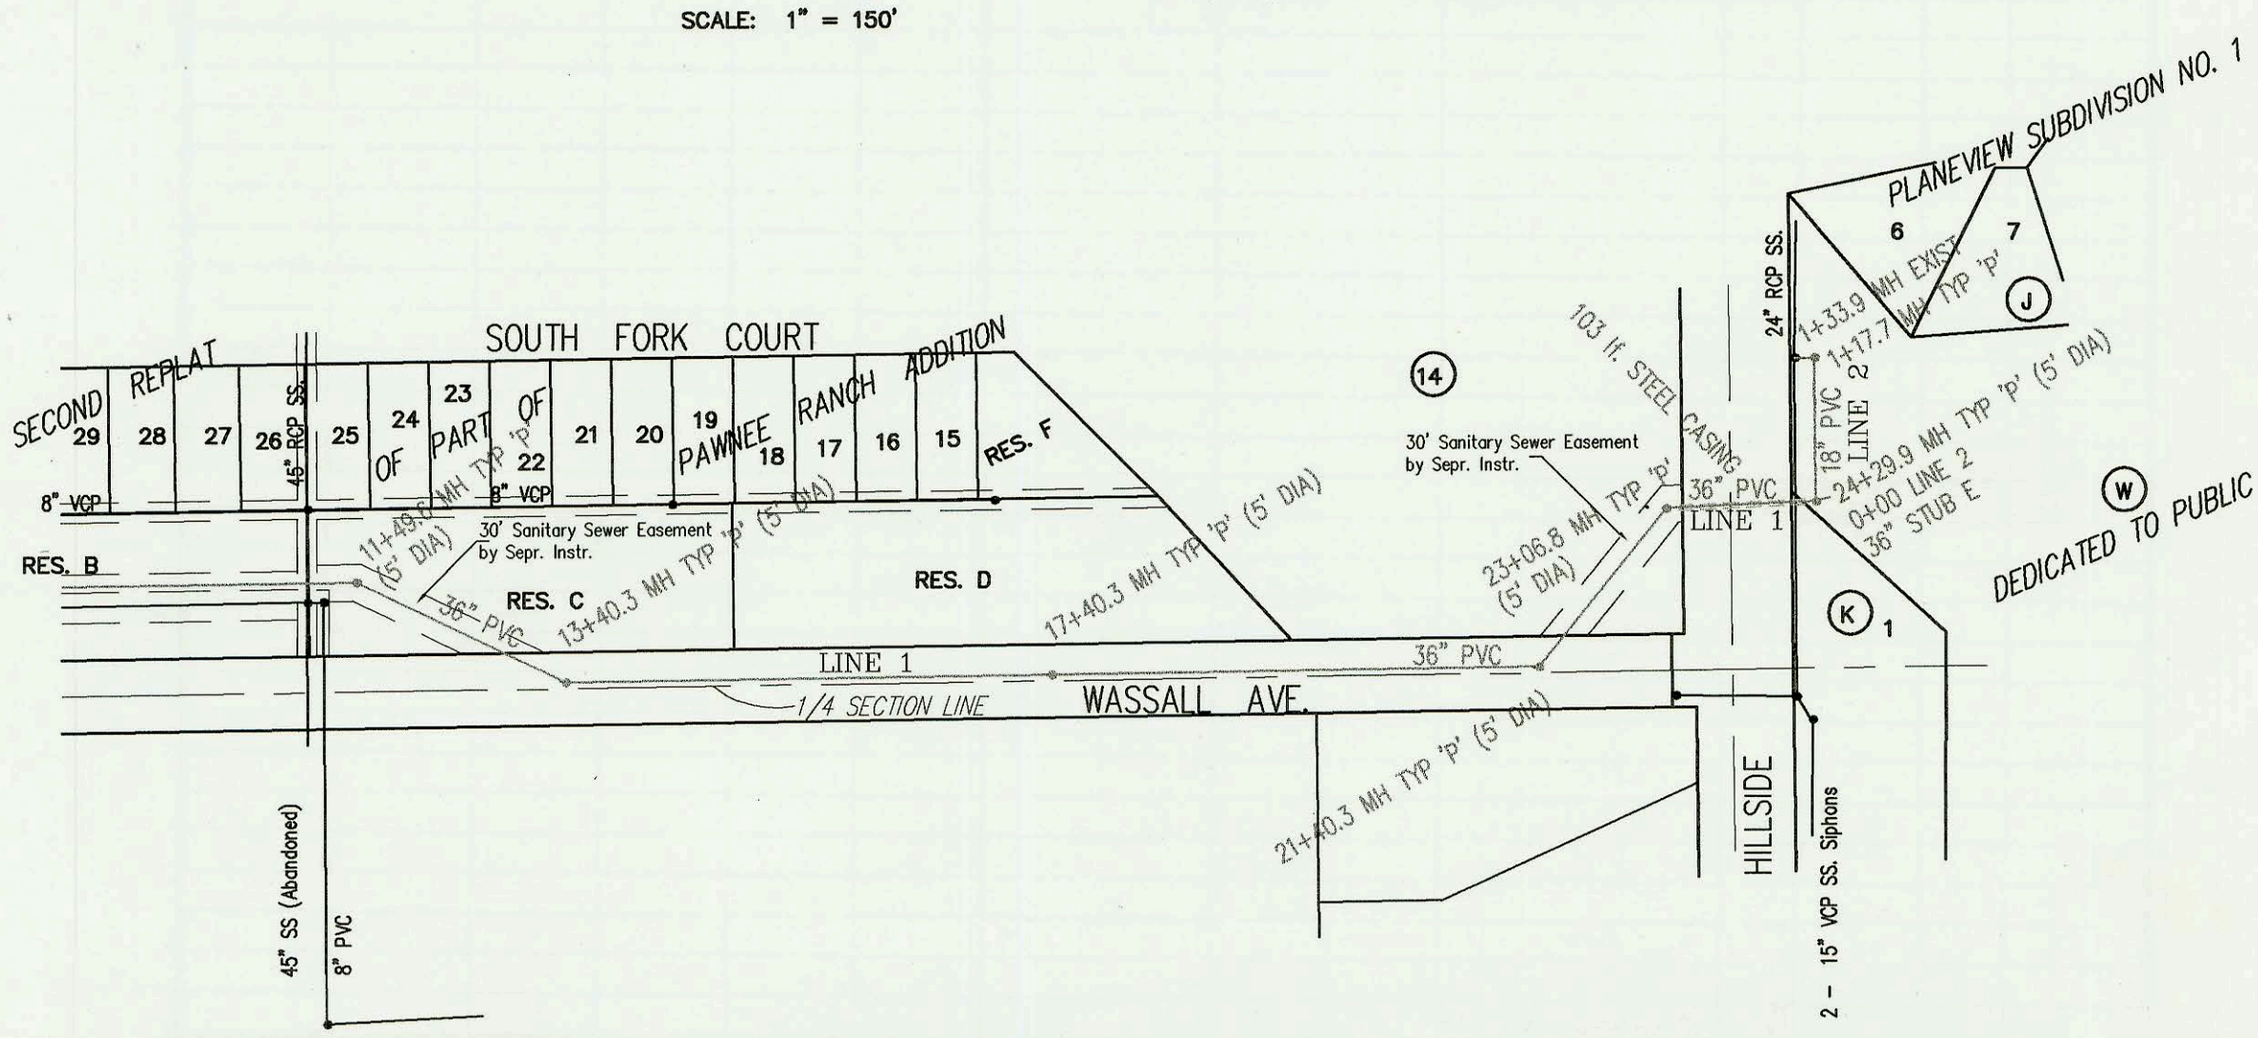

P-127

CONSTRUCTION RECORD							SERVICE RECORD					
STATION	ELEVATION		DEPTH	MANHOLE	4-INCH "Y" BRANCHES		No. of Permit		House Number		DATE OF PERMITS	
	GROUND	GRADE			North West	South East	North West	South East	North West	South East	North West	South East
WAR INDUSTRIES RELIEF SEWER (PHASE 1A)												
0-10.7 L-1	93.60	77.06 out	16.5	0-10.7 EXIST								
	93.60	77.10 in	16.5									
	93.30	77.13	16.2	0+22.2								
1+00	92.40	77.21	15.2									
2+00	91.50	77.31	14.2									
3+00	89.70	77.41	12.3									
	89.70	77.42	12.3	3+14.5								
4+00	86.60	77.51	9.1									
5+00	91.70	77.61	14.1									
6+00	92.50	77.71	14.8									
7+00	91.40	77.81	13.6									
	92.50	77.86	14.6	7+49.6								
8+00	92.20	77.91	14.3									
9+00	92.50	78.01	14.5									
10+00	93.60	78.11	15.5									
11+00	94.60	78.21	16.4									
	95.50	78.26 out	17.2	11+46.6								
	95.50	78.36 in	17.1									
12+00	95.70	78.46	17.2									
13+00	96.50	78.65	17.9									
	96.70	78.73 out	18.0	13+40.3								
	96.70	78.83 in	17.9									
14+00	97.30	78.92	18.4									
15+00	98.00	79.07	18.9									
16+00	98.40	79.22	19.2									
17+00	99.00	79.37	19.6									
	99.30	79.43	19.9	17+40.3								
18+00	99.40	79.52	19.9									
19+00	100.00	79.67	20.3									
20+00	100.40	79.82	20.6									
21+00	101.20	79.97	21.2									
	102.00	80.03 in	22.0	21+40.3								
	102.00	80.13 out	21.9									
22+00	102.20	80.22	22.0									
23+00	102.60	80.37	22.2									
	103.10	80.39 out	22.7	23+06.8								
	103.10	80.49 in	22.6									
24+00	102.70	80.62	22.1									
	103.90	80.67	23.2	24+29.9 = 0+00 L-2		36" STUB E 80.67						
0+00 L-2	103.90	80.67 out	23.2	0+00 = 24+31.8 L-1								
	103.90	89.58 in	14.3									
1+00	102.00	89.78	12.2									
	102.00	89.82 out	12.2	1+17.7								
	102.00	89.92 in	12.1									
	102.00	89.95 out	12.1	1+33.9 EXIST								
	102.00	87.95 in	14.1	YES THIS IS CORRECT								
0+00 L-3	96.10	89.75 out	6.3	0+00								
	96.10	89.80 in	6.3									
	96.10	89.84	6.3	0+20.0								
	95.40	89.88 out	5.5	0+33.3 Diverson Structure = 0+26.5 LINE 4								
	95.40	89.93 in	5.5									
0+00 L-4	95.40	85.11 out	10.3	0+00 EXIST								
	95.40	89.76 in	5.6									
	95.40	89.88	5.5	0+26.5 = 0+39.7 LINE 3								