


LATERAL 451, SOUTHWEST INTERCEPTOR SEWER
PROJECT NO. 468-83102 (743840)
BUILT BY UTILITY CONTRACTORS INC..
BOOKED 10/24/00 PER AS BUILT PLAN



SCALE: 1" = 100'

Refer to storm book A-497

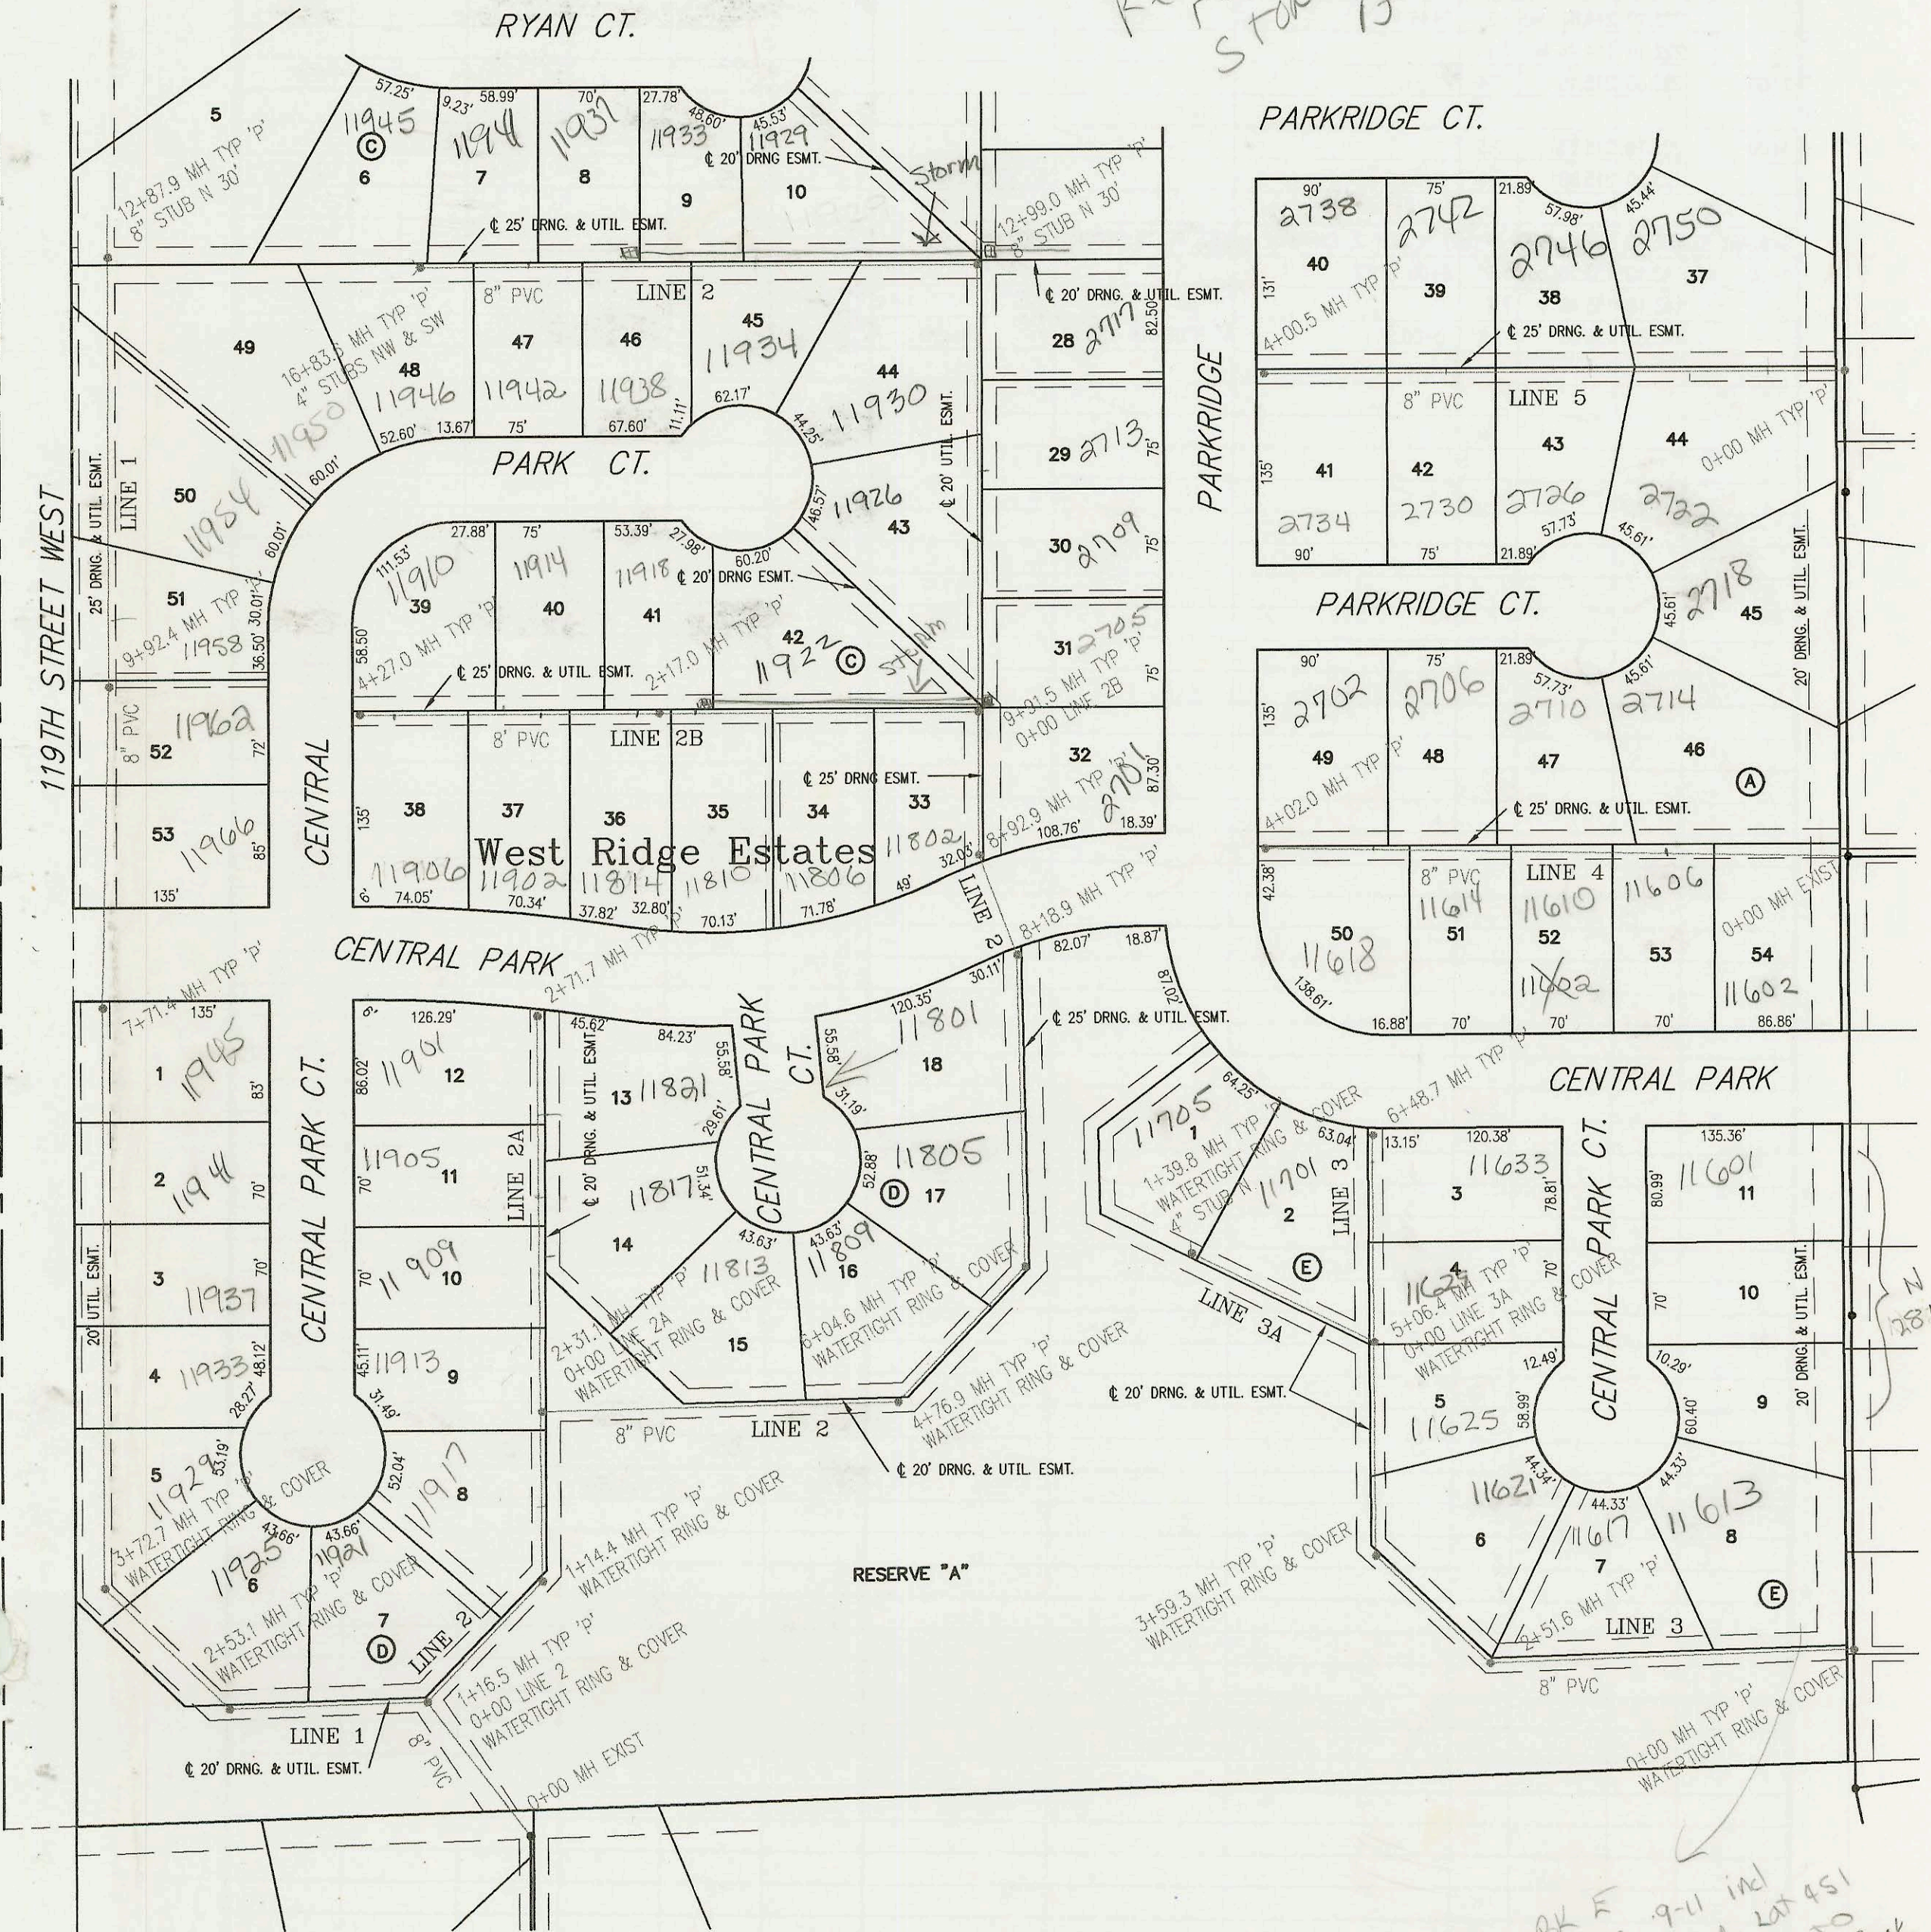

*BK E
LOTS 9-11 incl
in BLP for lot 451
but connecting to
lot 369 see book
N 282 for MH
1178*

CONSTRUCTION RECORD					SERVICE RECORD							
STATION	ELEVATION		DEPTH	MANHOLE	4-INCH "Y" BRANCHES		No. of Permit		House Number		DATE OF PERMITS	
	GROUND	GRADE			North West	South East	North West	South East	North West	South East	North West	South East
LATERAL 451, SOUTHWEST INTERCEPTOR SEWER												
0+00 L-1	170.30	159.39	10.9	0+00 EXIST								
1+00	168.00	159.69	8.3									
	169.40	159.74	out 9.7	1+16.5 = 0+00 L-2			2001-03030		11921 Central PK		11-28-01	
	169.40	159.84	in 9.6									
2+00	169.00	160.18	8.8									
	170.40	160.39	out 10.0	2+53.1								
	170.40	160.49	in 9.9				2002-00040		11925 Central PK		1-4-02	
3+00	170.10	160.68	9.4									
	170.70	160.97	out 9.7	3+72.7								
	170.70	161.07	in 9.6									
4+00	170.40	161.18	9.2									
5+00	170.80	161.58	9.2		4" SCH 40 5+30.4 Saddle							
6+00	170.10	161.98	8.1									
7+00	171.70	162.38	9.3									
	173.30	162.67	out 10.6	7+71.4								
	173.30	162.77	in 10.5									
8+00	172.60	162.88	9.7									
9+00	173.40	163.29	10.1									
	173.90	163.66	out 10.2	9+92.4	4" SCH 40 PVC 10+39.4 Saddle							
	173.90	163.76	in 10.1									
10+00	173.60	163.79	9.8									
11+00	173.90	164.76	9.1									
12+00	174.10	165.76	8.3									
	174.50	166.60	7.9	12+87.9	8" STUB N 0' 166.70							
0+00 L-2	170.60	159.84	10.8	0+00 1+16.5 L-1								
1+00	170.10	160.15	9.9									
	170.40	160.19	out 10.2	1+14.4	4" SCH 40 1+64.4							
	170.40	160.29	in 10.1									
2+00	170.10	160.55	9.5									
	170.40	160.65	out 9.8	2+31.1 = 0+00 L-2A								
	170.40	160.75	in 9.7									
3+00	167.80	160.96	6.8									
4+00	169.50	161.26	8.2									
	170.40	161.49	out 8.9	4+76.9	4" SCH 40 4+98.9 Saddle							
	170.40	161.59	in 8.8									
5+00	170.10	161.66	8.4									
6+00	170.10	161.98	8.1									
	170.40	162.00	out 8.4	6+04.6								
	170.40	162.10	in 8.3									
7+00	171.80	162.39	9.4									
8+00	173.50	162.69	10.8									
	174.00	162.75	out 11.3	8+18.9								
	174.00	162.85	in 11.2									
	174.00	163.08	out 10.9	8+92.9	4" SCH 40 9+52.5 Saddle							
	174.00	163.18	in 10.8									
9+00	173.70	163.20	10.5									
	172.70	163.48	out 9.2	9+91.5 = 0+00 L-2B								
	172.70	163.58	in 9.1									
10+00	172.40	163.66	8.7									
11+00	173.30	164.54	8.8									
12+00	174.30	165.42	8.9									
	174.70	166.30	out 8.4	12+99.0	8" STUB N 30' 166.40							
	174.70	166.40	in 8.3									
13+00												
14+00	175.40	166.82	8.6									

