P-156A

SANITARY SEWER TO SERVE
BARNUM ADDITION
PROJECT NO. 840PPS
BUILT BY DOUBLE B EXCAVATING
BOOKED 10/31/00 PER AS BUILT PLAN

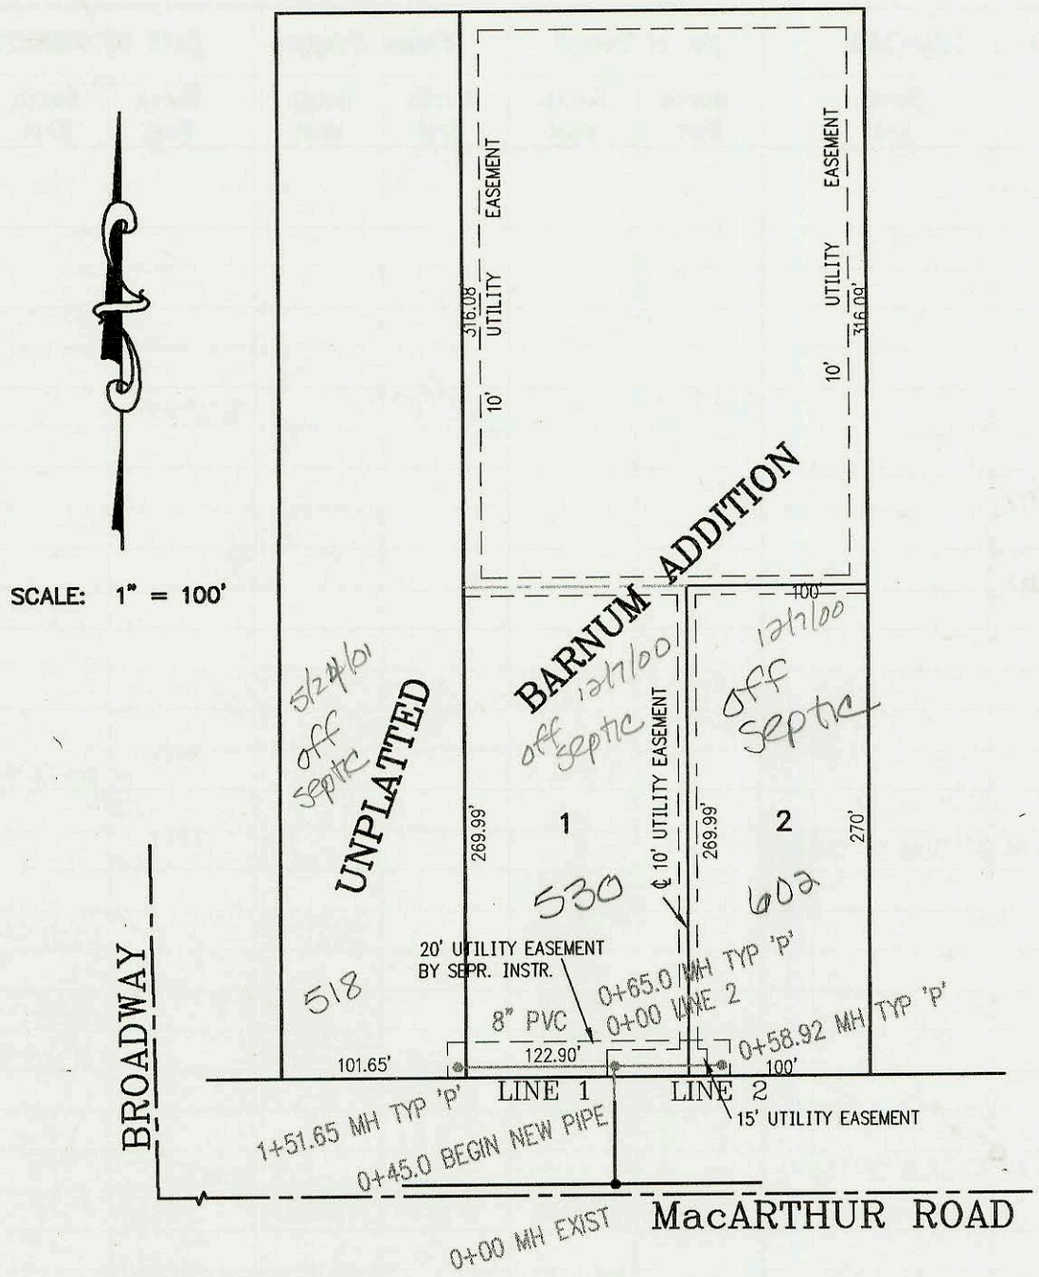

SANITARY SEWER TO SERVE LOT 1,
UNIVERSAL 4TH ADDITION
PROJECT NO. 1053PPS
BUILT BY DONDLINGER AND SONS CONSRUCTION CO.
BOOKED 10/30/00 PER AS BUILT PLAN

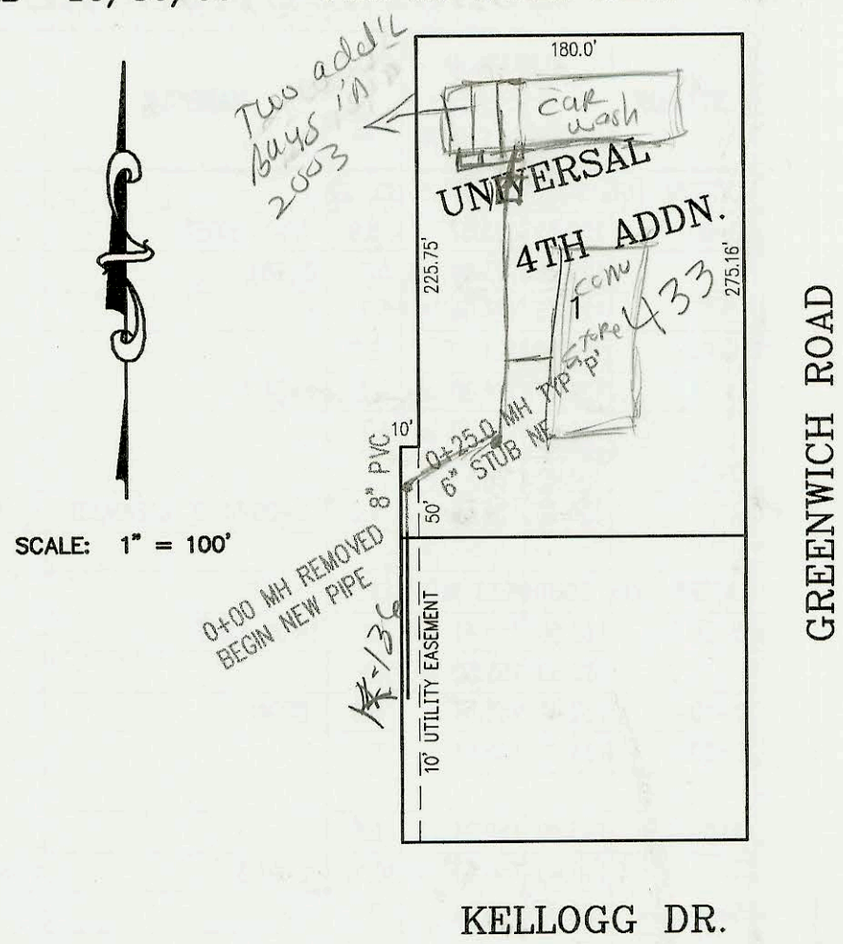

SANITARY SEWER TO SERVE 2121 S. MERIDIAN (QUIET THUNDER)
LOT 10 & 11, BLK 1, SOUTHWEST INDUSTRIAL ADDITION
PROJECT NO. 1025PPS
BUILT BY McCULLOUGH EXCAVATION
BOOKED 10/31/00 PER AS BUILT PLAN

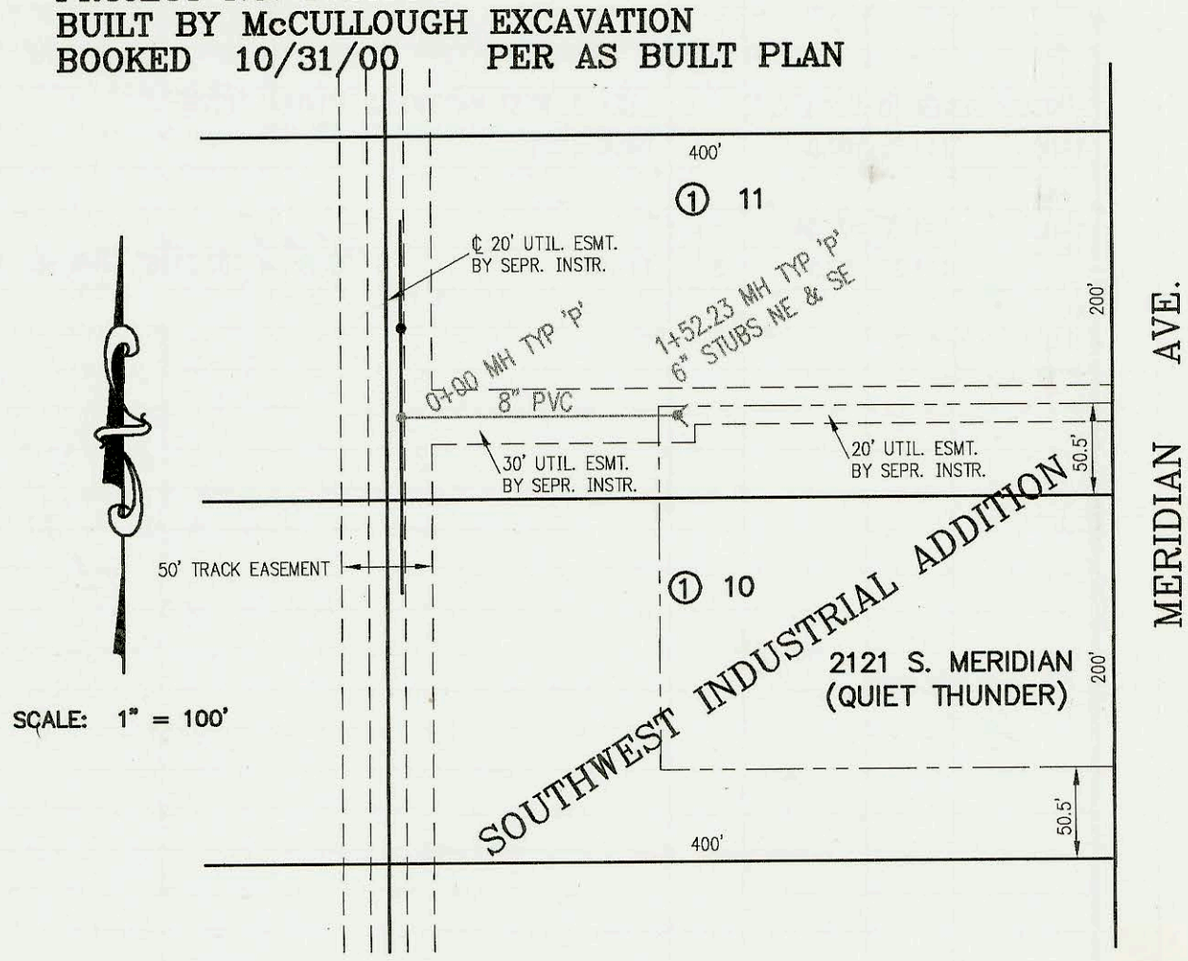

Do not issue sewer permit until cleared by city Engineer's office
12/30/03

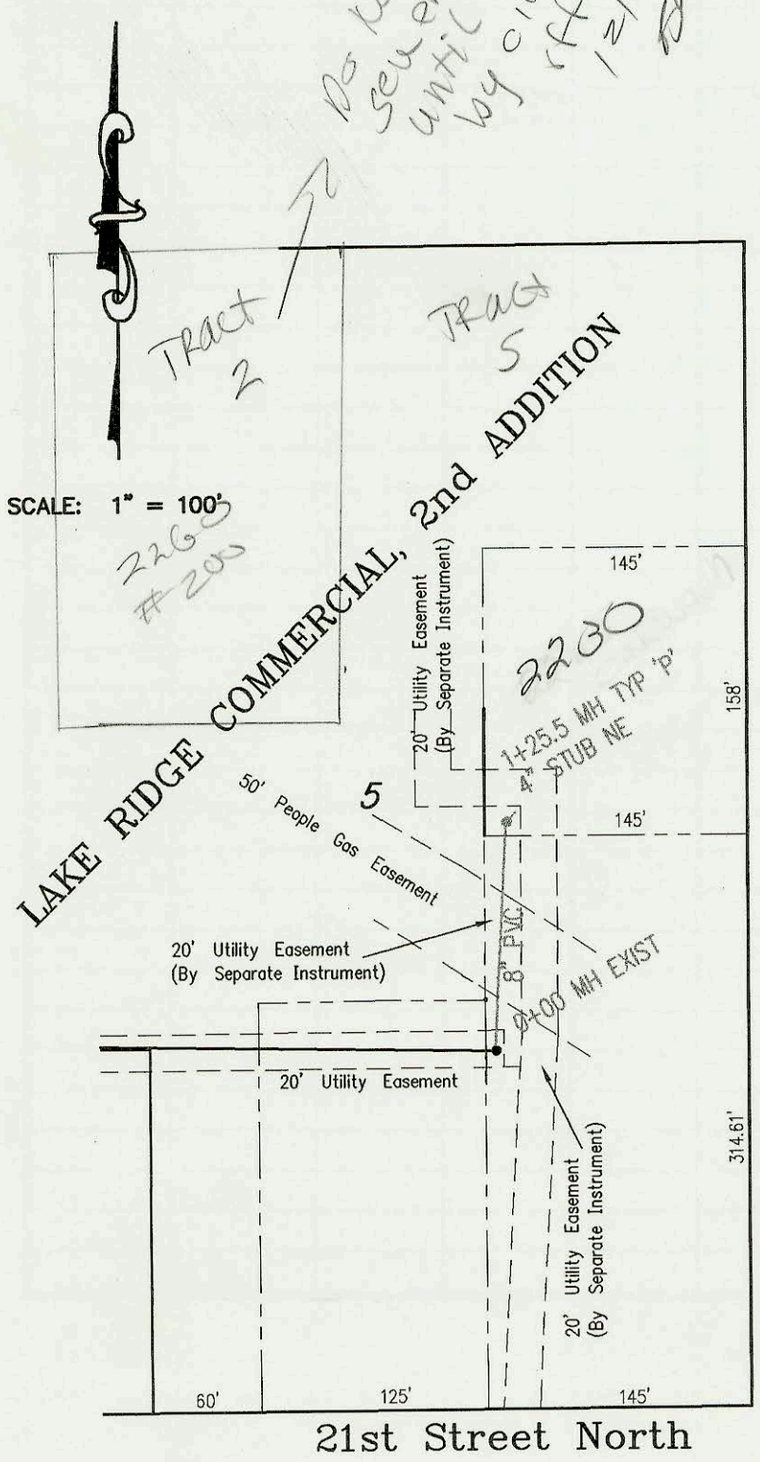

SANITARY SEWER TO SERVE PART OF LOT 5, LAKE RIDGE
COMMERCIAL 2ND ADDITION (RENO & FIEGAL BLDG.)
PROJECT NO. 985PPS
BUILT BY McCULLOUGH EXCAVATION
BOOKED 10/31/00 PER AS BUILT PLAN

P-156

CONSTRUCTION RECORD							SERVICE RECORD					
STATION	ELEVATION		DEPTH	MANHOLE	4-INCH "Y" BRANCHES		No. of Permit		House Number		DATE OF PERMITS	
	GROUND	GRADE			North West	South East	North West	South East	North West	South East	North West	South East
SANITARY SEWER TO SERVE LOT 1, UNIVERSAL 4TH ADDITION (1053PPS)												
0+00	163.90	153.09	10.8						Rep see below (conv. store or car wash)			
	164.00	153.25	10.8	0+25.0	6" STUB NE 153.36		2000 02082		433 S. Greenwich		9-4-00	
SANITARY SEWER TO SERVE BARNUM ADDITION (840PPS)												
0+00 L-1	89.90	76.14 out	13.8	0+00 EXIST								
	89.90	76.34 in	13.6									
	88.98	76.59 out	12.4	0+65.0 = 0+00 L-2	4" SCH40 DL 0+95 TAP		2001-00377		530 E MacArthur		12-7-00	
	88.98	76.79 in	12.2									
1+00	88.70	76.93	11.8		4" SCH40 1+47.65 Predco		2001-01268		518 E MacArthur		5-22-01	
	89.18	77.14	12.0	1+51.65								
0+00 L-2	88.98	76.79	12.2	0+00 = 0+65.0 L-1								
	89.05	77.03	12.0	0+58.92	4" SCH40 DL 0+31.92 TAP		2001-00375		602 E MacArthur		12-7-00	
SANITARY SEWER TO SERVE 2121 S. MERIDIAN (QUIET THUNDER) 1025 PPS												
LOTS 10 & 11, BLK 1, SOUTHWEST INDUSTRIAL ADDITION												
0+00 L-1	103.88	97.67 out	6.2	0+00								
	103.88	98.09 in	5.8									
1+00	104.00	98.41	5.6									
	104.56	98.58	6.0	1+52.23	6" STUB NE 98.75	4" SCH40 6" STUB SE 98.75		2000 12034		2121 S. Meridian		9/15/00
SANITARY SEWER TO SERVE PART OF LOT 5, LAKE RIDGE COMMERCIAL 2ND ADDITION (RENO & FIEGEL BLDG.) 985PPS												
0+00	140.90	135.07 out	5.8	0+00 EXIST								
	140.90	135.15 in	5.8									
1+00	141.30	135.64	5.7									
	141.77	135.76	6.0	1+25.5	4" STUB NE 135.87		2000 02024		2230 N Ridge		9/20/00	

Rep
SWR 2003-02601 10/2/03 433 S. Green wich (add of Two Bays to car wash)
J-Hawk Plbg