


LATERAL 41, MAIN 21, SANITARY SEWER NO. 22
 PROJECT NO. 468-83362 (743904)
 BUILT BY UTILITY CONTRACTORS INC.
 5/21/02 PER AS BUILT PLAN

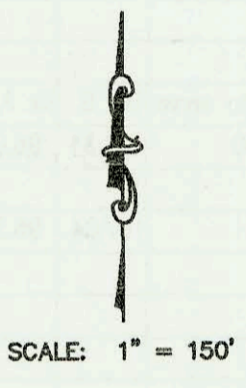

Church bldg cannot connect to line on side of Main w/ 10' x 15' x 10' pit w/ Huang 2/10/03

Portability bldg connected

Plans in computer

37th St. N. - 10' sewer & utility easement

20' sanitary sewer easement by sepr. instrument
Lot 1, Blk 1
29+38.87 MH TYP 'P' 4\" STUB SW
8\" PVC
25+29.18 MH TYP 'P' 8\" STUB N
20' UTILITY EASEMENT
21+23.39 MH TYP 'P' 8\" STUB W
18+63.12 MH TYP 'P' 4\" STUB N
10' SEWER & UTILITY EASEMENT
8\" PVC
18+63.12 MH TYP 'P' 4\" STUB N
17+81.47 MH TYP 'P' 8\" STUB W
14+81.47 MH TYP 'P' 10\" PVC
12+33.76 MH TYP 'P' 10\" PVC
8+33.76 MH TYP 'P' 20' UTILITY EASEMENT
4+33.76 MH TYP 'P' 8\" STUB S
1+49.14 MH TYP 'P' 10\" PVC
0+00 MH EXIST

SE Cor. Sec. 25 T26 S, R 1 W

CONSTRUCTION RECORD						SERVICE RECORD						
STATION	ELEVATION		DEPTH	MANHOLE	4-INCH "Y" BRANCHES		No. of Permit		House Number		DATE OF PERMITS	
	GROUND	GRADE			North West	South East	North West	South East	North West	South East	North West	South East
LATERAL 41, MAIN 21, SANITARY SEWER NO. 22												
0+00 L-1	137.55	122.30 out	15.3	0+00 EXIST								
	137.55	122.40 in	15.2									
1+00	134.20	122.56	11.6									
	133.99	122.64	11.4	1+49.19								
2+00	132.90	122.72	10.2									
3+00	132.20	122.88	9.3									
4+00	132.60	123.04	9.6									
	133.22	123.09	10.1	4+33.76		8" STUB S 123.26						
5+00	131.70	123.20	8.5									
6+00	133.20	123.36	9.8									
7+00	133.50	123.52	10.0									
8+00	133.60	123.68	9.9									
	133.97	123.73	10.2	8+33.76								
9+00	133.60	123.84	9.8									
10+00	134.30	124.00	10.3									
11+00	133.50	124.16	9.3									
12+00	133.60	124.32	9.3									
	134.10	124.37	9.7	12+33.76								
13+00	134.00	124.48	9.5									
14+00	134.50	124.64	9.9									
	135.02	124.77	10.3	14+81.47								
15+00	134.40	124.83	9.6									
16+00	134.50	125.18	9.3									
17+00	134.70	125.53	9.2									
	135.55	125.82 out	9.7	17+81.47								
	135.55	125.92 in	9.6									
18+00	134.40	125.98	8.4									
	136.02	126.21 out	9.8	18+63.12	4" STUB N 126.64							
	136.02	126.31 in	9.7		DL Tap 18+80.2		2000-00459	2424 W 37th ST N		2-20-02		
19+00	135.20	126.43	8.8									
20+00	135.70	126.78	8.9									
21+00	135.90	127.13	8.8									
	135.00	127.21 out	7.8	21+23.39	8" STUB W 127.31							
	135.00	127.31 in	7.7									
22+00	133.80	127.58	6.2									
23+00	134.00	127.93	6.1									
24+00	134.10	128.28	5.8									
							2003					
25+00	135.80	128.63	7.2									
	134.87	128.73 out	6.1	25+29.18	8" STUB N 128.83						2-10-03	
	134.87	128.83 in	6.0									
26+00	135.70	129.08	6.6									
27+00	136.60	129.43	7.2									
							2003					
28+00	136.50	129.78	6.7									
29+00	136.20	130.13	6.1									
	136.38	130.28	6.1	29+38.87	4" STUB SW 130.61						2-10-03	

2003
 38th N Meridian (2-10-03)
 61050
 30th N Meridian (School)
 2-10-03