P-242A

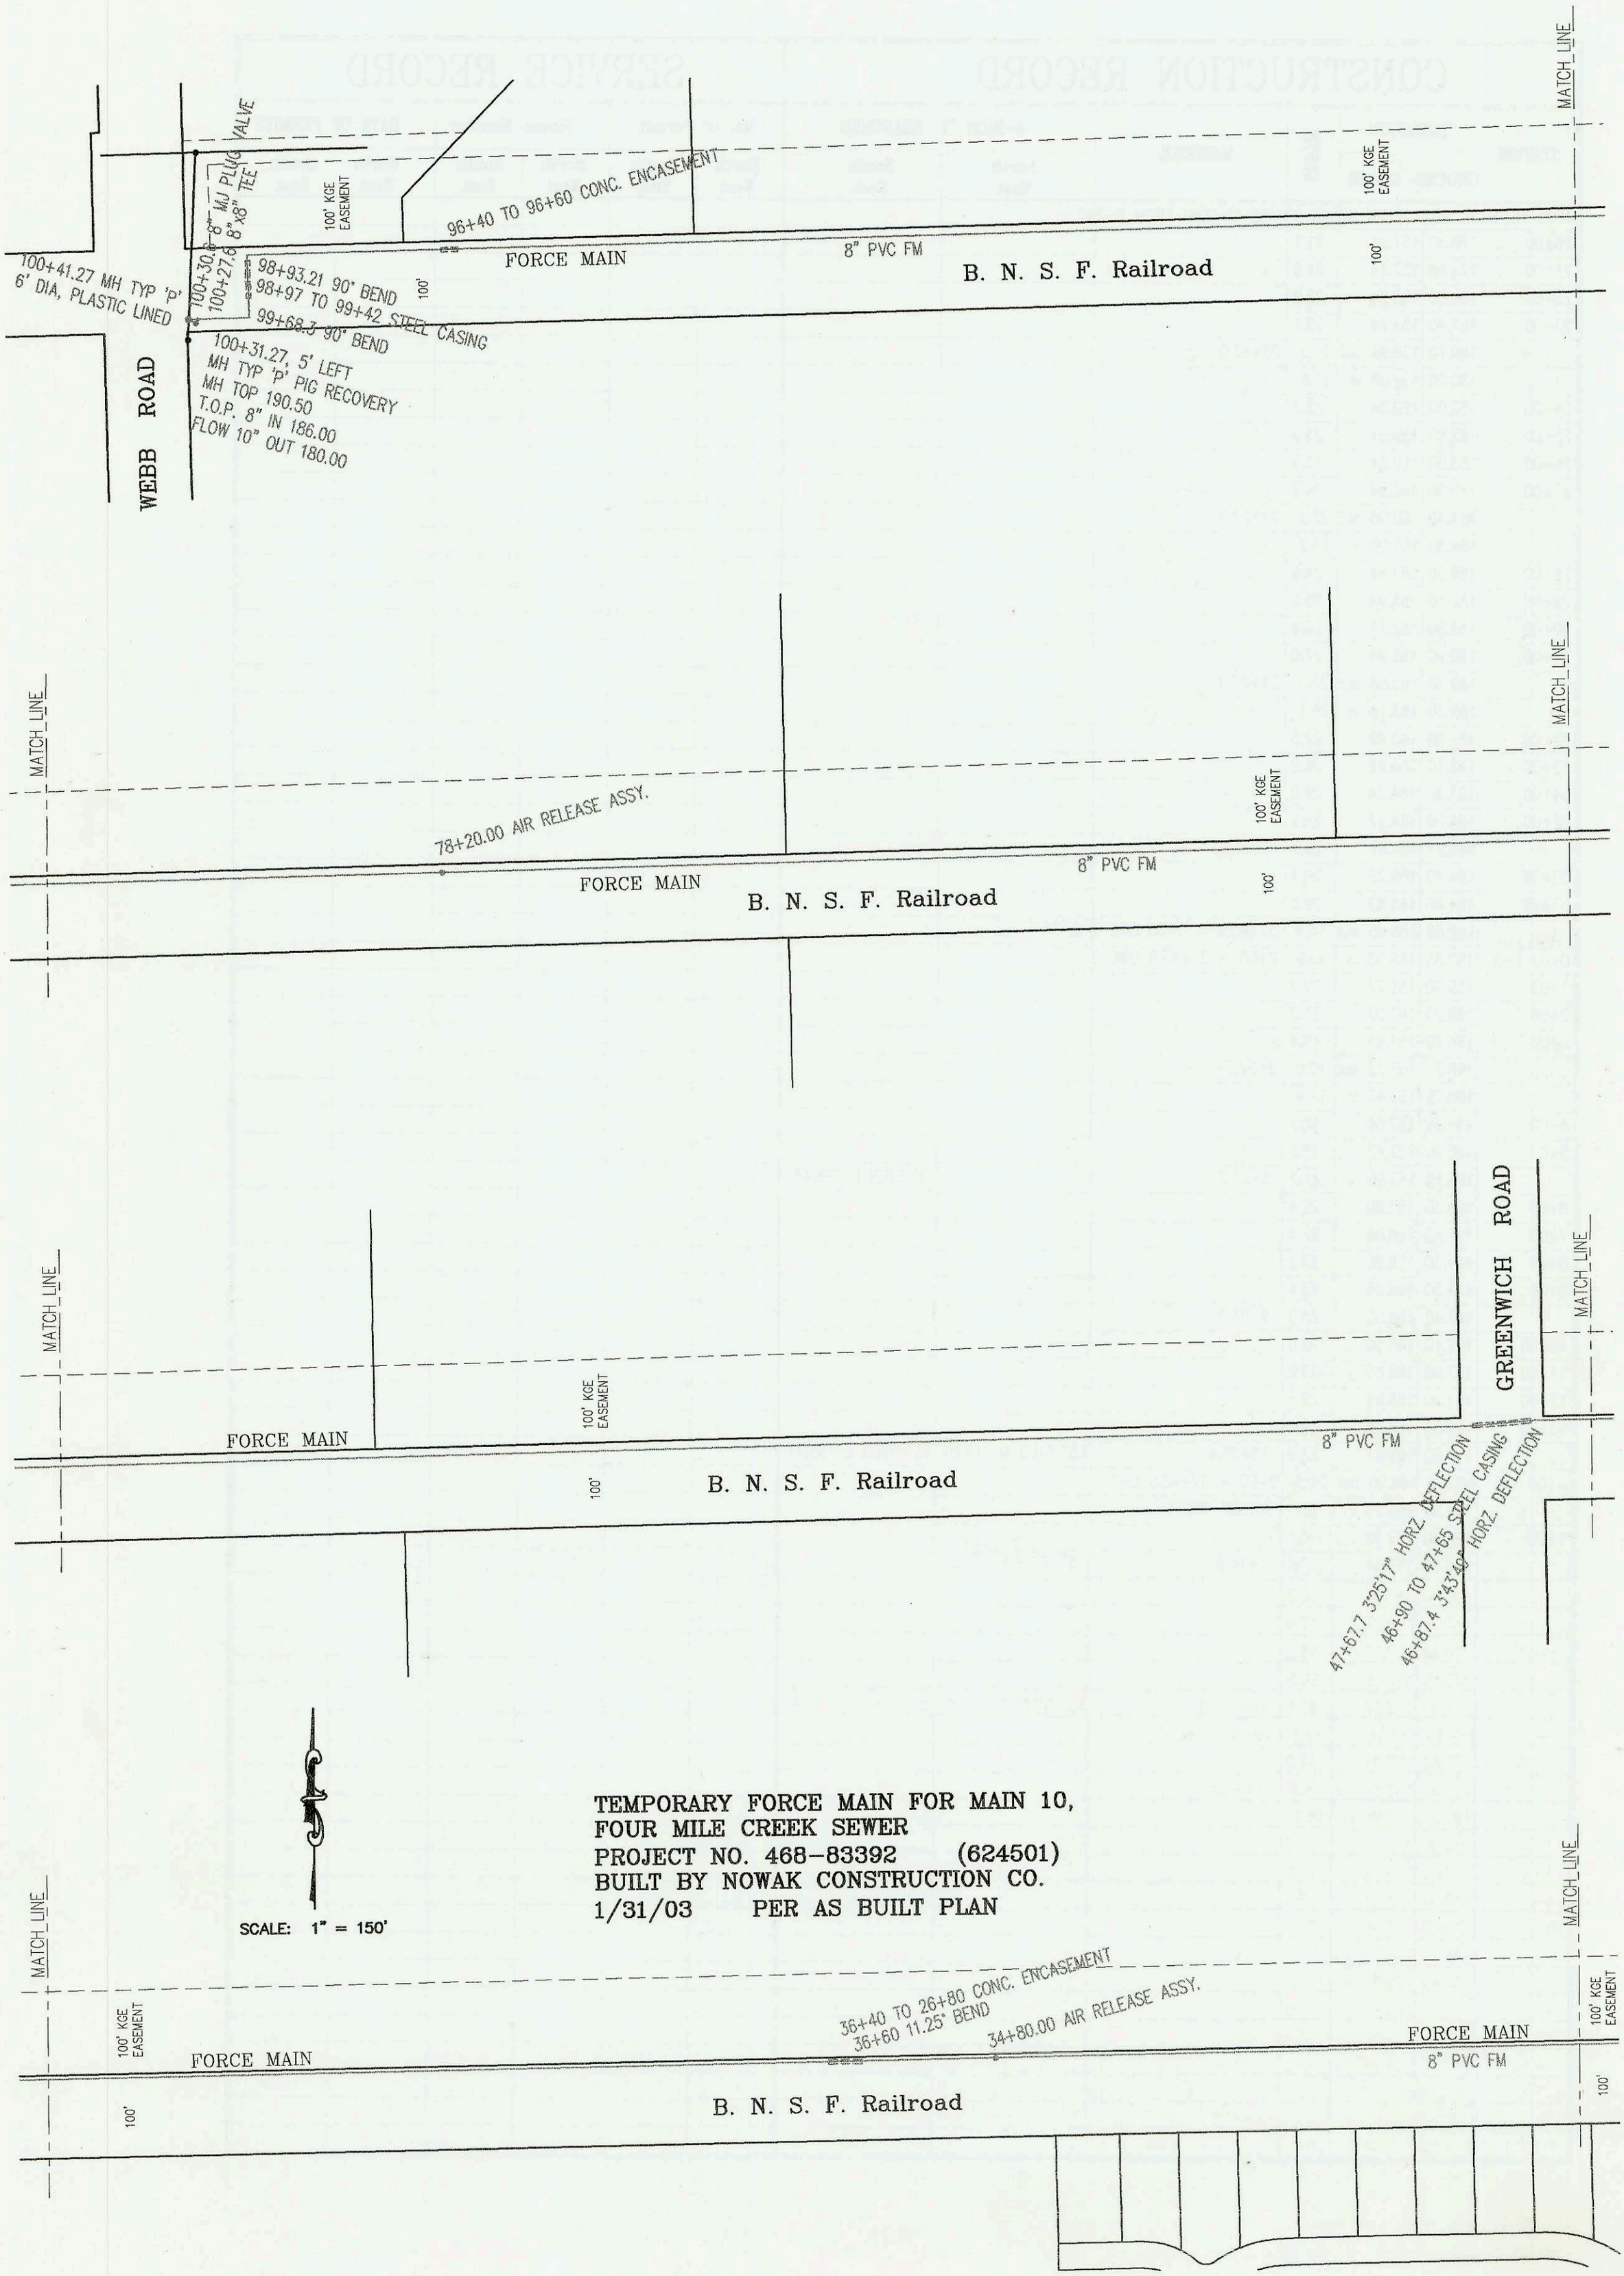

TEMPORARY FORCE MAIN FOR MAIN 10,
FOUR MILE CREEK SEWER
PROJECT NO. 468-83392 (624501)
BUILT BY NOWAK CONSTRUCTION CO.
1/31/03 PER AS BUILT PLAN

CONSTRUCTION RECORD							SERVICE RECORD					
STATION	ELEVATION		DEPTH	MANHOLE	4-INCH "Y" BRANCHES		No. of Permit		House Number		DATE OF PERMITS	
	GROUND	GRADE			North West	South East	North West	South East	North West	South East	North West	South East
TEMPORARY FORCE MAIN FOR MAIN 10, FOUR MILE CREEK SEWER												
10+27.79	169.70	165.73	4.0									
11+32.79	169.00	163.00	6.0	90d BEND								
15+49.25	156.00	150.00	6.0									
18+20.0	158.30	151.60	6.7									
20+76.0	166.40	160.30	6.1	22.5d BEND								
21+28.0	168.20	162.10	6.1	22.5d BEND								
24+48.0	174.80	166.00	8.8	22.5d BEND								
25+00.0	173.60	166.10	7.5	22.5d BEND								
34+80.0	175.40	168.00	7.4	AIR RELEASE MANHOLE								
36+60.0	164.20	159.00	5.2	11.25d BEND (vert.)								
40+80.0	167.50	163.20	4.3									
46+87.4	177.30	171.10	6.2	3d43'49" DEFLECTION								
47+67.7	177.20	172.20	5.0	3d25'17" DEFLECTION								
58+00.0	189.80	185.60	4.2									
62+80.0	195.20	190.40	4.8									
68+13.0	204.50	197.80	6.7									
74+04.22	204.90	199.10	5.8	0d1'7" DEFLECTION								
78+20.0	207.30	200.00	7.3	AIR RELEASE MANHOLE								
85+80.0	198.50	193.90	4.6									
96+40.0	183.70	178.00	5.7									
96+60.0	183.80	178.10	5.7									
97+76.2	186.90	181.50	5.4									
98+93.21	190.80	181.50	9.3	90d BEND								
99+68.3	188.30	181.50	6.8	90d BEND								
100+37.27	191.50	181.50	10.0									
100+41.27	191.50	176.80	14.7	MANHOLE								
MAIN 10, FOUR MILE CREEK SEWER (PHASE 1)												
L-1 7+83.07 L-	170.50	149.13 out	21.4	7+83.07 LINE 1								
	170.50	149.23 in	21.3									
8+00	169.60	149.25	20.4									
	168.60	149.36 out	19.2	8+93.07								
	168.60	149.46 in	19.1									
9+00	167.70	149.48	18.2									
10+00	165.00	149.69	15.3									
11+00	163.30	149.91	13.4									
12+00	163.60	150.13	13.5									
13+00	160.50	150.34	10.2									
	161.60	150.46 out	11.1	13+54.0								
	161.60	150.56 in	11.0									
14+00	159.60	150.67	8.9									
15+00	162.30	150.93	11.4									
16+00	161.40	151.17	10.2									
17+00	164.20	151.42	12.8									
18+00	166.50	151.67	14.8									
	168.10	151.71 out	16.4	18+15.73								
	168.10	151.81 in	16.3									
19+00	168.20	151.91	16.3									
20+00	169.90	152.02	17.9									
21+00	170.30	152.14	18.2									
22+00	173.10	152.25	20.9									
	175.10	152.32	22.8	22+60.53	18" STUB W 152.42	8" STUB S 159.09						
L-2 10+80.7 L-	169.40	152.34	17.1	10+80.7 LINE 2								
11+00	171.60	152.44	19.2									
	169.60	152.84 out	16.8	11+81.0								
	169.60	152.94 in	16.7									
12+00	169.60	153.04	16.6									
13+00	171.00	153.54	17.5									
14+00	172.50	154.04	18.5									
15+00	174.00	154.45	19.6									
	174.65	154.77 out	19.9	15+47.0								
	174.65	154.87 in	19.8									
16+00	175.10	155.14	20.0									
17+00	176.00	155.64	20.4									
18+00	176.70	156.14	20.6									
19+00	177.50	156.64	20.9									
	177.90	156.87 out	21.0	19+47.0								
	177.90	156.97 in	20.9									

CONT. ON P-243