

J:\PROJECTS\2019\1801010316_COW_DOUGLAS ST. BRIDGE AT BROOKSIDE_180316\CAD\SHOTS\06_CIVIL\PAV1816_TITLEDWG
 PLOTTED: Wednesday, August 21, 2019 @ 05:10PM


CONSTRUCTION PLANS FOR

DOUGLAS STREET BRIDGE AT BROOKSIDE

CITY OF WICHITA
 SEDGWICK COUNTY, KANSAS
 GARY L. JANZEN, P.E. - CITY ENGINEER
 C.O.W. PROJECT NO. 472-85436
 C.O.W. OCA NO. 715740
 C.O.W. PROJECT NO. 468-85410 (SANITARY)
 C.O.W. OCA NO. 628108 (SANITARY)


Wildcat Construction
 Completion Date:
 10-31-2020
 Engineer: Kevin Yale
 Inspector: Thom

2019-023655
 53200018
 S8010

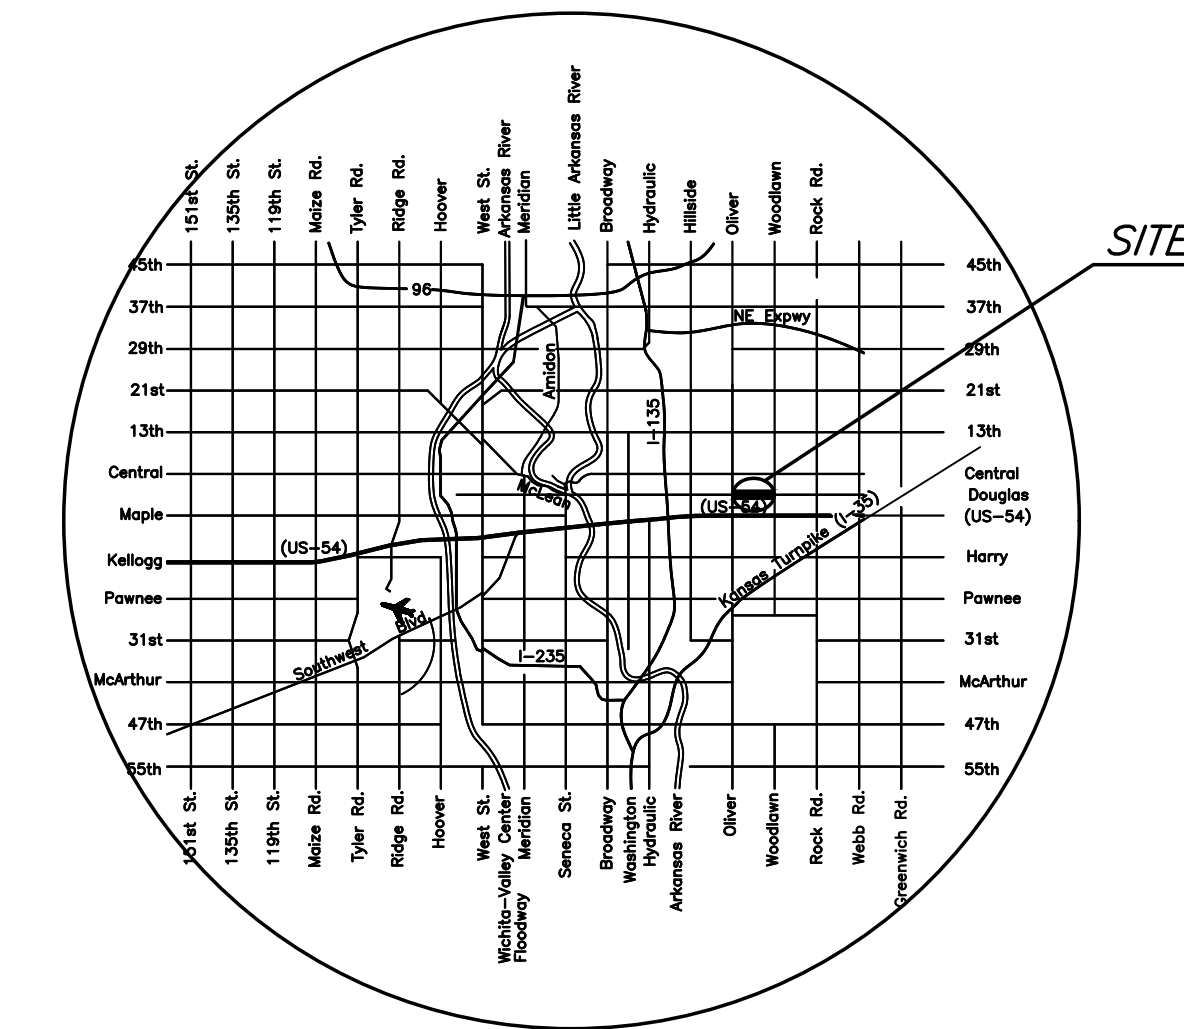

INDEX TO DRAWINGS

SHEET NO.	DESCRIPTION
1	TITLE SHEET
2	GENERAL NOTES
3	TYPICAL SECTIONS
4	PLAN AND PROFILE
5-7	PAVING DETAILS
8	STORM SEWER PLAN & PROFILE
9-13	STORM SEWER DETAILS
14	PROJECT BUBBLE MAP
15-27	BRIDGE PLAN & DETAILS
28	SUMMARY OF QUANTITIES
29-34	EROSION CONTROL PLAN & DETAILS
35	ROADSIDE IMPROVEMENTS PLAN & DETAILS
36	PAVEMENT MARKING & SIGNING PLANS & DETAILS
37	CONSTRUCTION SEQUENCE SUMMARY
38-48	TRAFFIC CONTROL PLAN & DETAILS
49	DRAINAGE MAP
50-51	CROSS SECTIONS

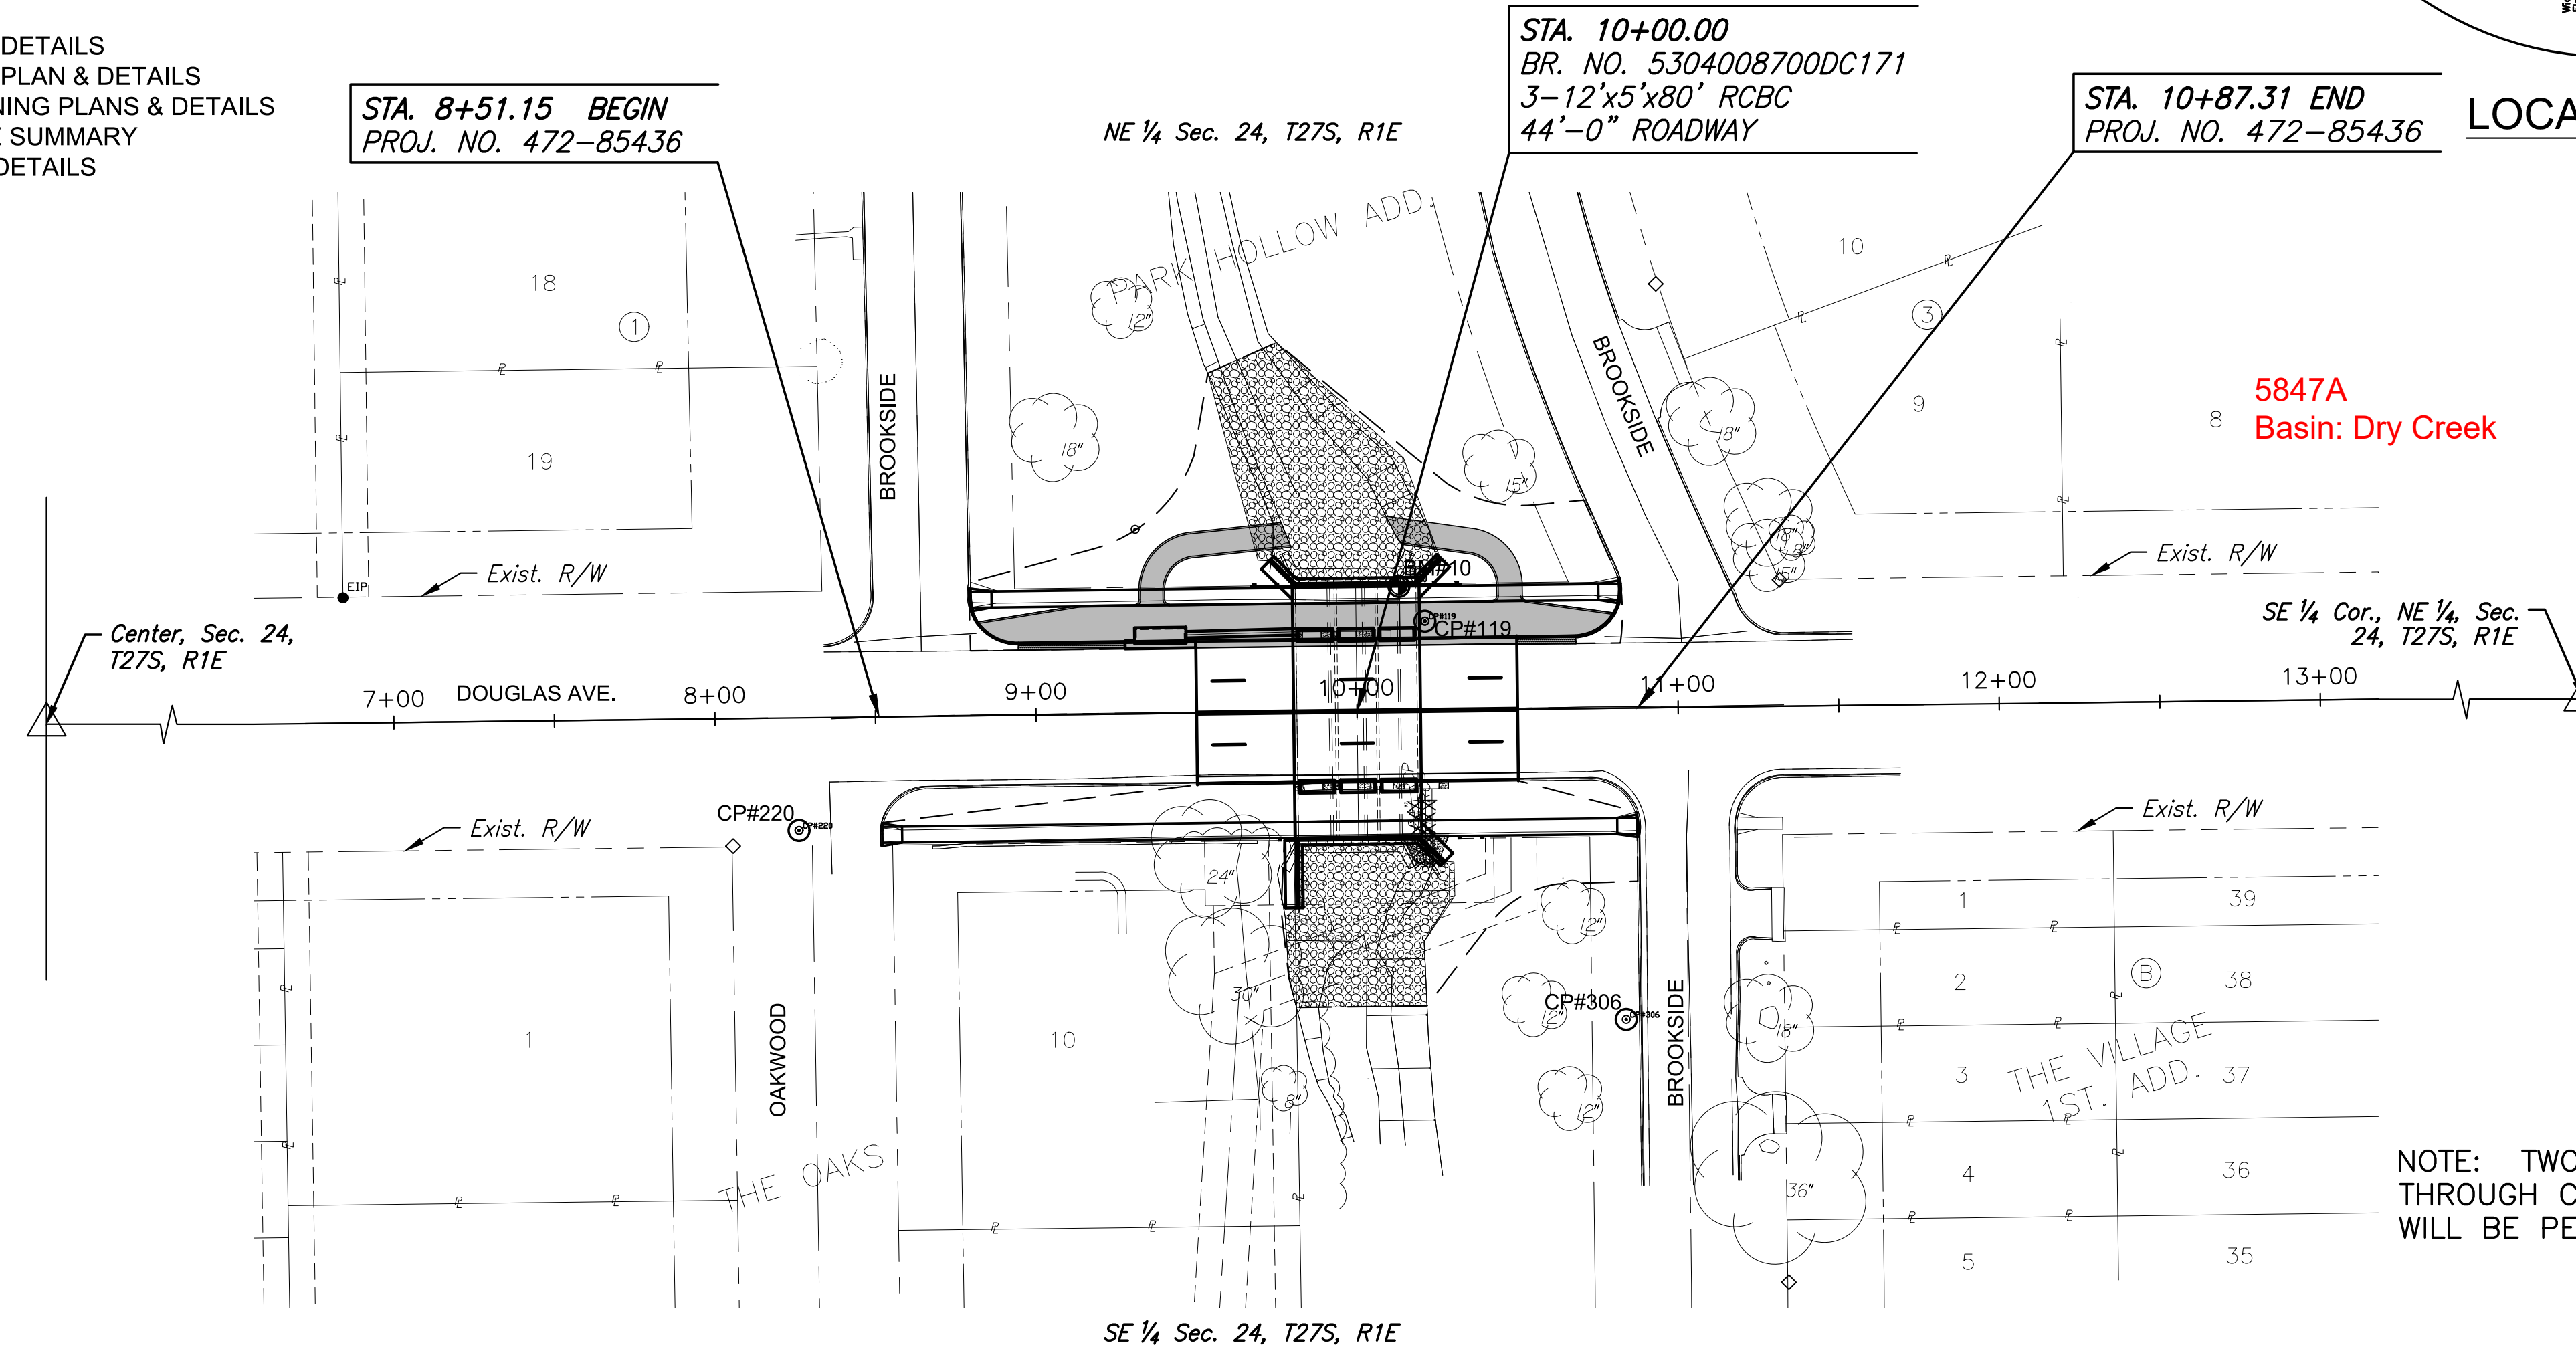

BENCHMARKS & CONTROL POINTS

BM
 SQR CUT
 ELEV.=1357.63 NAVD 88
 N=1687547.1, E=1668902.4

BM #10
 C.O.W. BRASS DISK
 ELEV.=1353.87 NAVD 88
 N=1686268.5, E=1668573.8

CP #119
 CP / #5 EIBC MKEC
 ELEV.=1353.64 NAVD 88
 N=1686257.58, E=1668581.87

CP #220
 CP / CST NL FND IN ASPH
 ELEV.=1353.85 NAVD 88
 N=1686192.39, E=1668386.96

CP #304
 CP / IBSC #304
 ELEV.=1352.28 NAVD 88
 N=1686501.39, E=1668531.64

CP #306
 CP / IBSC #306
 ELEV.=1352.65 NAVD 88
 N=1686133.55, E=1668644.58

NOTE: TWO WAY TRAFFIC TO BE CARRIED THROUGH CONSTRUCTION. LOCAL TRAFFIC WILL BE PERMITTED TO ADJACENT PROPERTIES.



CONSTRUCTION PLANS FOR

DOUGLAS STREET BRIDGE AT BROOKSIDE

WICHITA, KS



©2019
 MKEC Engineering
 All Rights Reserved
 www.mkec.com
 These drawings and their contents, including, but not limited to, all concepts, designs, & ideas are the exclusive property of MKEC Engineering (MKEC), and may not be used or reproduced in any way without the express consent of MKEC.

TITLE SHEET

PROJECT NO.	472-85436	
DATE	JULY 2019	
SCALE	1"=40'	
DESIGNED	JRA	
DRAWN	BKS	
CHECKED	JRA	
NO.	REVISION	DATE

SHEET NO.
 1 OF 51

MANHOLE REHABILITATION:
The sanitary sewer manhole at Sta. 10+33.01, 33.19' Lt., is a 4' diameter precast concrete manhole approximately 10.9' deep. The contractor shall rehabilitate the existing manhole as follows:


1. Clean the manhole and remove debris and corrosion build-up from the manhole.
2. Eliminate water infiltration entering the manhole around the 8" pipe via drilling and injecting a grout product specifically designed for this application. The injection grout shall be applied all the way around the manhole and should seal around the lowest wall joint and around all pipe openings in the wall.
3. Apply an approved manhole lining system.

Approved manhole lining systems:

- Raven 405
- Sauereisen 210S
- Spectrashield
- Warren Environmental S301
- Zebtron
- Sherwin-Williams Dura-Plate 6100
- Sherwin-Williams Sherflex


All lining materials shall be applied per manufacturer's specification and recommended thickness for brick or precast manholes. Cleaning, filling of voids, removal of steps flush with the interior manhole surface, and other preparations to the manhole walls shall be included in the bid item for the lining. Mortar used to patch gaps in brick walls shall conform to City Standard Specifications.

After each rehabilitation step, the contractor shall obtain engineer approval before continuing to the next step. The contractor shall furnish all material, labor, equipment, dewatering, manhole cleaning and preparation, bypass pumping or other method of flow control and testing. All work will be paid for as "MH, Rehabilitated".

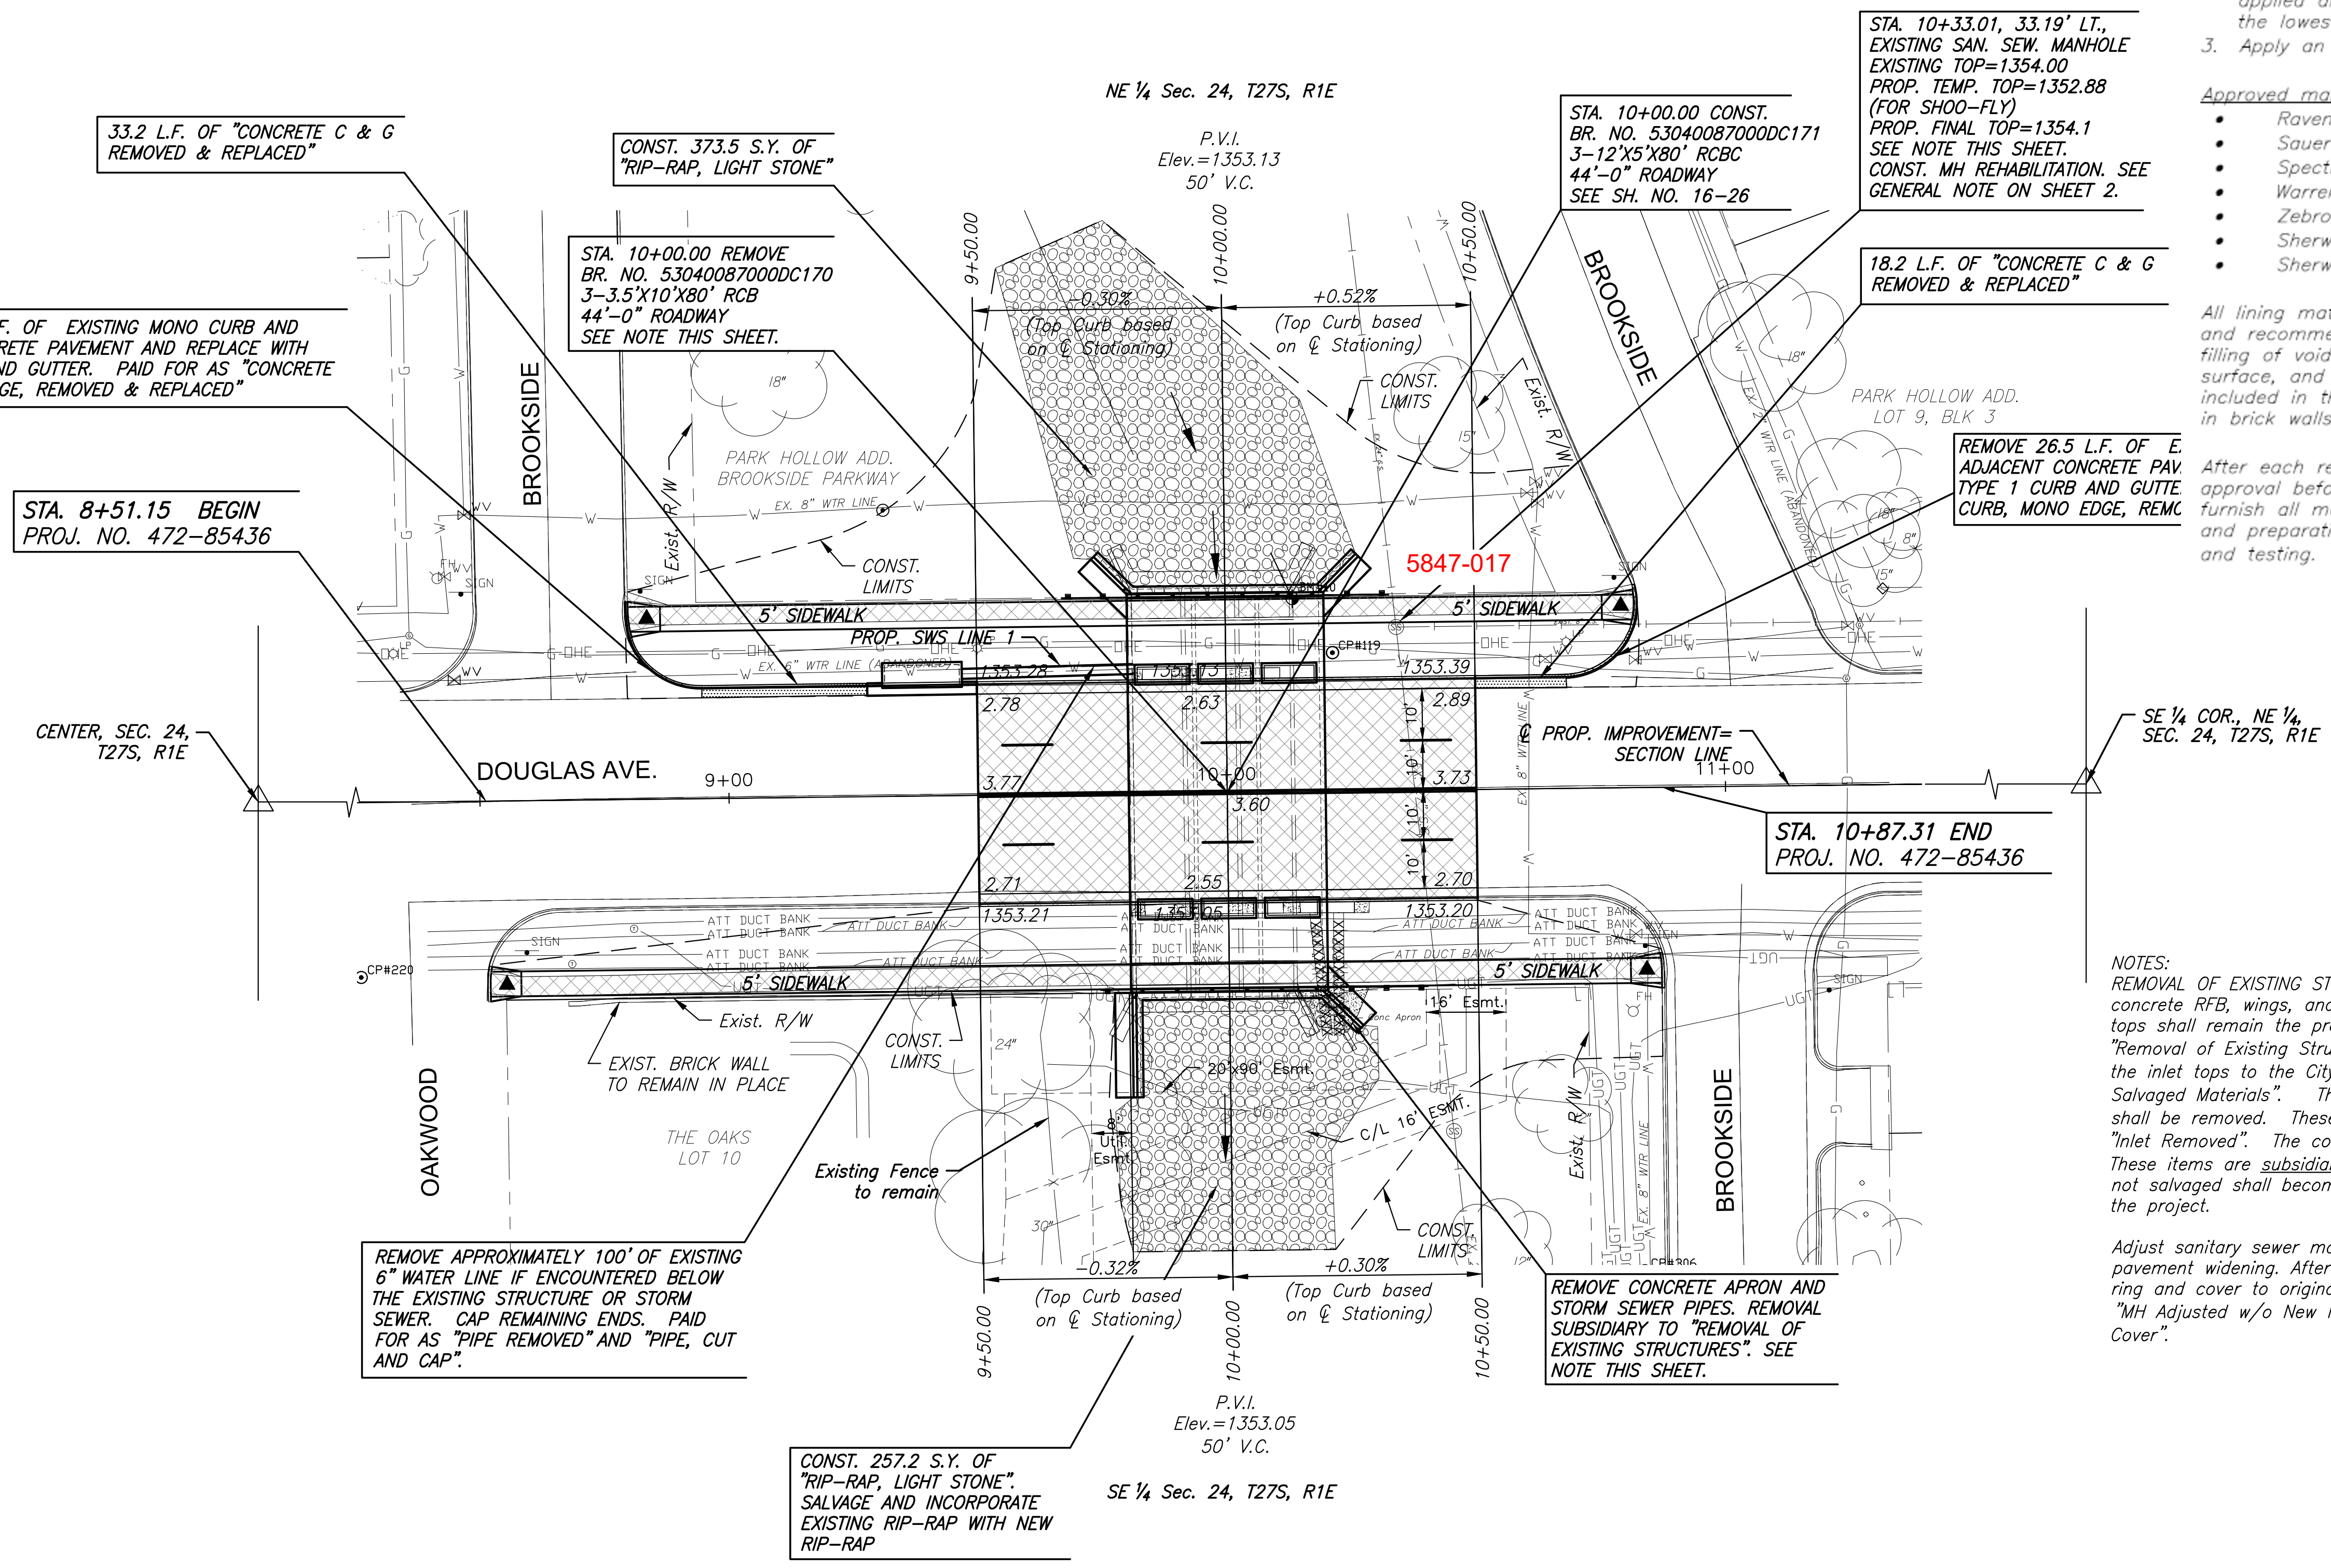

NOTES:
REMOVAL OF EXISTING STRUCTURE: The contractor shall remove the existing concrete RFB, wings, and storm inlets on the RFB. The existing metal inlet tops shall remain the property of the City. This work shall be subsidiary to "Removal of Existing Structures". The contractor is responsible for delivering the inlet tops to the City which will be paid for as "Transportation of Salvaged Materials". The storm sewer and inlet not connected to the RFB shall be removed. These items shall be paid for as "Pipe Removed" and "Inlet Removed". The concrete apron and brick wing wall shall be removed. These items are subsidiary to "Removal of Existing Structures". All materials not salvaged shall become the property of the contractor and removed from the project.

Adjust sanitary sewer manhole ring and cover to accommodate temporary pavement widening. After removal of the temporary pavement, adjust manhole ring and cover to original grade using a new ring and cover. Paid for as "MH Adjusted w/o New Ring & Cover" And "MH Adjusted w/ New Ring & Cover".

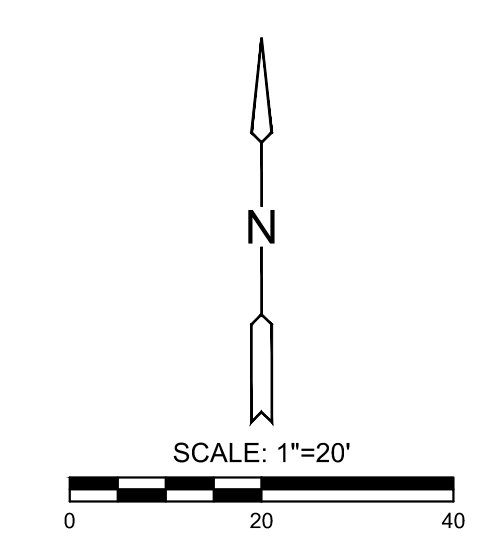

LEGEND

	PAVEMENT AND SIDEWALK REMOVAL
	DIRECTION OF STREAM FLOW
	BUBBLE POINT
	CONSTRUCT WHEELCHAIR RAMP (5')

DOUGLAS STREET BRIDGE AT BROOKSIDE
 WICHITA, KS
 CONSTRUCT 11' HIGH FLAINS CURB

©2019 MKEC Engineering All Rights Reserved www.mkec.com
These drawings and their contents, including, but not limited to, all concepts, designs, & ideas are the exclusive property of MKEC Engineering (MKEC), and may not be used or reproduced in any way without the express consent of MKEC.

PLAN AND PROFILE	
PROJECT NO.	472-85436
DATE	JULY 2019
SCALE	1"=20'
DESIGNED	DRAWN
JRA	BKS
CHECKED	JRA
NO.	REVISION
SHEET NO.	
4 OF 51	