PRIOR TO BEGINNING CONSTRUCTION, THE CONTRACTOR SHALL EXCAVATE THE EXISTING 16" WATERLINE AT STATION 0+00.00 TO VERIFY PIPE SIZE, TYPE, FITTINGS, AND HORIZONTAL AND VERTICAL LOCATION. THE CONTRACTOR SHALL REPORT HIS FINDINGS TO THE ENGINEER SO THAT ANY NECESSARY PLAN MODIFICATIONS CAN BE MADE.

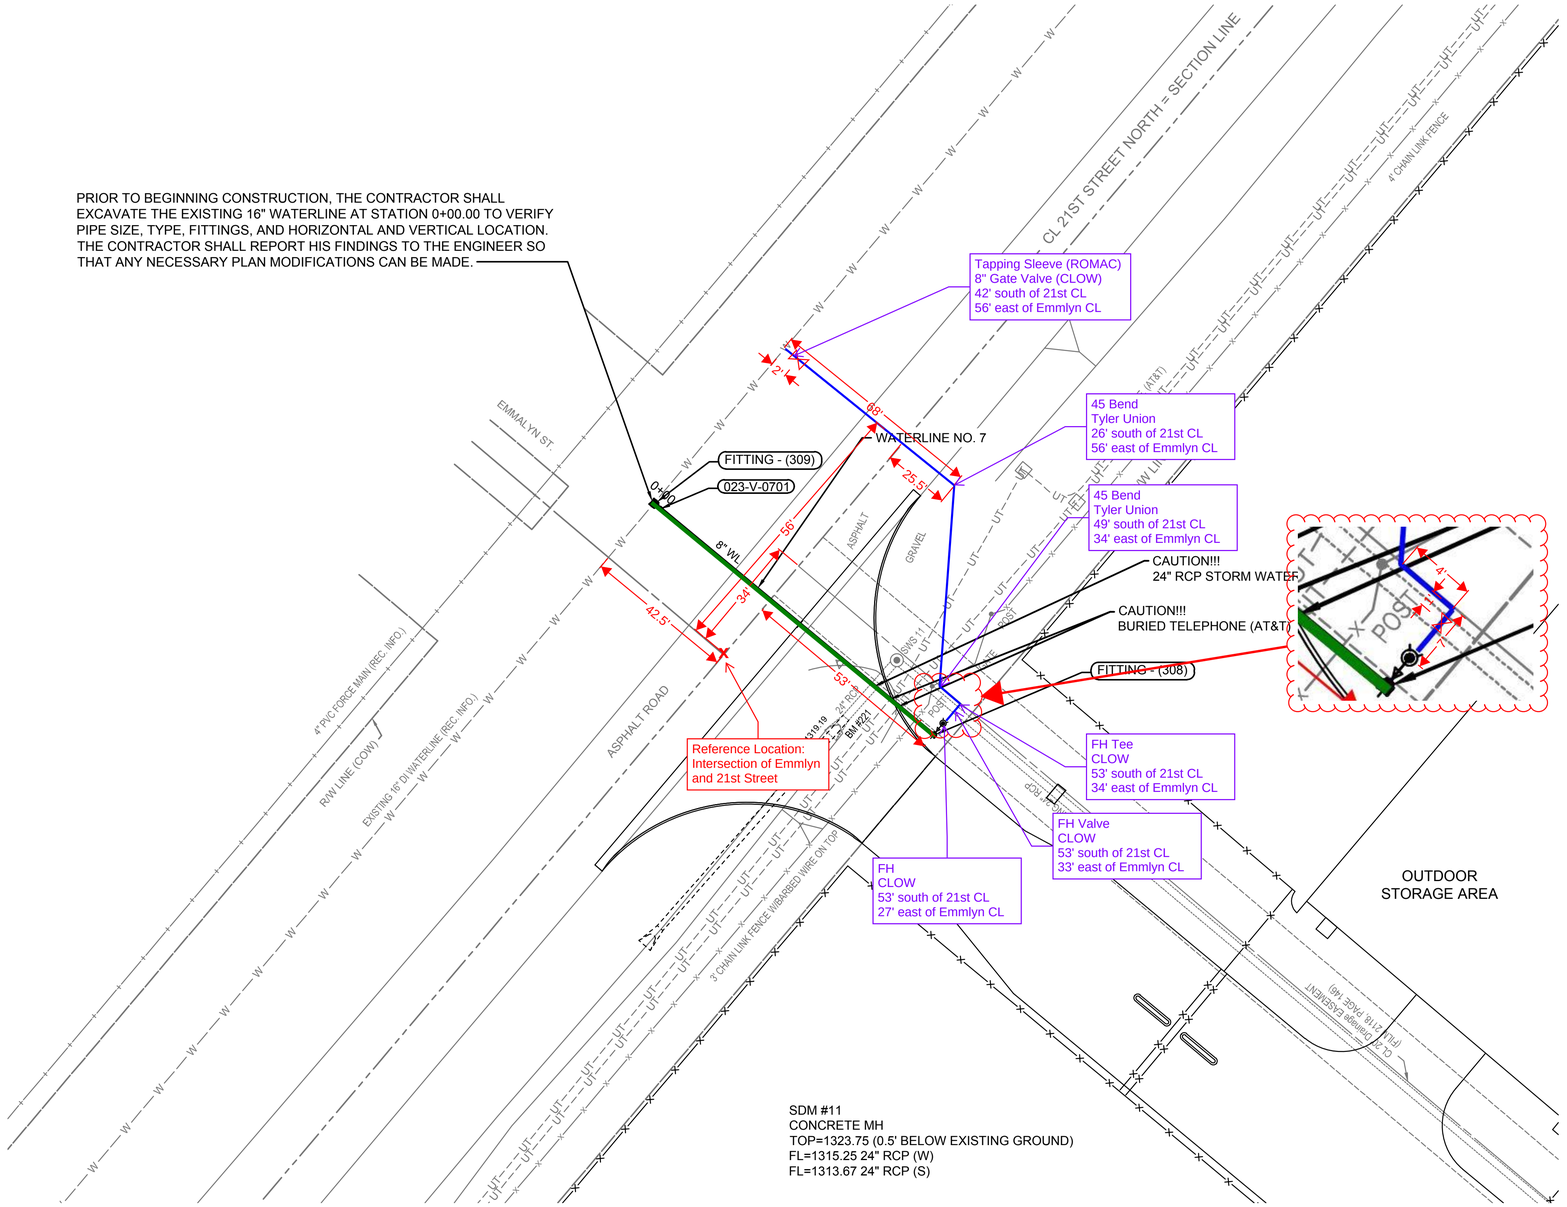

FITTING TABLE				
ID	STATION	NORTHING	EASTING	DESCRIPTION
Fitting - (308)	0+95.8 WL 7	1,698,908.0091	1,630,128.7386	FH ASSEMBLY
Fitting - (309)	0+00.0 WL 7	1,699,003.8173	1,630,127.6829	16" X 8" TAPPING SLEEVE

APPURTENANCE TABLE				
ID	STATION	NORTHING	EASTING	DESCRIPTION
023-V-0701	0+02.3 WL 7	1,699,001.5752	1,630,127.6986	8" GATE VALVE

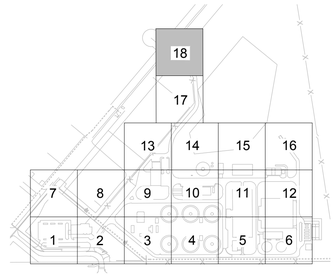

KEY MAP

NORTH

0 10' 20' 40'
SCALE IN FEET

TREVOR KAUFMAN
LICENSED
KANSAS
PROFESSIONAL ENGINEER
11/05/2021

no.	date	by	ckd	description
0	11/12/21	CSL	TBK	PACKAGE 4: ISSUED FOR CONSTRUCTION

wichita WATER PARTNERS

PEC
PROFESSIONAL ENGINEERING CONSULTANTS, P.A.
303 SOUTH TOPEKA WICHITA, KS 67202
316-262-2691 www.pec1.com
LICENSE NO. E-310

date	detailed
APRIL 6, 2020	C. LINK
designed	checked
T. KAUFMAN	R. GLESSNER

CITY OF WICHITA
SEDGWICK COUNTY, KANSAS

NORTHWEST WATER TREATMENT FACILITY
SITE - CIVIL
WATERLINE AREA 18

project	contract
114461	
drawing	rev.
048C418 –	0
sheet	of sheets
file	171350-009-048C418.dwg

U:\WICHITA-CIVIL\2017\171350\009\PEC\DRAWINGS\171350-009-048C418.DWG 10/25/2021 3:23 PM CATHY.LINK