

4MC-091

PLANS

SANITARY SEWER SYSTEM

CRESTVIEW COUNTRY CLUB ESTATES

EAST MEADOWS ADDITION


REISS AND GOODNESS ENGINEERS

2160 E DOUGLAS WICHITA - KANSAS


1970



4MC-091






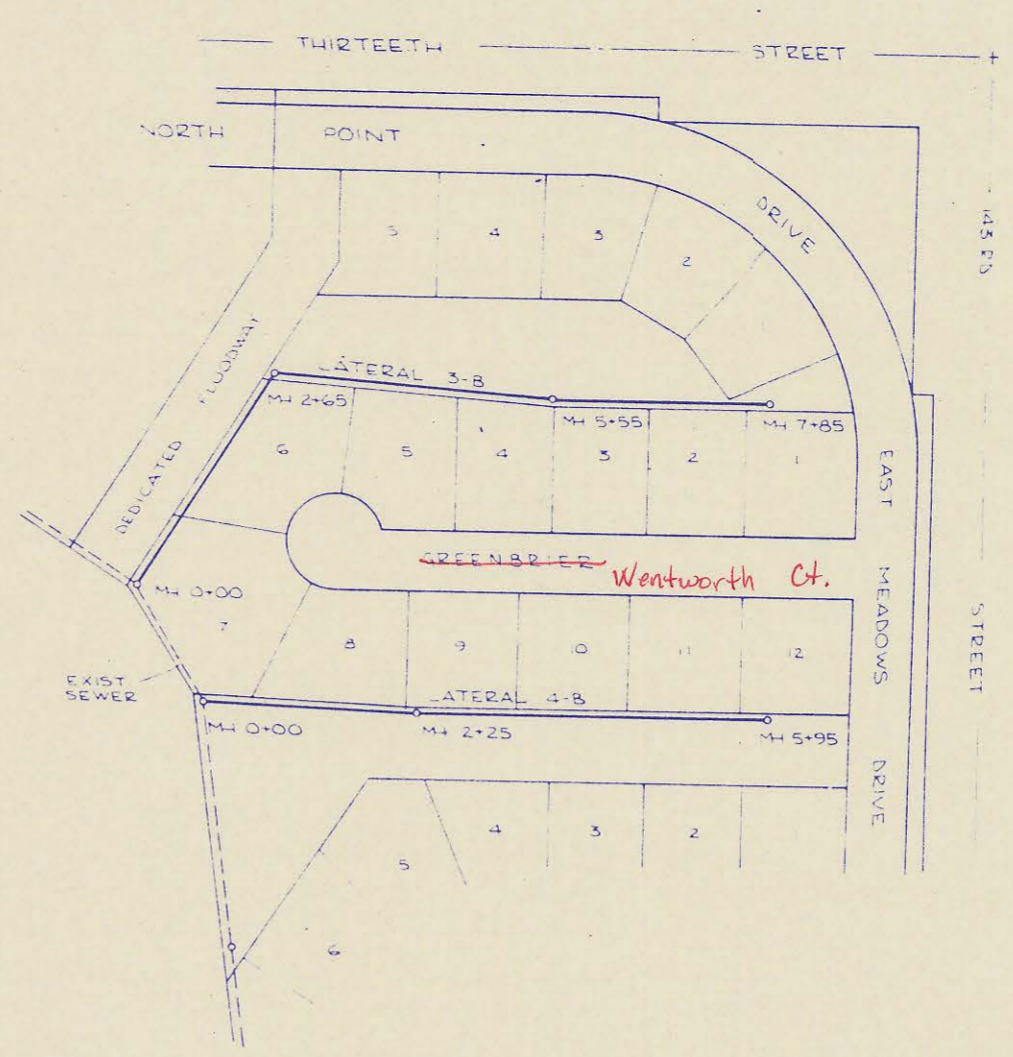


NORTH  
 SCALE PLAN 1"=100'  
 PROFILE HORIZ 1"=50'  
 VERT 1"=4'

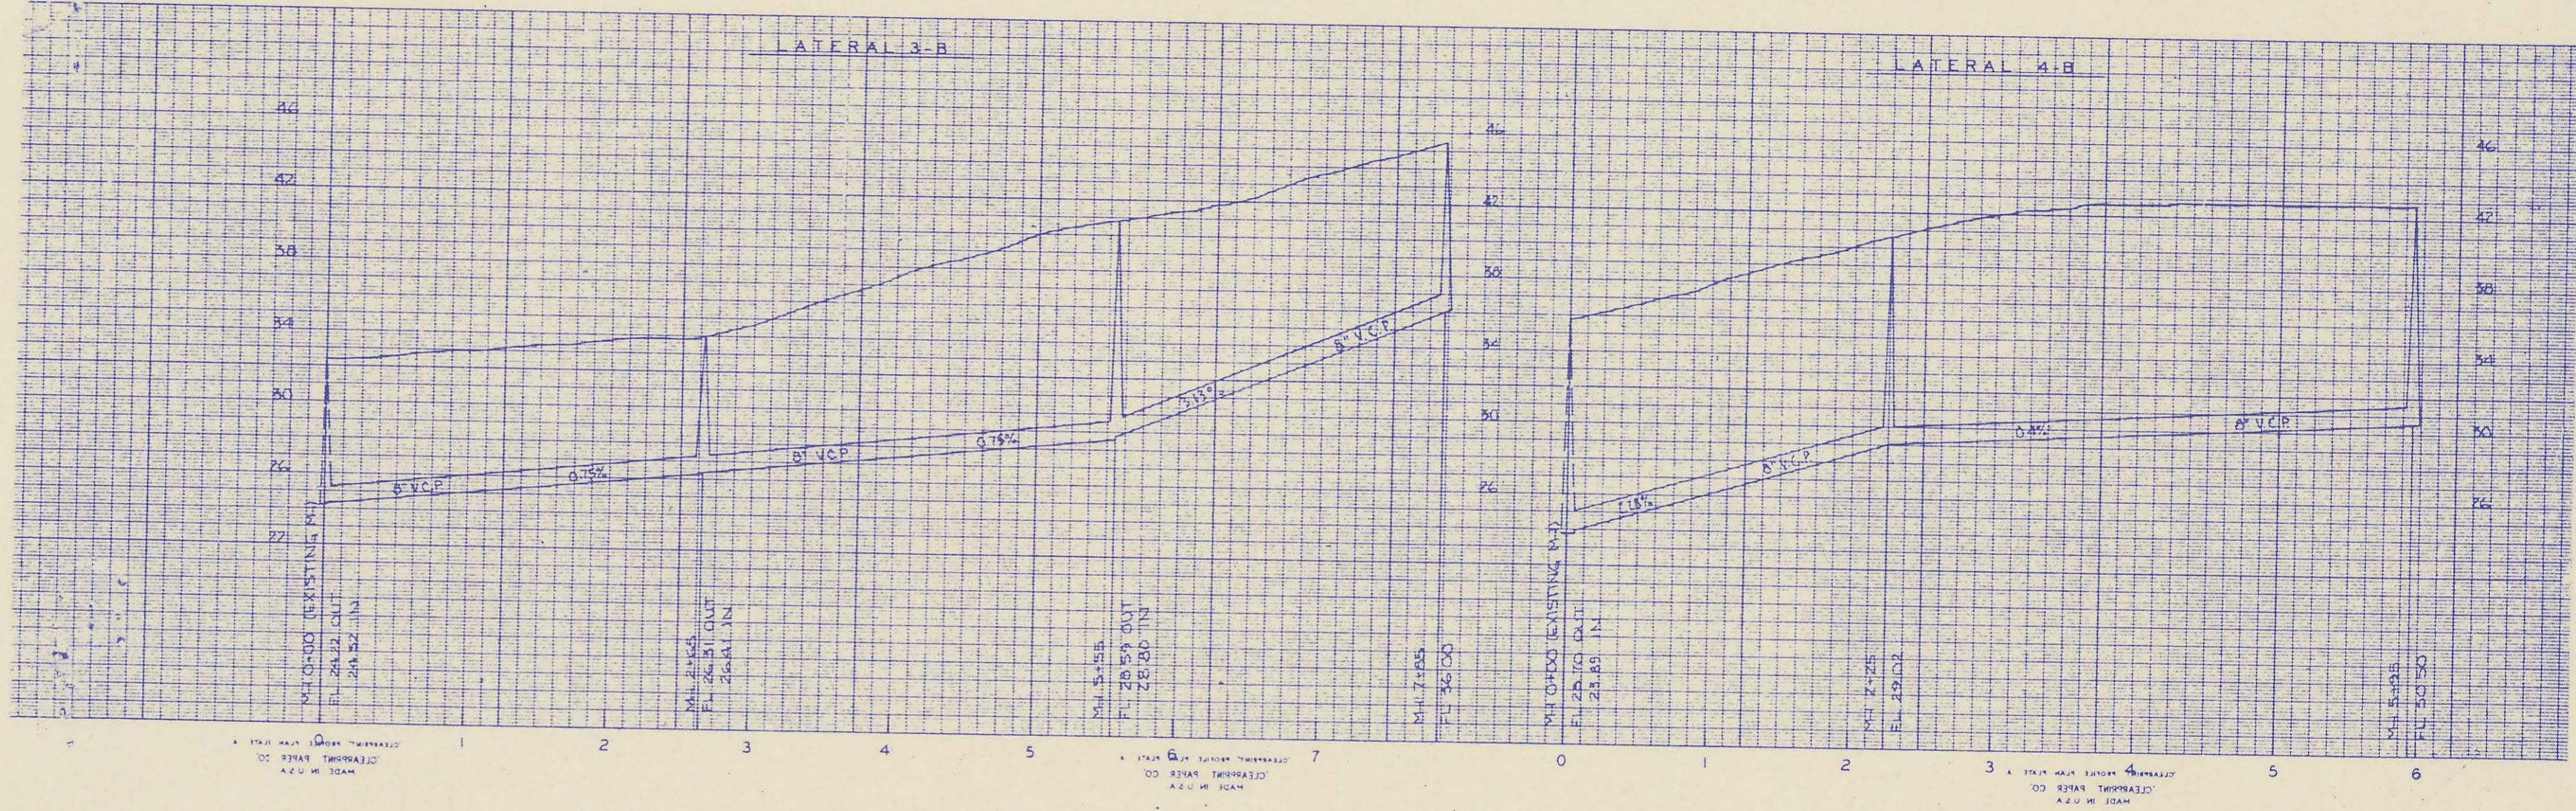

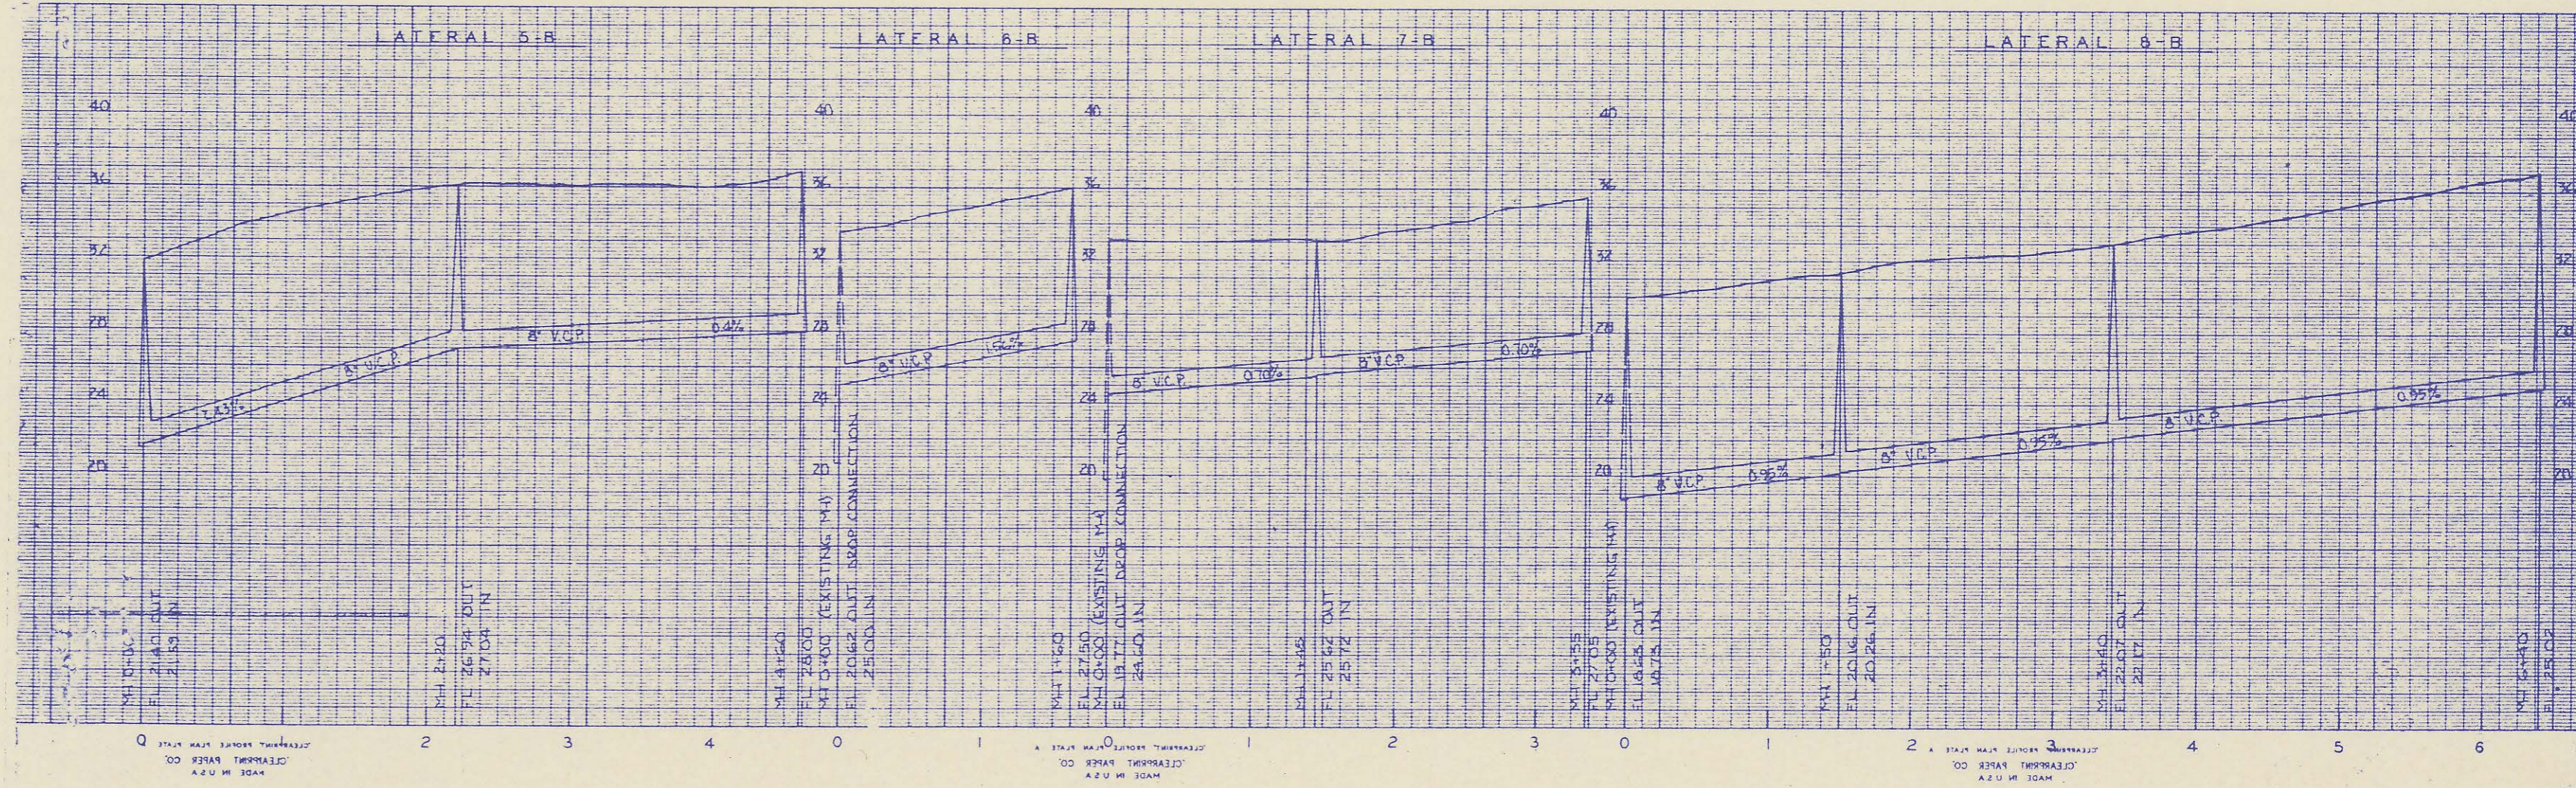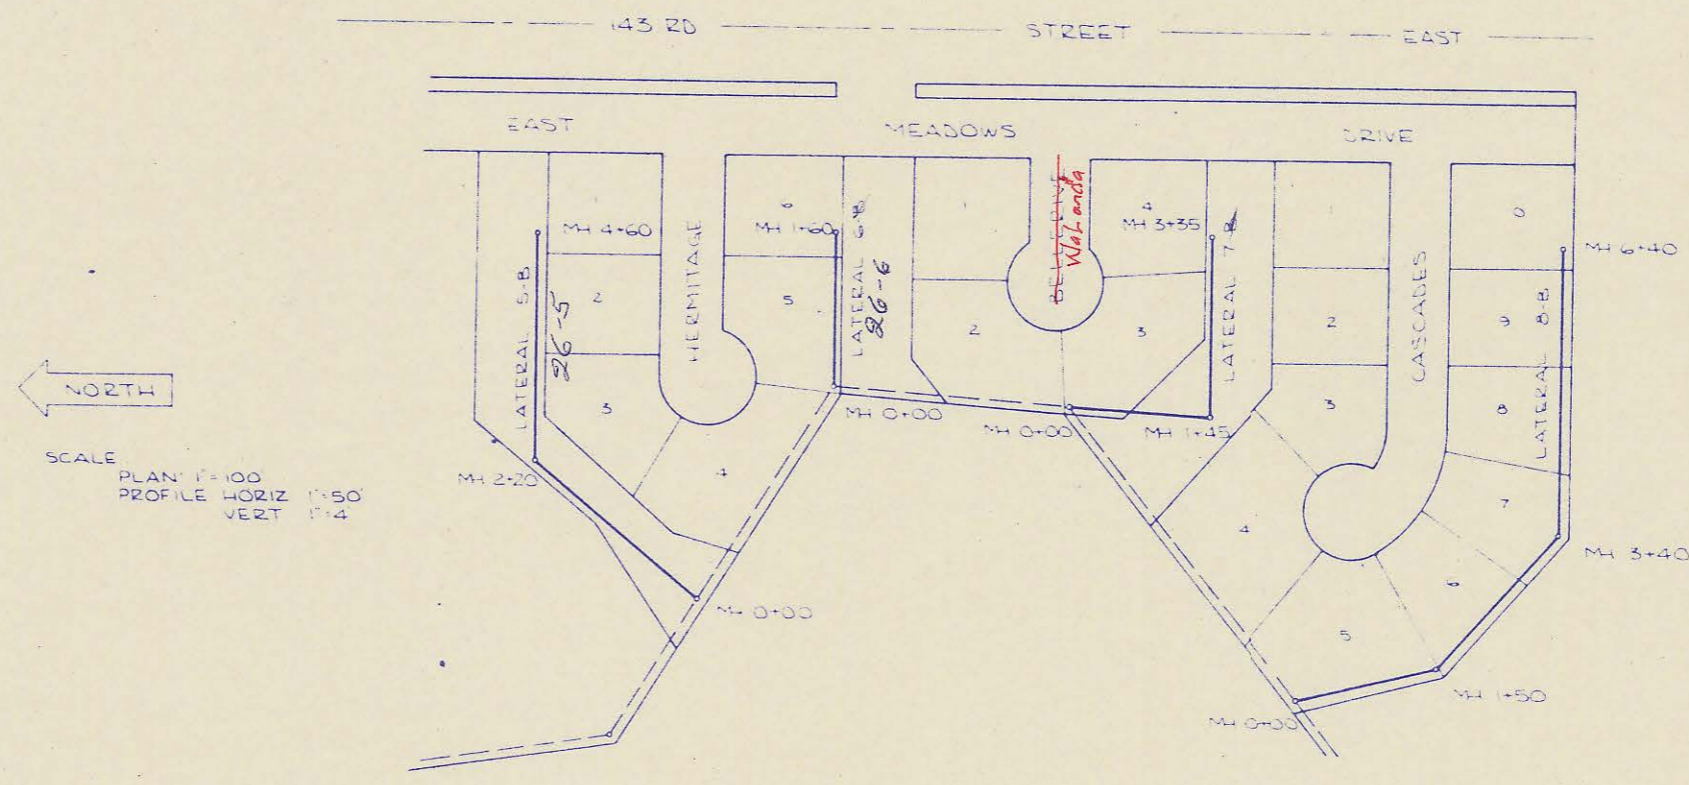

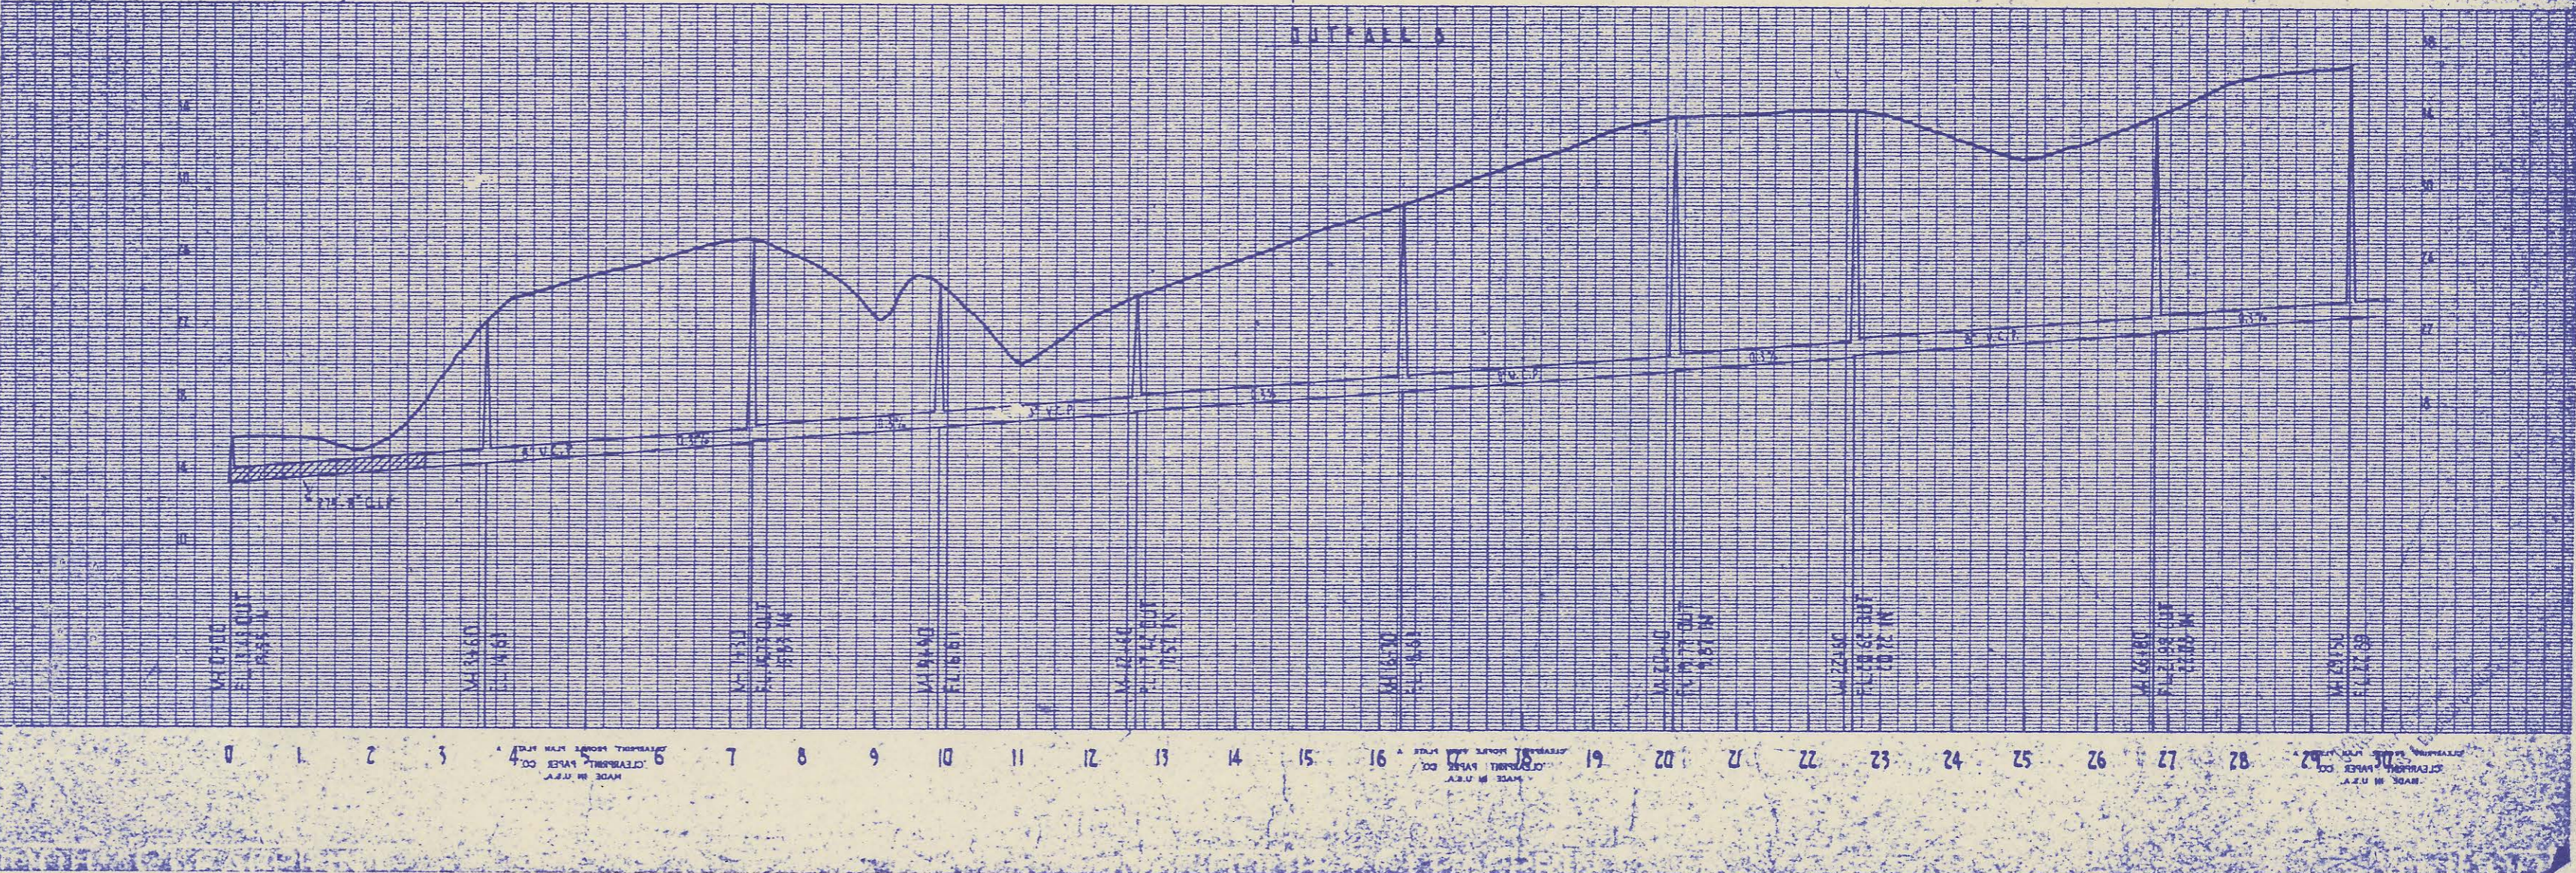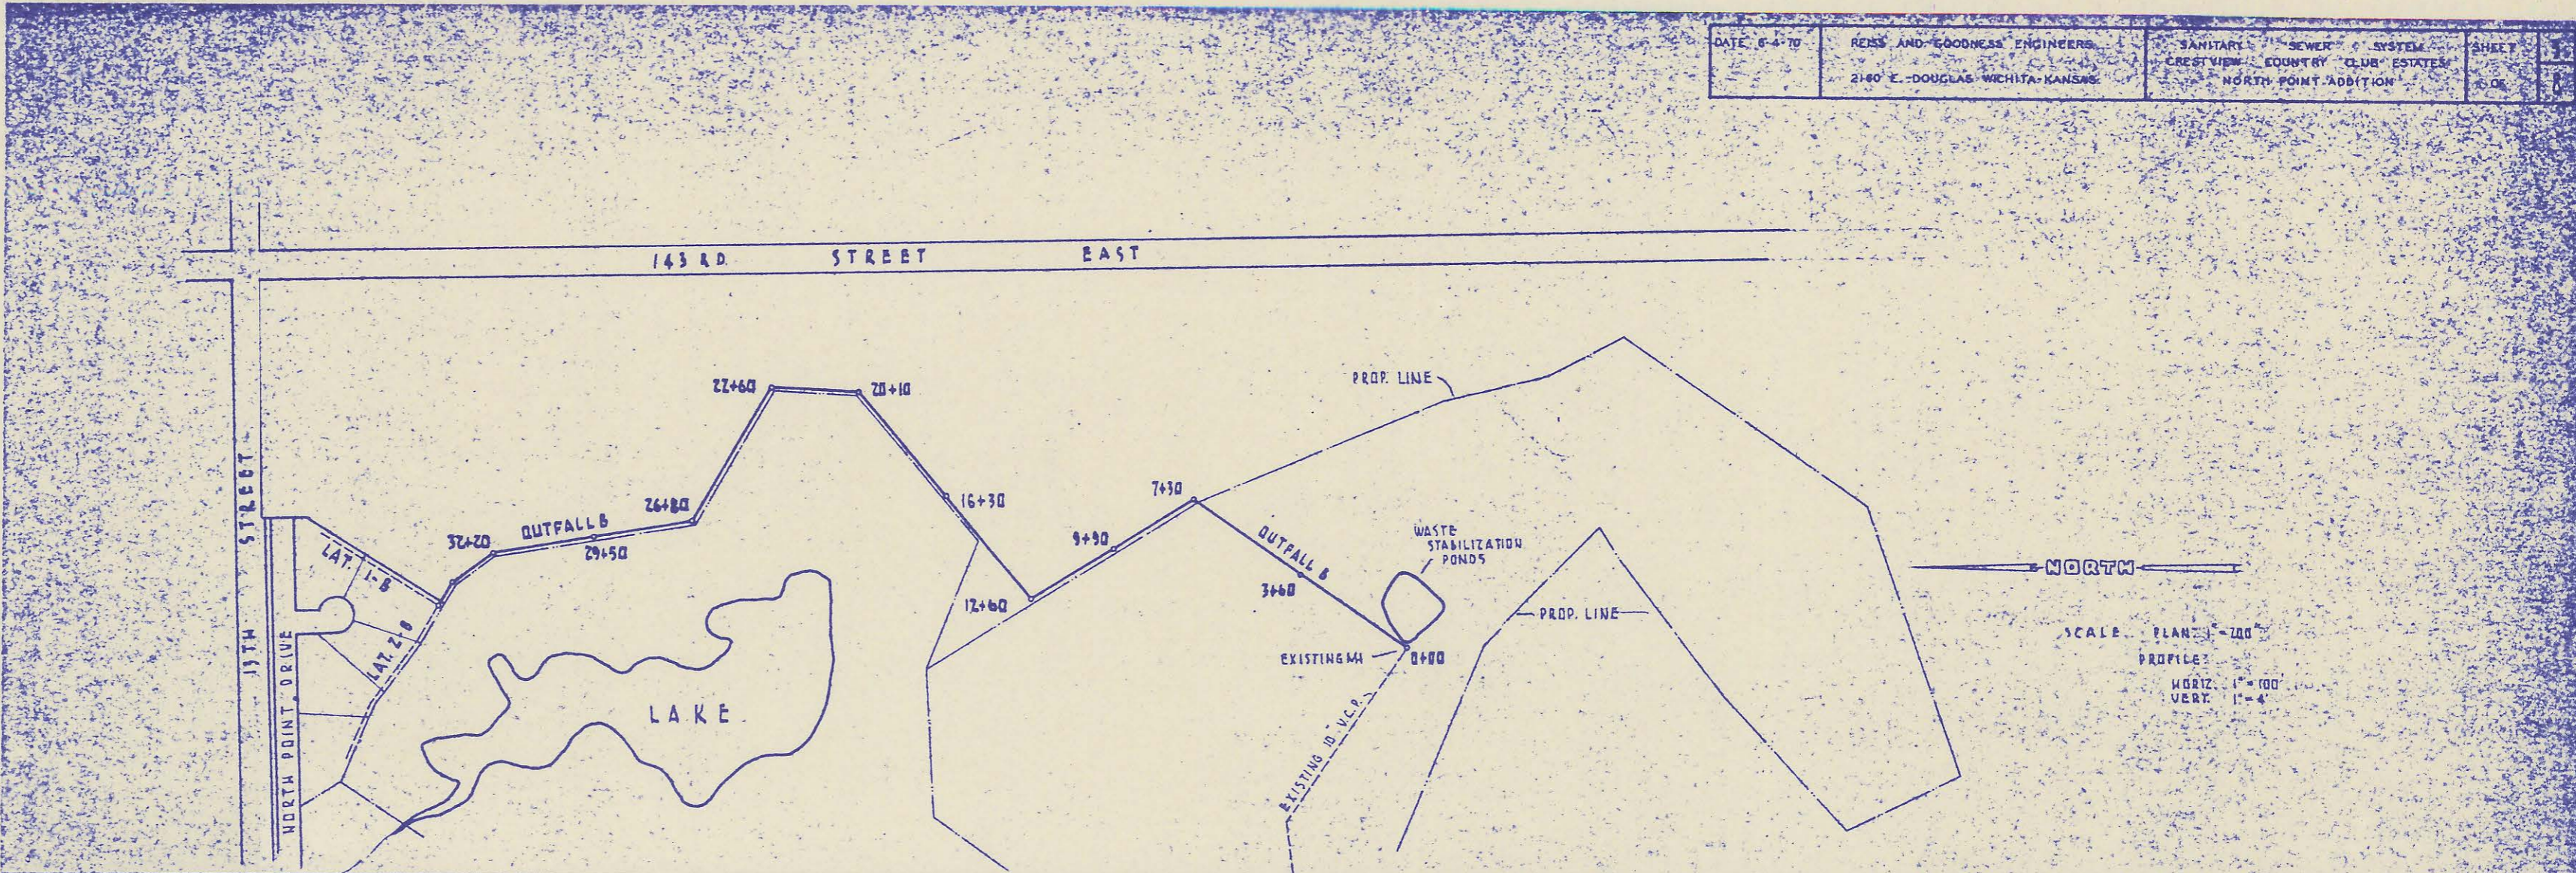

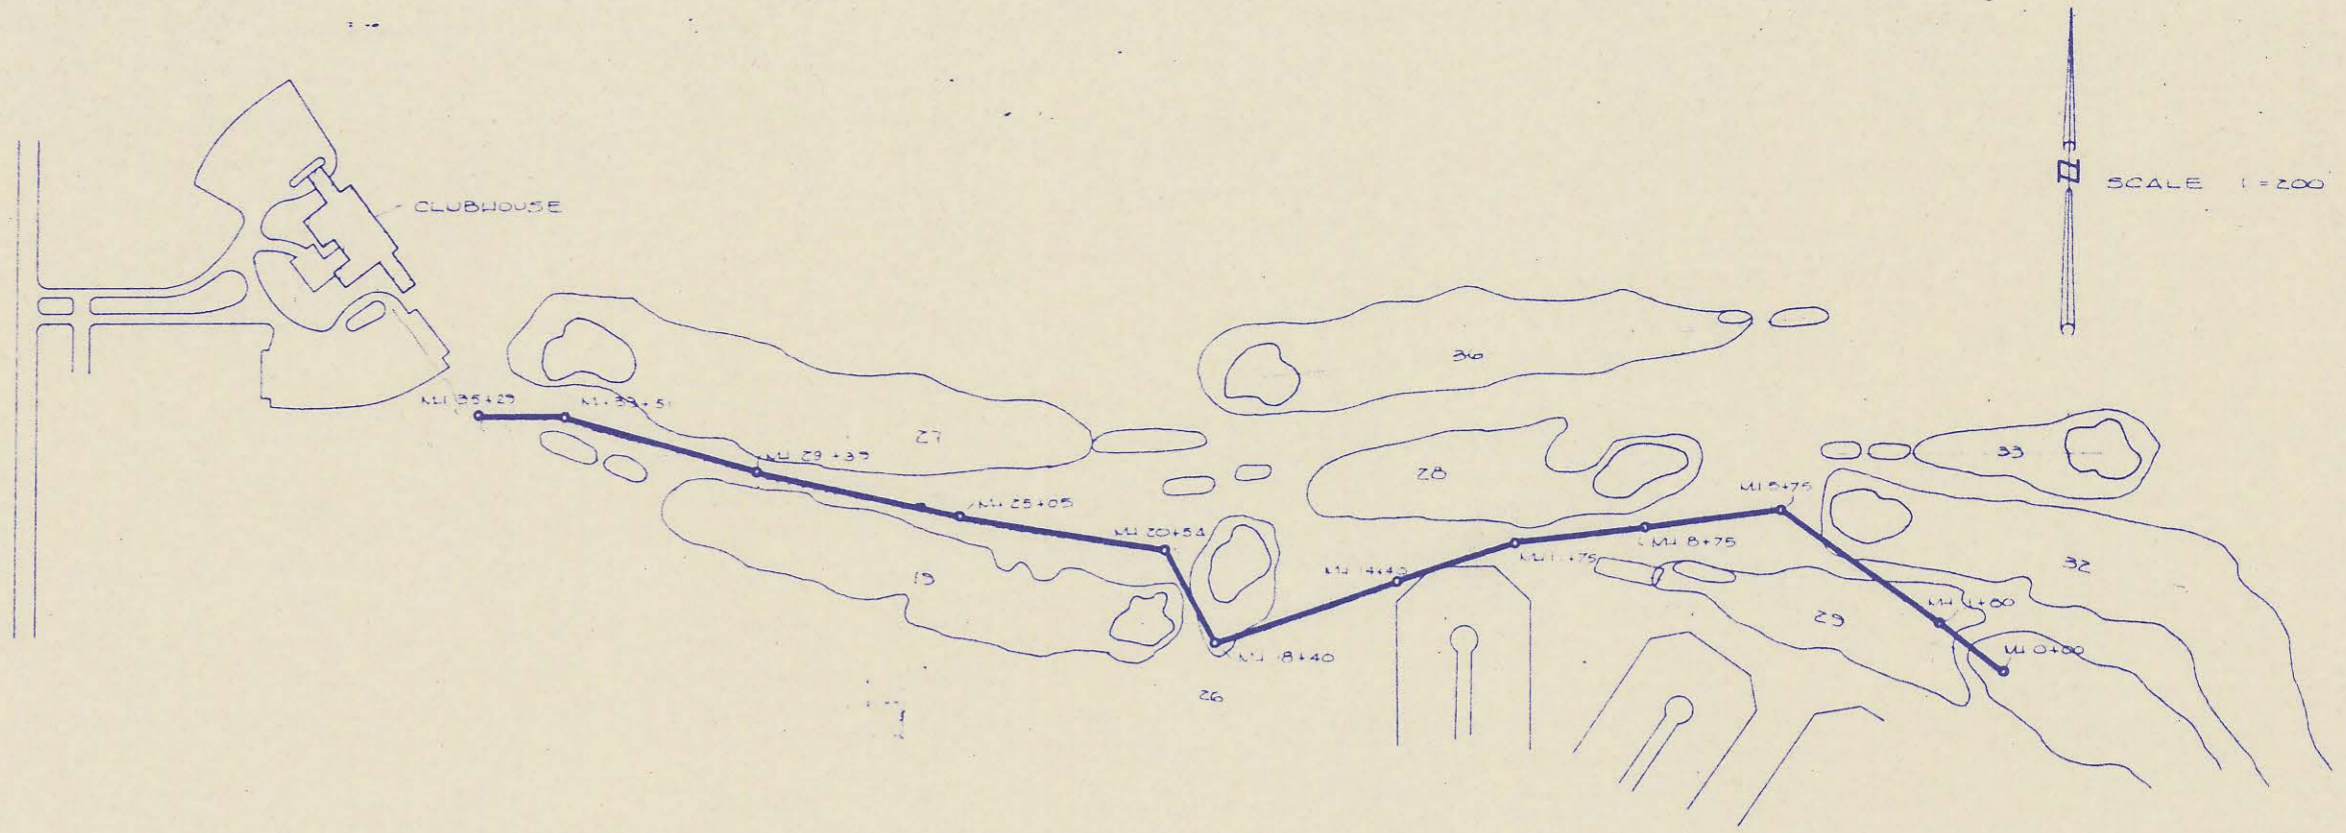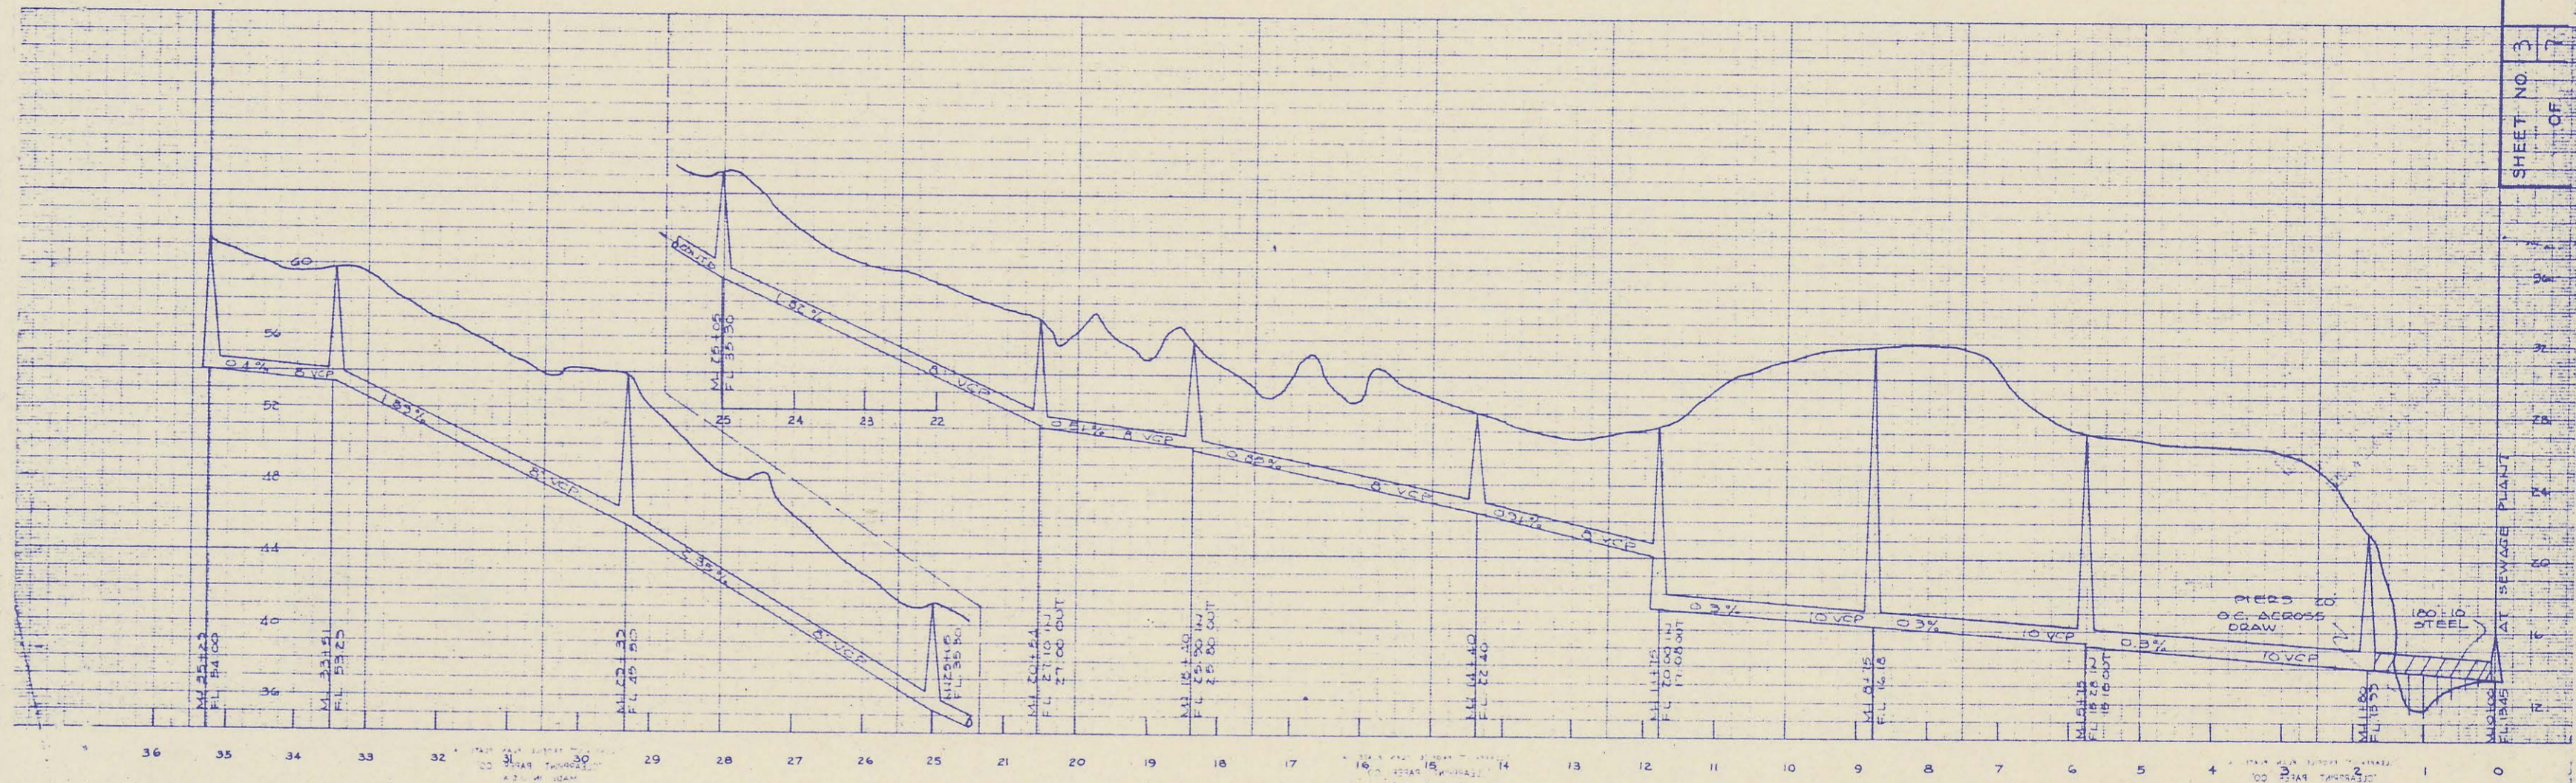

REISS AND GOODNESS ENGINEERS  
 WICHITA, KANSAS  
 1989

SHEET NO. 3  
 OF 7

SEWER OUTFALL LINE  
 CHESTVIEW COUNTRY CLUB