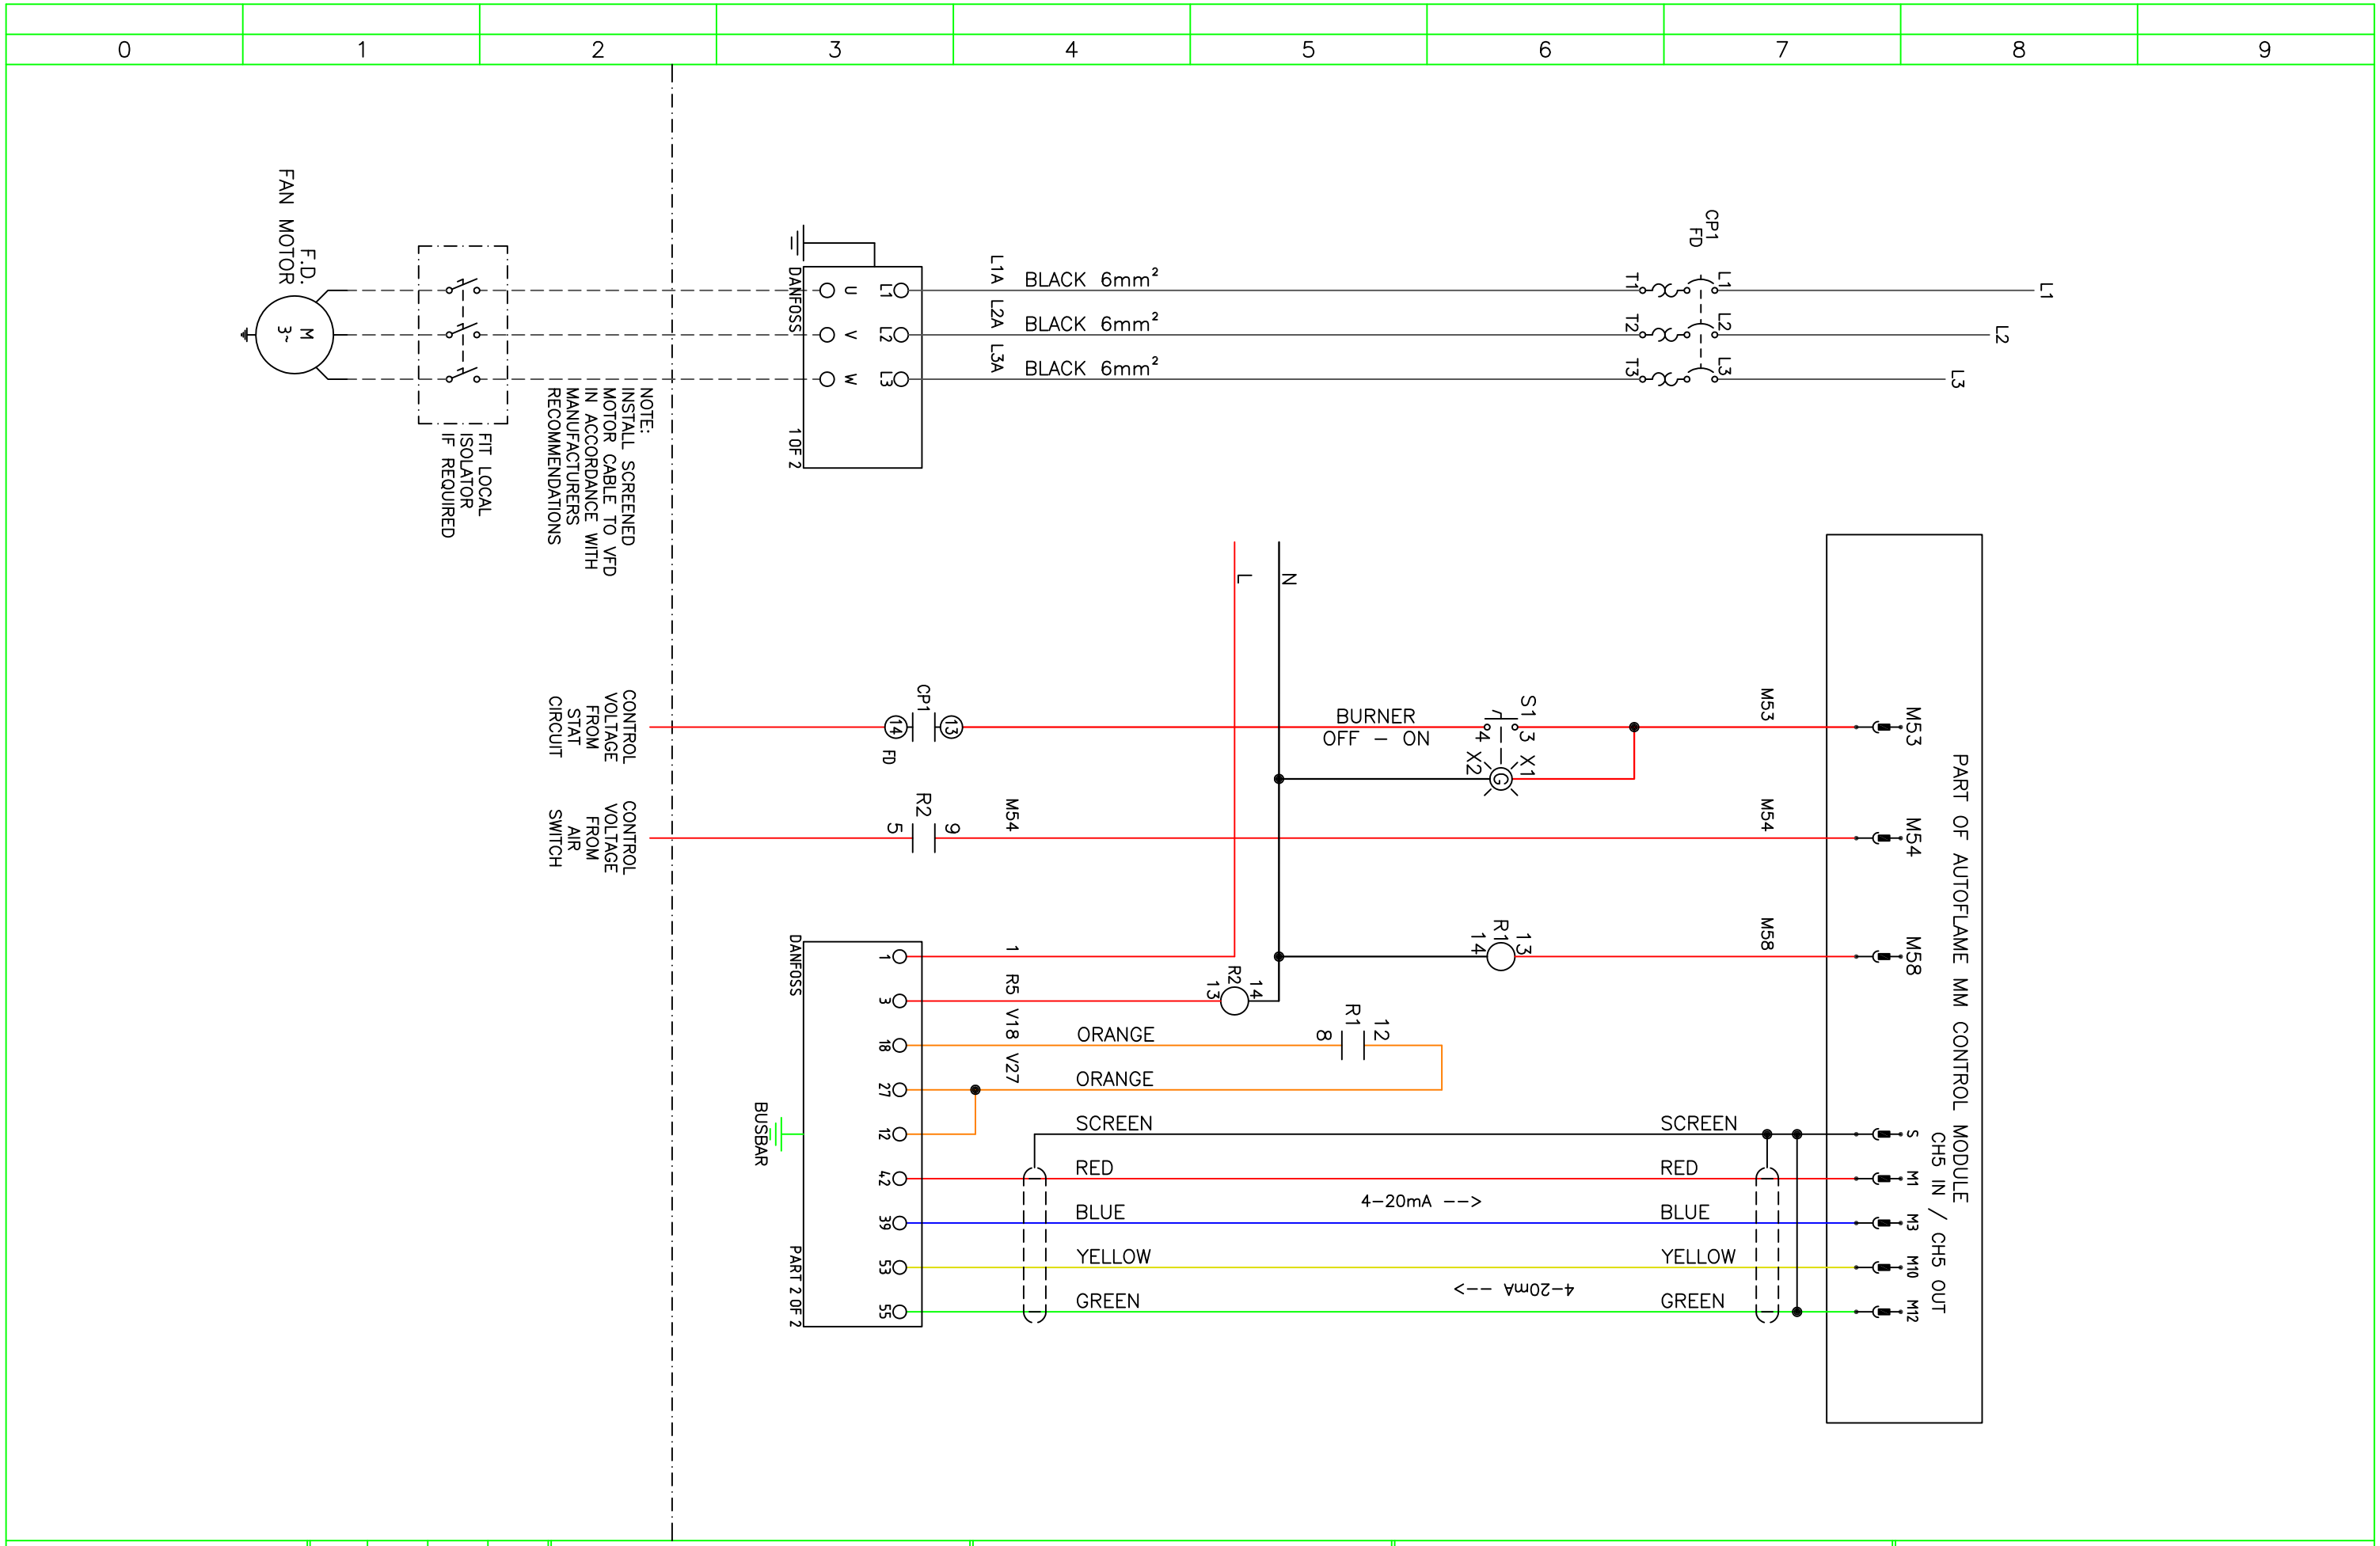

THIS DESIGN/DRAWING IS THE PROPERTY OF AUTOFLAME ENGINEERING LTD. AND IS SUPPLIED WITHOUT RESPONSIBILITY ON OUR PART AND FOR YOUR PRIVATE INORMATION ALONE. IT IS TO BE SHOWN ONLY TO YOUR SERVANTS OR AGENTS FOR THE PURPOSES OF YOUR BUSINESS AND TO NO OTHER PERSONS AND IS TO BE RETURNED TO US ON DEMAND OR WHEN YOU NO LONGER REQUIRE IT, WHICHEVER IS THE EARLIER.

ISSUE	DATE	AUTH.	AMD.No
1	27/01/12	J.H.	0

SPECIAL NOTES

1. ALL SYMBOLS INTERNATIONAL JIC STANDARDS
2. CABLE COLOURS:
   MAIN INCOMING PHASES–BLACK, EARTH–GREEN/YELLOW
   CONTROL CIRCUIT 115Vac: LIVE–RED, NEUTRAL–WHITE, SWITCHED NEUTRAL–MAUVE
   EXTRA LOW VOLTAGE: 24Vac: LIVE–YELLOW, NEUTRAL–WHITE, 24Vdc–ORANGE, 0Vdc–WHITE, VOLT FREE–PINK
3. ALL CABLES 0.75mm² (20AWG) UNLESS OTHERWISE NOTED
4. FIELD WIRING SHOWN DASHED THUS: - - - - - -

DRAWING TITLE

TYPICAL DANFOSS VSD
WIRING DIAGRAM
1 OF 1

AUTOFLAME
ENGINEERING LIMITED
UNIT 1 & 2 CONCORDE BUSINESS CENTRE,
AIRPORT INDUSTRIAL ESTATE, WIRELESS ROAD, BIGGIN HILL,
KENT, TN16 3YN
WWW.AUTOFLAME.COM
TEL: 0845 872 2000 / FAX 0845 872 2010

CLIENT/SITE -

RECORD DRAWING

SCALE – NTS	DATE – 27/01/12	JOB No. –
DRAWN – J.H.	CHECKED –	DWG No. – 7693–1