

CITY OF WICHITA, KANSAS – DEPARTMENT OF PUBLIC WORKS & UTILITIES  
**USE-OF-STREET PERMIT**

**KEEP A COPY OF THIS APPLICATION ON SITE OF OPERATION**

Street address of permit location: 1609 N. Womer

This application is submitted for the use of Public Property as described and shown below:

20 feet by 8 feet, which is 160 square feet, along Womer Street  
feet by \_\_\_\_\_ feet, which is \_\_\_\_\_ square feet, along \_\_\_\_\_ Street  
feet by \_\_\_\_\_ feet, which is \_\_\_\_\_ square feet, in alley.

Dates of permit: from 12/4/2023 through 12/17/2023

160 x 0.009 = \$ 1.44 x 14 = \$ 20.16 + \$55.00 = \$ 75.16 Total Permit Fee  
Total square feet                      Rate per day                      Total days

Will use of street or sidewalk be impacted?  
 Street:  / N  
 Sidewalk: Y

If yes to either: Is vehicular traffic control plan and/or pedestrian access plan\* attached? Y / N

Traffic Control Plan Approval  
 By: N/A Date: \_\_\_\_\_

\*Due to pedestrian volumes in the Wichita downtown area, contractors are responsible for ADA-accessible alternate routes on the same side or opposite side of the street. Construction of tunnels on same side of the street would only be required in unique situations of long-term construction where pedestrian volumes are high enough to warrant such installation. Failure to install and maintain ADA-accessible access and traffic control will result in the revocation of permit.

MUTCD temporary construction typical applications:  
<https://mutcd.fhwa.dot.gov/htm/2009r1r2/part6/part6h.htm#table6H01>

Permitee must place and maintain walkways, fences, barricades, traffic control devices, or other protections, in accordance with the latest version of the Manual of Uniform Traffic Control Devices (MUTCD), for the protection and convenience of the general public. The placement of these obstructions shall not interfere with the public utilities such as fire hydrant, light pole, signal, manhole, stormwater inlet, or the passage of water in the gutter.

Permitee shall comply with all applicable laws, rules, and ordinances. Permitee shall save, indemnify, and hold harmless the City of Wichita of any and all liability of personal injury or property damage, either public or private, which may occur due to the occupancy of public property.

Permitee shall be responsible for repair of all public property determined by the City of Wichita to be damaged in the use of the area.

**I AFFIRM THAT THE PERMITEE WILL COMPLY WITH PART VI OF THE MUTCD.**

<http://mutcd.fhwa.dot.gov>

All Seasons Construction  
Contracting Company

316 685-1700  
Telephone Number


Daisy Dominguez  
Signature, Contractor's Representative

info@allseasonsconstruction.com  
Property Owner

Permission is granted for the issuance of a permit for the use of public property described above and adjoining the property of the owner shown hereon, subject to all laws relating thereto.

Permit issued by: Miriam Lopez

Date: 12/4/2023

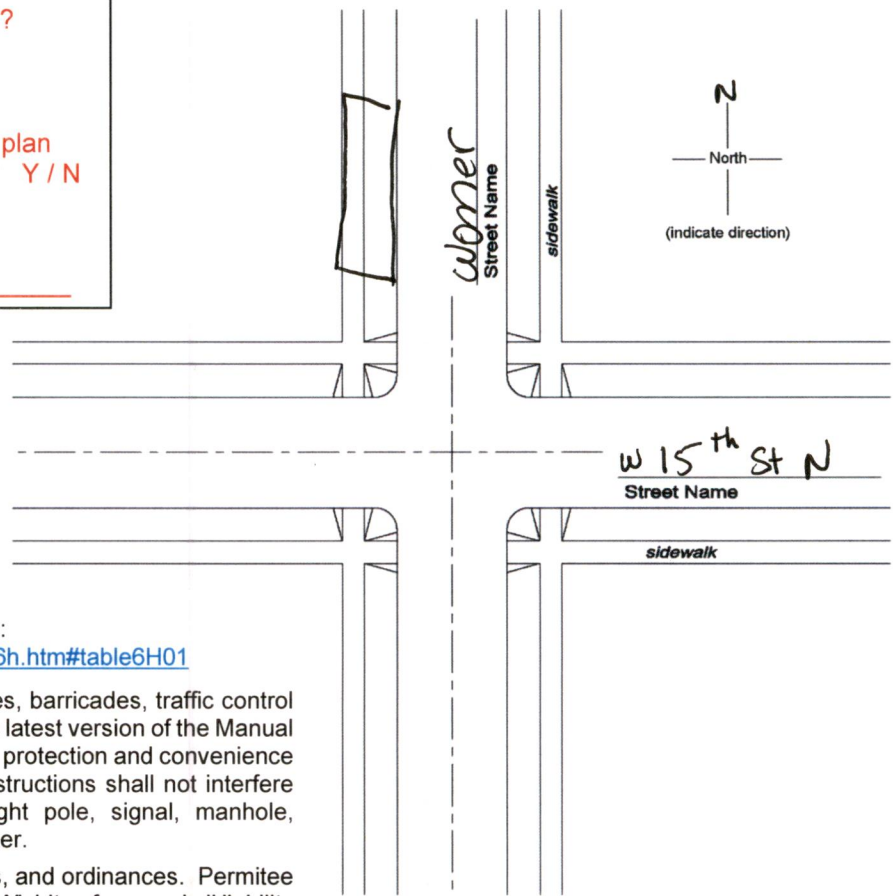

WICHITA PBLC WRK ENGIN  
455 N MAIN  
WICHITA, KS 67202

12/04/2023

10:26:24

CREDIT CARD

VISA SALE

Card #	XXXXXXXXXXXX5495
SEQ #:	1
Batch #:	1899
INVOICE	1
Approval Code:	08722G
Entry Method:	Manual
Mode:	Online
Tax Amount:	\$0.00
Avs Code:	NYZ

SALE AMOUNT	\$75.16
-------------	---------

CUSTOMER COPY

## Lopez, Miriam

---

**From:** All Seasons Construction <info@allseasonsconstruction.com>  
**Sent:** Monday, December 4, 2023 10:03 AM  
**To:** Lopez, Miriam  
**Subject:** 1609 N Womer

You don't often get email from info@allseasonsconstruction.com. [Learn why this is important](#)

CAUTION: This email originated from outside of the organization. Do not click links or open attachments unless you recognize the sender and know the content is safe.

Hello Miriam,  
I need a dumpster permit for 2 weeks starting today 12/4/2023 for the following address:  
1609 N Womer Wichita, KS 67203  
You can call me at the number below when you are ready for payment.

Daisy D  
Office Manager

Thank you,

All Seasons Construction, Inc.  
916 S. Gouverneur | Wichita, KS 67207

[316-685-1700](tel:316-685-1700)

[Website](#)  
| [Facebook](#)



Virus-free [www.avast.com](http://www.avast.com)