
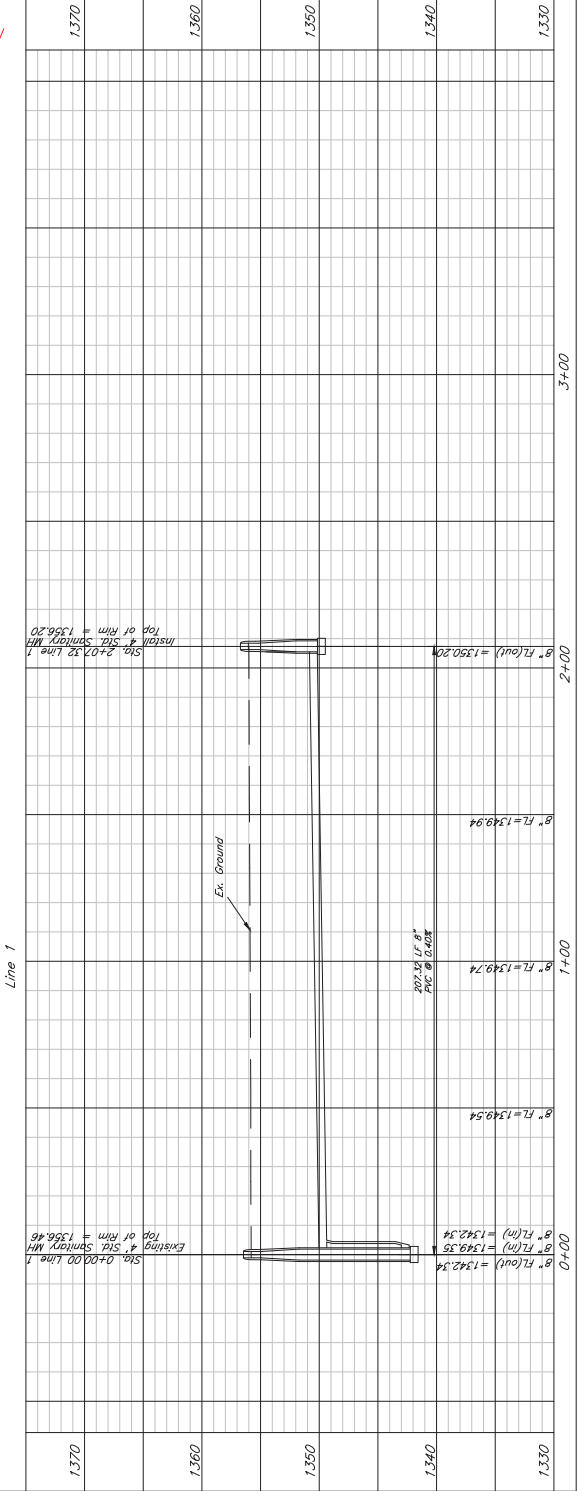


Beem Monte Spn  
Plan & Profile Line 1  
Wichita, Kansas

KEMILLER		PROJECT NUMBER	DATE	SHEET
22046	FILE	2022-05105 PPS	7/2022	3.0
DESIGN	EXAMIN	DATE	REVISED	
PG	PG	10/10/2022	10/2022	

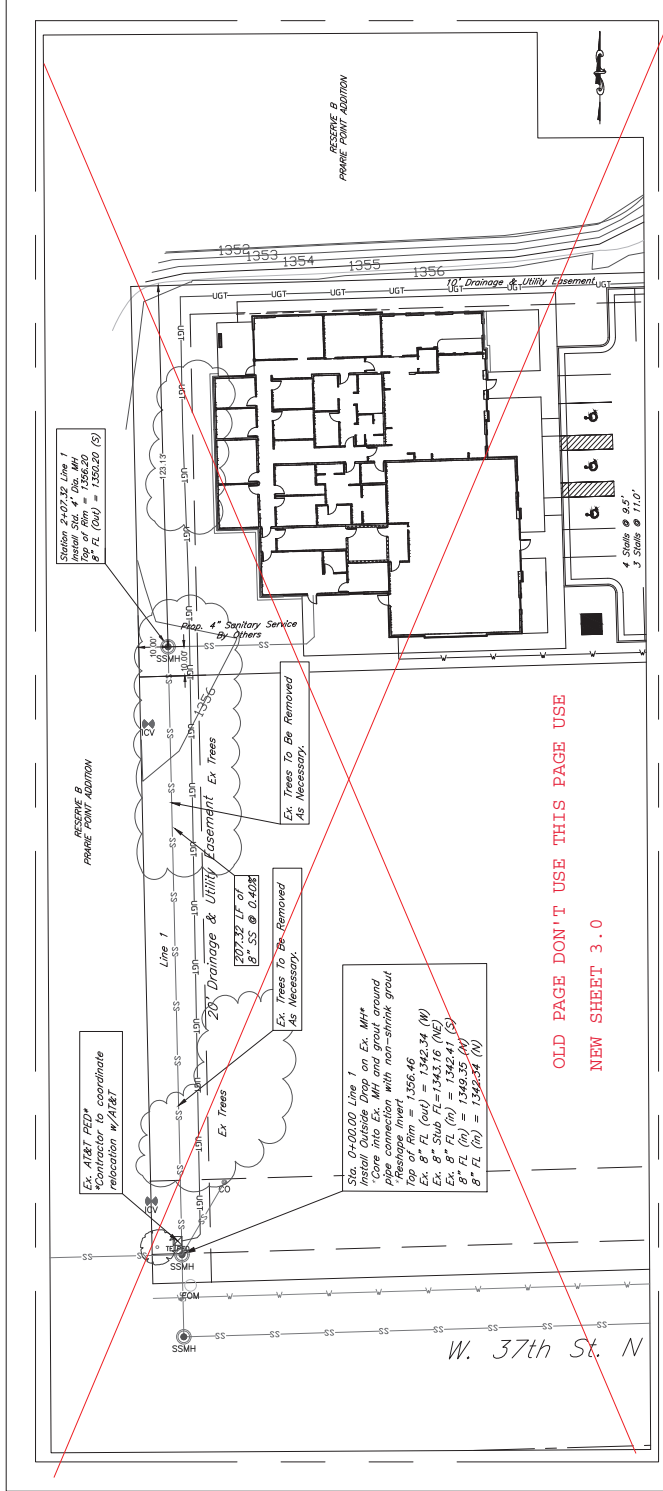

OLD PAGE DON'T USE THIS PAGE USE  
NEW SHEET 3.0

W. 37th St. N



