


d:\navarro\8/1/2022 - 2:26:57 PM - c:\transystems\pwworking\transystems\pwworking\1083577C-SLUDGE-M02-201.DGN

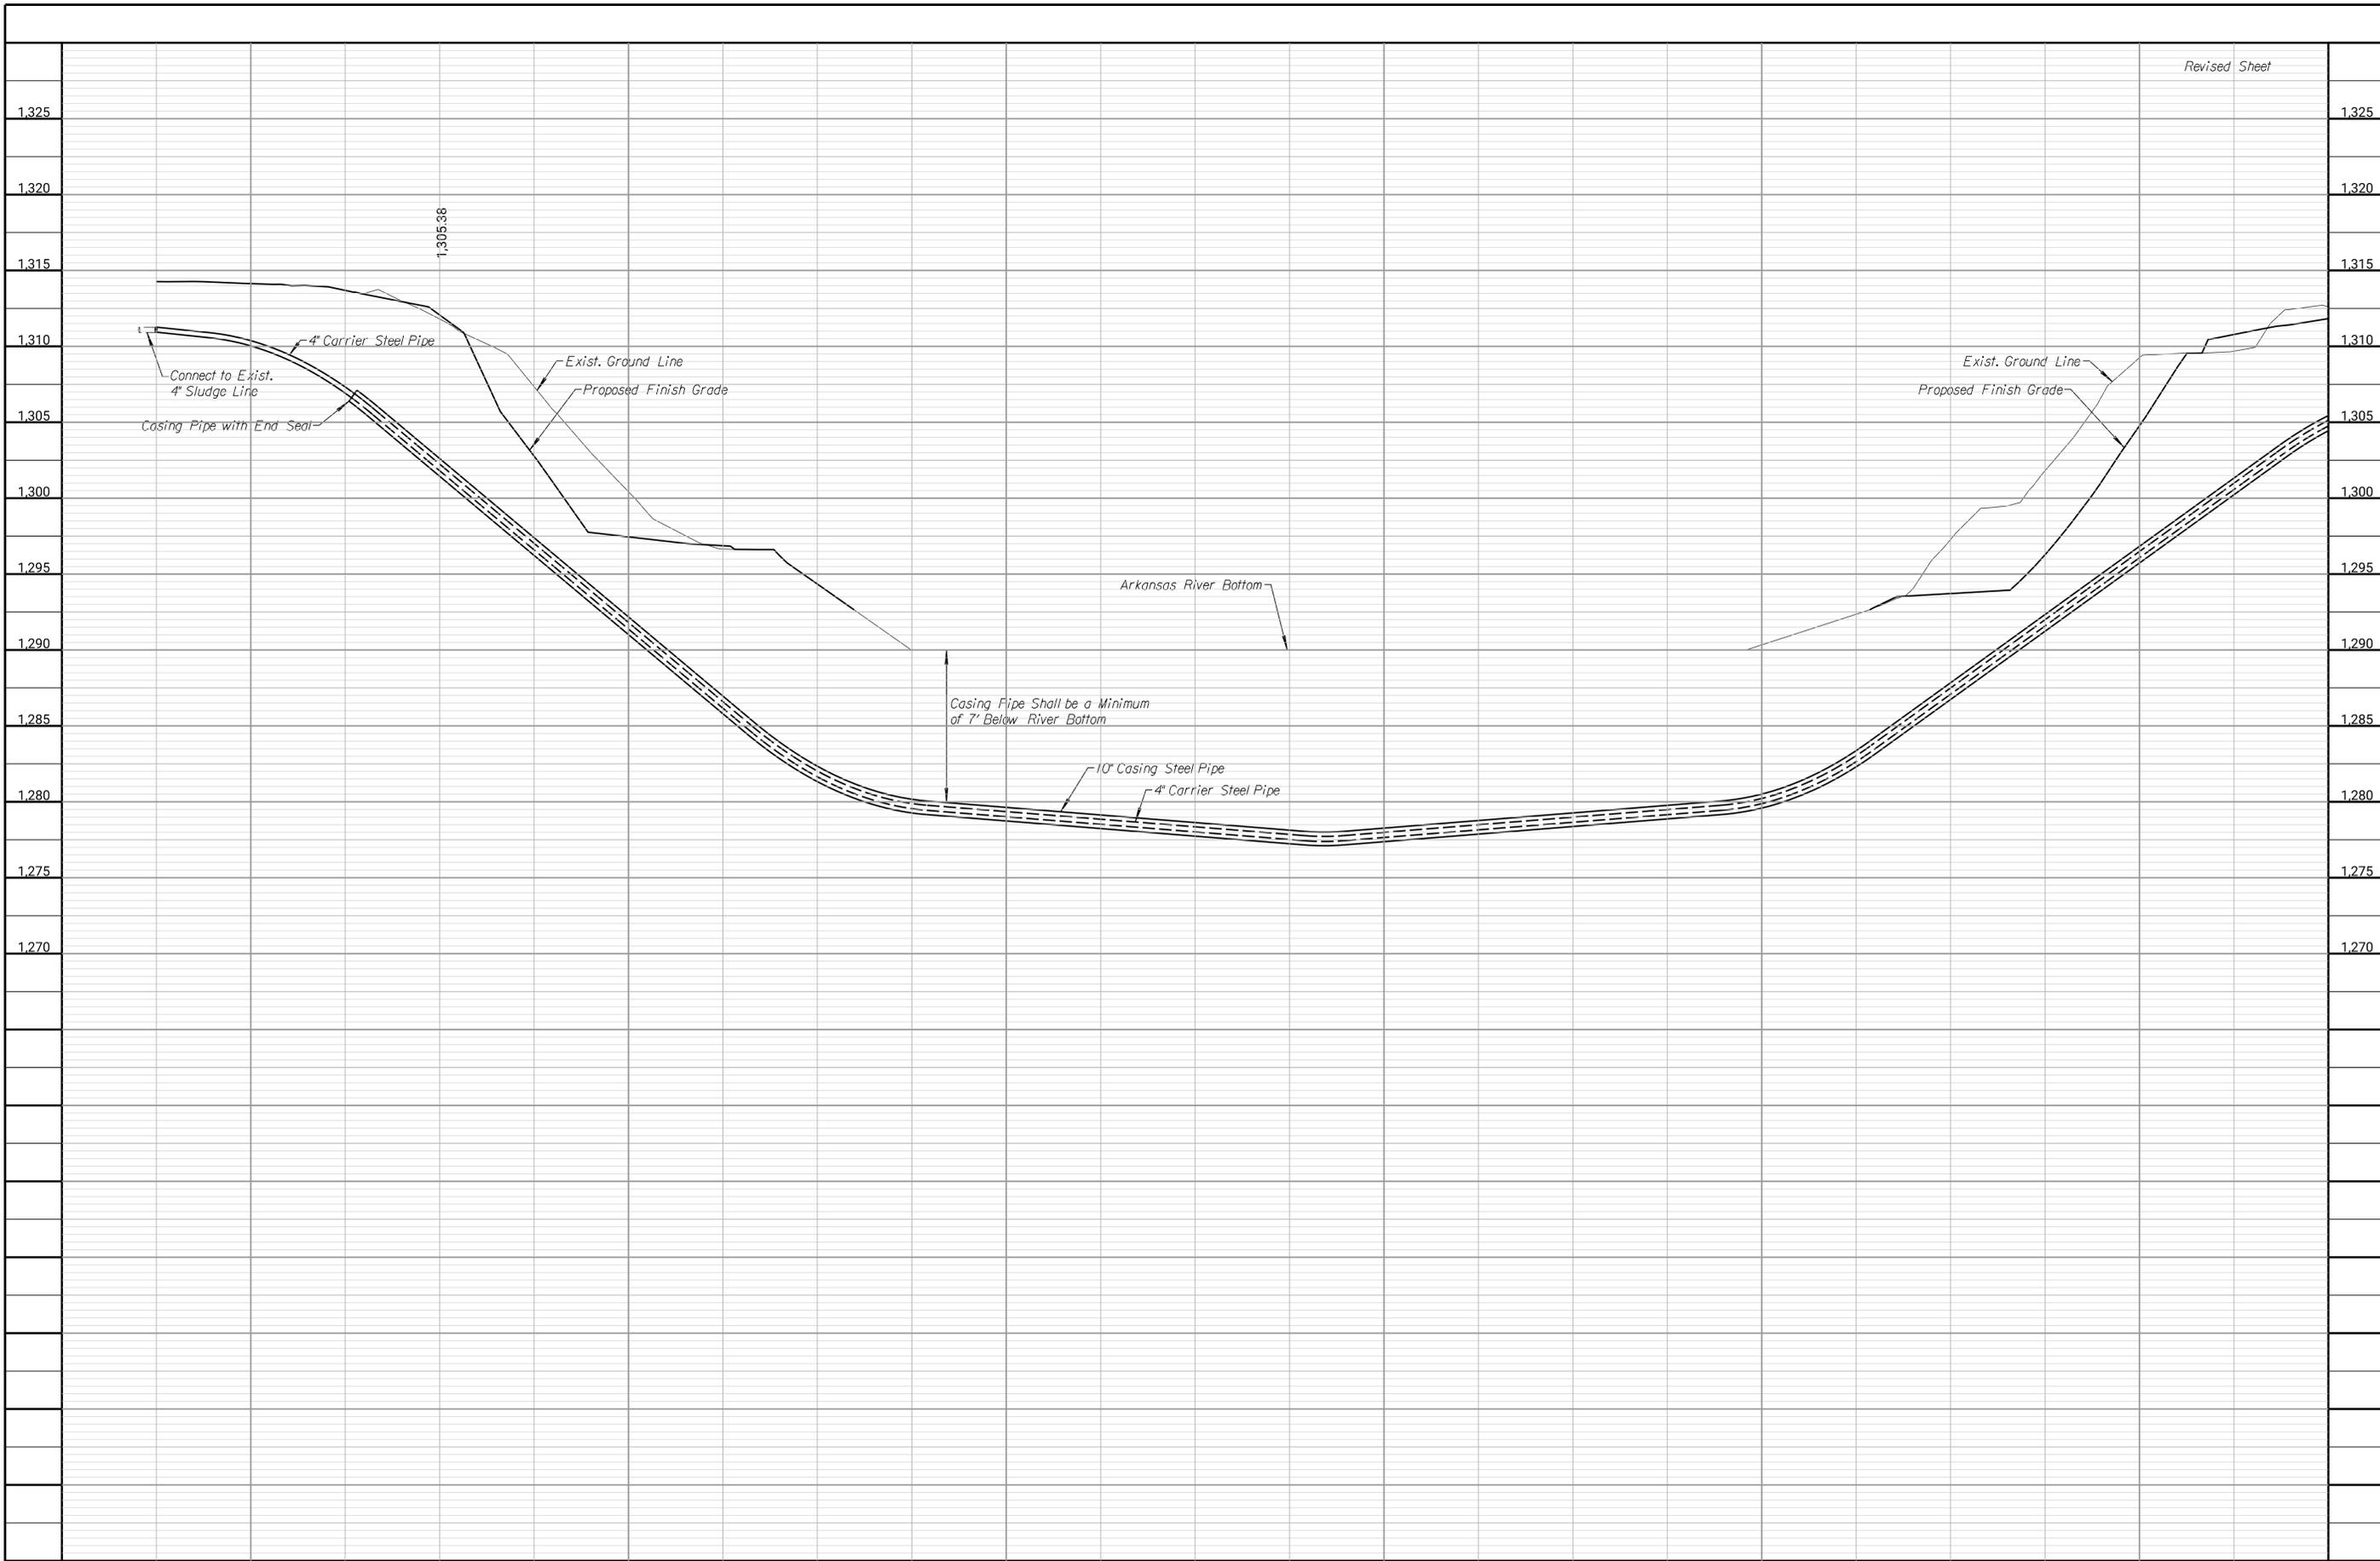

Revised Sheet

Tran Systems
 245 NORTH WACO
 SUITE 222
 WICHITA, KANSAS 67202
 PHONE: 316-303-3000
 FAX: 316-462-5629

CONSULTANTS:

**AMIDON AVENUE BRIDGE
 AT ARKANSAS RIVER**
 WICHITA, KANSAS

REVISIONS:	MARK	DATE	DESCRIPTION
1		7/29/2022	Alignment Change, Pipe Material Change

PROJ NO: E1010-40250621
 SCALE: 1"=40'
 DATE: 8/1/2022
 DESIGNED BY: DAN
 DRAWN BY: DAN
 CHECKED BY: MDB

SHEET TITLE:
**SLUDGE LINE
 PROFILE**

SHEET NO.
107
 SHEET 107 OF 128

© Amidon Avenue

