



DataLog® Drill Report

Job Information

Job Location:

Name:

Contact:

Phone:

Address:

City:

Client Information:

Contractor Information:

Receiver/Job Information

39 data points collected on unit Serial Number: 30136724 in Job 11 on 09/20/2022. Flags and Pins listed below (if applicable).

All units in charts and tables are Distance in ft, Depth in ft, Pitch in %, and Pressure in PSI.

Reference Elevation is not measured.

Entry Point Relative Depth 0.00. Chart and Table zero are the Reference Elevation.

Exit Terrain not surveyed.

First Rod Length is 5.00


Typical Rod Length is 20.00

Last Rod Length is 20.00

Total number of rods 38


Drill Data

Profile Chart

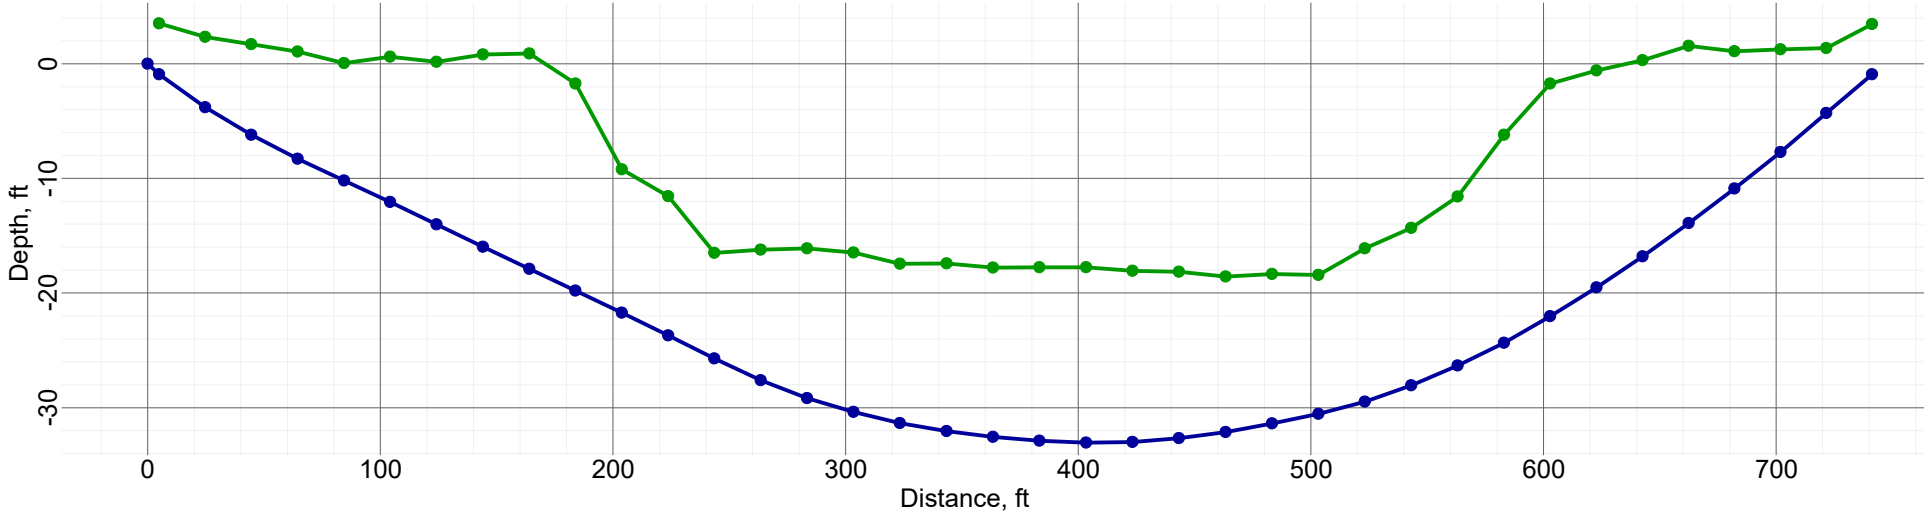

Blue: Drill Path -- Green: Calculated Terrain

Pressure Chart

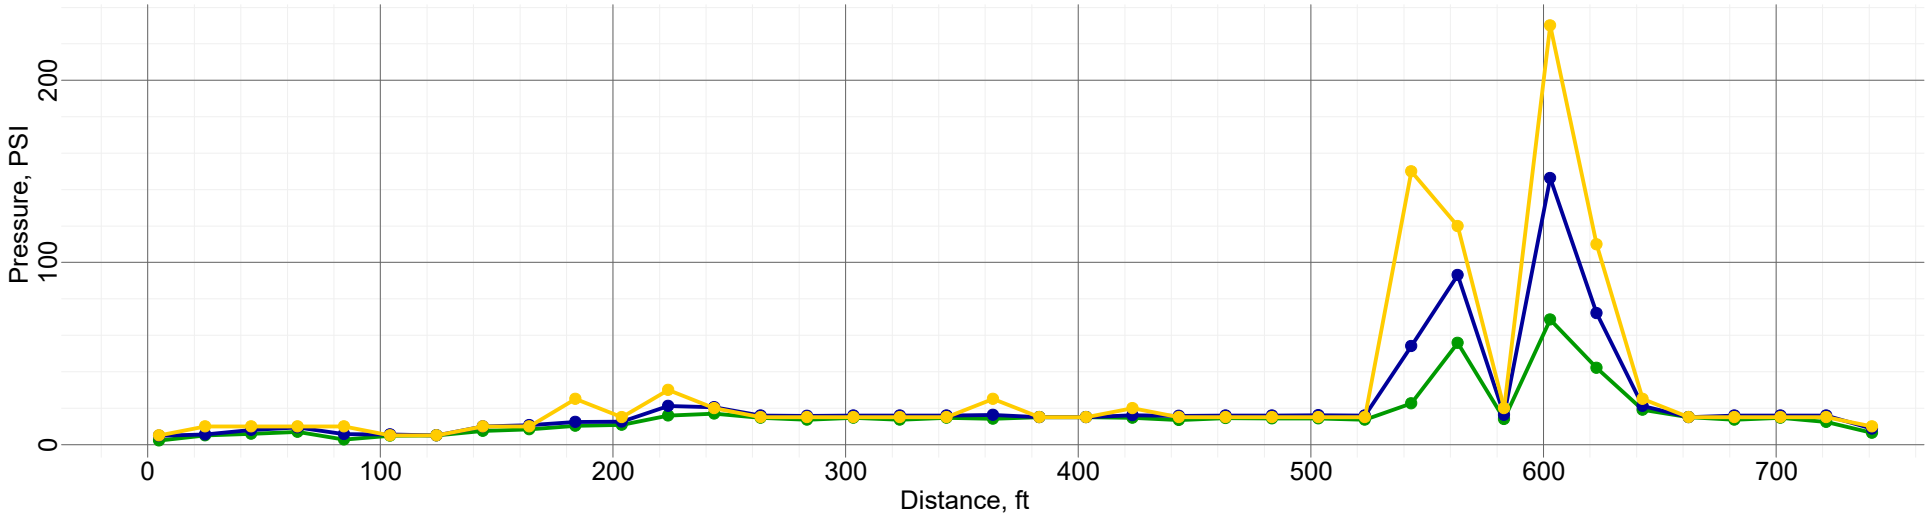

Green: Average Pressure -- Blue: High Pressure -- Gold: Max Pressure



Drill Data Points

FLP(Front Locate) - LL(Locate Line) - PO(Pitch Only) - BL(No Data) - o(override) - f(filled in) - i[*](interpolated)

Rod ID	Type	Bore Len.	X Dist.	Pitch	Rel.Depth	Depth	Rel.Elev.	L/R Offset	Deviation	Latitude	Longitude	GNSS X Dist.
0	PO	0.00	0.00	-20.9	0.00		0.00	N/A	N/A			
1	LL	5.00	4.92	-16.1	-0.91	4.41	3.50	N/A	N/A	N/A	N/A	N/A
2	LL	25.00	24.71	-13.0	-3.79	6.15	2.35	N/A	N/A	N/A	N/A	N/A
3	LL	45.00	44.56	-11.3	-6.20	7.89	1.69	N/A	N/A	N/A	N/A	N/A
4	LL	65.00	64.45	-9.8	-8.30	9.35	1.06	N/A	N/A	N/A	N/A	N/A
5	LL	85.00	84.36	-9.2	-10.19	10.25	0.06	N/A	N/A	N/A	N/A	N/A
6	LL	105.00	104.27	-9.7	-12.07	12.68	0.61	N/A	N/A	N/A	N/A	N/A
7	LL	125.00	124.18	-9.7	-14.01	14.17	0.16	N/A	N/A	N/A	N/A	N/A
8	LL	145.00	144.08	-9.9	-15.96	16.78	0.82	N/A	N/A	N/A	N/A	N/A
9	LL	165.00	163.99	-9.4	-17.88	18.76	0.88	N/A	N/A	N/A	N/A	N/A
10	LL	185.00	183.90	-9.7	-19.78	18.05	-1.73	N/A	N/A	N/A	N/A	N/A
11	LL	205.00	203.81	-9.8	-21.72	12.50	-9.23	N/A	N/A	N/A	N/A	N/A
12	LL	225.00	223.71	-10.0	-23.69	12.14	-11.55	N/A	N/A	N/A	N/A	N/A
13	LL	245.00	243.61	-10.2	-25.71	9.22	-16.49	N/A	N/A	N/A	N/A	N/A
14	LL	265.00	263.52	-8.9	-27.61	11.38	-16.23	N/A	N/A	N/A	N/A	N/A
15	LL	285.00	283.46	-6.7	-29.17	13.05	-16.12	N/A	N/A	N/A	N/A	N/A
16	LL	305.00	303.42	-5.5	-30.38	13.92	-16.47	N/A	N/A	N/A	N/A	N/A
17	LL	325.00	323.40	-4.1	-31.34	13.89	-17.45	N/A	N/A	N/A	N/A	N/A
18	LL	345.00	343.38	-2.9	-32.05	14.62	-17.43	N/A	N/A	N/A	N/A	N/A
19	LL	365.00	363.38	-2.2	-32.56	14.77	-17.80	N/A	N/A	N/A	N/A	N/A
20	LL	385.00	383.37	-1.2	-32.90	15.14	-17.76	N/A	N/A	N/A	N/A	N/A
21	LL	405.00	403.37	-0.3	-33.04	15.30	-17.75	N/A	N/A	N/A	N/A	N/A
22	LL	425.00	423.37	0.9	-32.98	14.91	-18.07	N/A	N/A	N/A	N/A	N/A
23	LL	445.00	443.37	2.2	-32.67	14.52	-18.15	N/A	N/A	N/A	N/A	N/A
24	LL	465.00	463.36	3.2	-32.12	13.57	-18.56	N/A	N/A	N/A	N/A	N/A
25	LL	485.00	483.35	4.4	-31.36	13.03	-18.33	N/A	N/A	N/A	N/A	N/A
26	LL	505.00	503.33	4.0	-30.53	12.10	-18.43	N/A	N/A	N/A	N/A	N/A
27	LL	525.00	523.30	6.4	-29.49	13.39	-16.11	N/A	N/A	N/A	N/A	N/A
28	LL	545.00	543.25	8.2	-28.04	13.72	-14.32	N/A	N/A	N/A	N/A	N/A
29	LL	565.00	563.18	9.2	-26.32	14.74	-11.58	N/A	N/A	N/A	N/A	N/A
30	LL	585.00	583.08	10.8	-24.33	18.14	-6.20	N/A	N/A	N/A	N/A	N/A
31	LL	605.00	602.95	12.4	-22.03	20.31	-1.72	N/A	N/A	N/A	N/A	N/A
32	LL	625.00	622.79	13.0	-19.50	18.91	-0.60	N/A	N/A	N/A	N/A	N/A
33	LL	645.00	642.60	14.1	-16.81	17.10	0.29	N/A	N/A	N/A	N/A	N/A
34	LL	665.00	662.39	15.2	-13.91	15.48	1.57	N/A	N/A	N/A	N/A	N/A
35	LL	685.00	682.16	15.4	-10.89	11.99	1.10	N/A	N/A	N/A	N/A	N/A
36	LL	705.00	701.91	16.9	-7.70	8.95	1.25	N/A	N/A	N/A	N/A	N/A
37	LL	725.00	721.62	17.6	-4.31	5.67	1.36	N/A	N/A	N/A	N/A	N/A
38	LL	745.00	741.33	16.7	-0.92	4.37	3.45	N/A	N/A	N/A	N/A	N/A

Pressure Data

Pressure Legend...

Rod ID	X Dist.	Num Samples	Avg. Pres.	High Pres.	Max Pres.	Comment
0	0.00	0	N/A	N/A	N/A	
1	4.92	210	2	5	5	
2	24.71	115	5	6	10	
3	44.56	129	6	8	10	
4	64.45	142	7	9	10	
5	84.36	152	3	6	10	
6	104.27	178	5	6	5	
7	124.18	155	5	5	5	
8	144.08	160	7	10	10	
9	163.99	147	8	11	10	
10	183.90	160	10	12	25	
11	203.81	122	11	13	15	
12	223.71	165	16	21	30	
13	243.61	122	17	21	20	
14	263.52	153	15	16	15	
15	283.46	156	14	16	15	
16	303.42	158	15	16	15	
17	323.40	111	14	16	15	
18	343.38	145	15	16	15	
19	363.38	167	14	16	25	
20	383.37	116	15	15	15	
21	403.37	176	15	15	15	
22	423.37	137	15	16	20	
23	443.37	221	14	16	15	
24	463.36	150	15	16	15	
25	483.35	132	14	16	15	
26	503.33	133	14	16	15	
27	523.30	145	14	16	15	
28	543.25	395	23	54	150	
29	563.18	184	56	93	120	
30	583.08	166	14	16	20	
31	602.95	132	69	146	230	
32	622.79	123	42	72	110	
33	642.60	248	19	21	25	
34	662.39	114	15	15	15	
35	682.16	167	14	16	15	
36	701.91	128	15	16	15	
37	721.62	123	12	16	15	
38	741.33	60	6	9	10	