



Wichita-Sedgwick County Metropolitan Area Planning Department

April 11, 2002

Power CDC
c/o James Arbertha
1802 N. Hydraulic
Wichita, KS 67214

FILE COPY

Re: BZA2002-00016: Administrative Adjustment to reduce the street side setback.

Legal Description: Lots 189 and 191, Eleventh St. Addition, Wichita, Sedgwick County, Kansas (1204 N. Ash).

Dear Mr. Arbertha:

We have reviewed your request for an Administrative Adjustment to reduce the street side setback on the above-referenced property. From reviewing your application, we understand that you desire to construct a 36-foot wide single-family residence on the property; however, the 15 foot street side setback and the 6 foot interior side setback leave only 33.3 feet of buildable area on the property. Therefore, you request to reduce the street side setback by 3 feet.

The Unified Zoning Code allows an adjustment to reduce setbacks by up to 20 percent. We find that the reduction of the street side setback from 15 feet to 12 feet meets the four conditions required by Section V-1.6 of the Unified Zoning Code as set out below:

- 1) Impact on safety and convenience of vehicular and pedestrian circulation: The proposed encroachment should have no impact on the safety and convenience of vehicular and pedestrian circulation in the vicinity as the street side yard will not be used for a vehicle parking area.
- 2) Impact on existing uses in surrounding areas: There should be no negative impact on the existing uses in surrounding areas as a result of the reduction of the street side setback, as sufficient separation between buildings is maintained and sight lines of existing structures will not be obstructed.
- 3) Compatibility with existing or permitted uses on abutting sites: The proposed single-family residence is compatible with abutting sites, which also are developed in a similar fashion including street side setbacks of less than 15 feet.

City Hall • 10th Floor • 455 North Main • Wichita, Kansas 67202-1688

T 316.268.4421 F 316.268.4390


www.wichitagov.org


- 4) Effect on public health, safety or welfare: There will be no encroachment into public utility easements or right-of-way; therefore, there should not be a negative impact on the public health, safety or welfare nor will properties or improvements in the vicinity be materially injured.

Our signatures below indicate that an Administrative Adjustment to reduce the street side setback from 15 feet to 12 feet for the aforementioned property is hereby granted, subject to the following conditions:

- 1) The site shall be developed in general conformance with the approved site plan.
- 2) Any violation of these conditions shall render the Administrative Adjustment null and void.

The zoning adjustment sign may now be removed from the property.


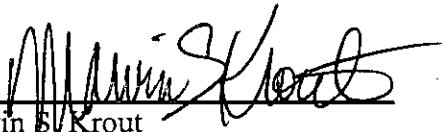

Marvin S. Krout
Planning Director

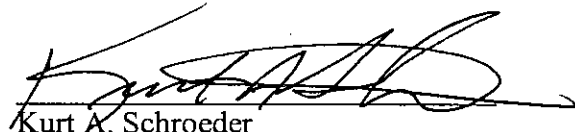
Kurt A. Schroeder
Superintendent of Central Inspection

Enclosure

cc: Tony Zimbelman, Zimbelman Homes, 1344 N. Pine Grove Ct., Wichita, KS 67212
Kurt Schroeder, Office of Central Inspection
Paul Hays, Office of Central Inspection
Randy Sparkman, Office of Central Inspection
J.R. Cox, Office of Central Inspection

Signs up 3/27/02

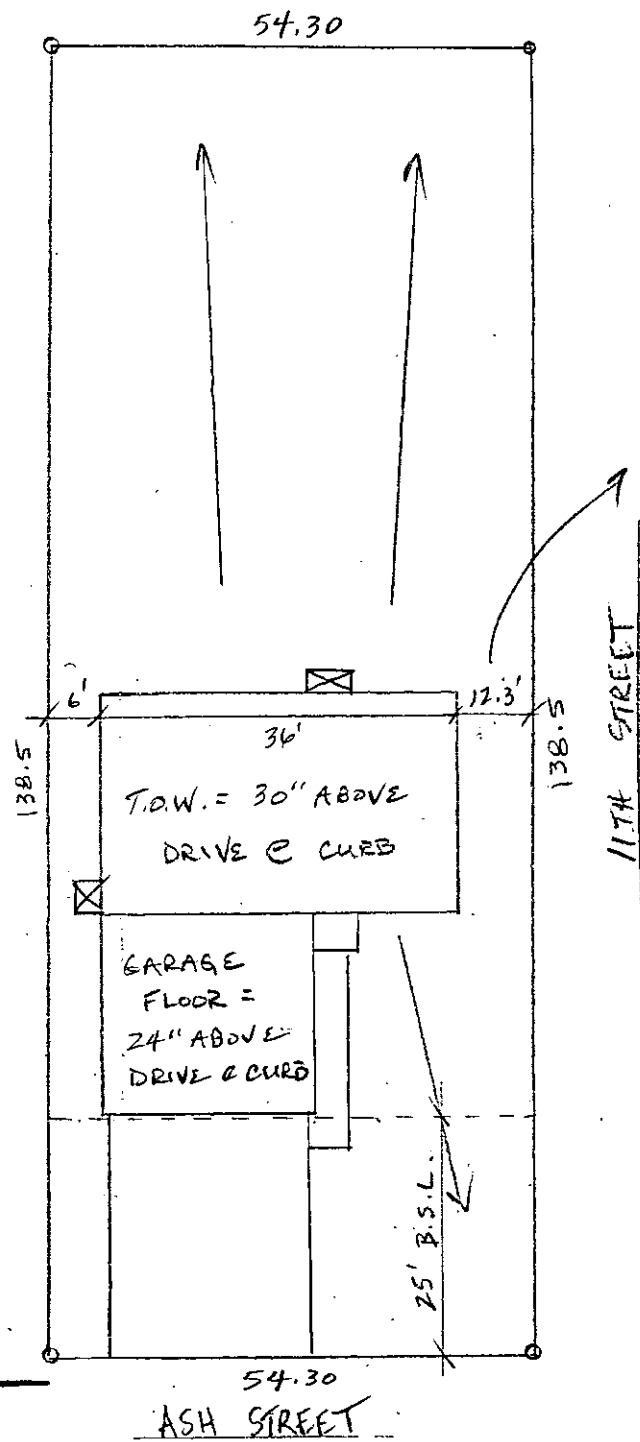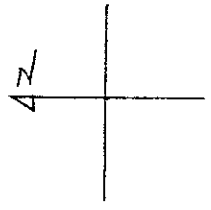

TF3 ZONING REQUIRES
 15' SIDEYARD - REQUEST
 20% REDUCTION TO 12'
 TO ALLOW HOUSE TO FIT
 ON SITE.

B2AZ002-00016

SITE PLAN

APPROVED 4-11-02 BY *SK*

54.30
ASH STREET

Zimbelman Homes
 1544 Pine Grove Ct.
 Wichita, KS. 67212
 Tony Zimbelman, Builder
 Lic. # 2474

1202 N. ASH
 LOTS 189 & 191
 CONTROL #: 136098
 ELEVENTH STREET ADDITION
 WICHITA, KS 67214
 KEY #: C-966
 SCALE: 1" = 20'