


VAC 2009-08

N.W. ¼ SEC. 21, TWP. 27, R.1 E.

WI
82

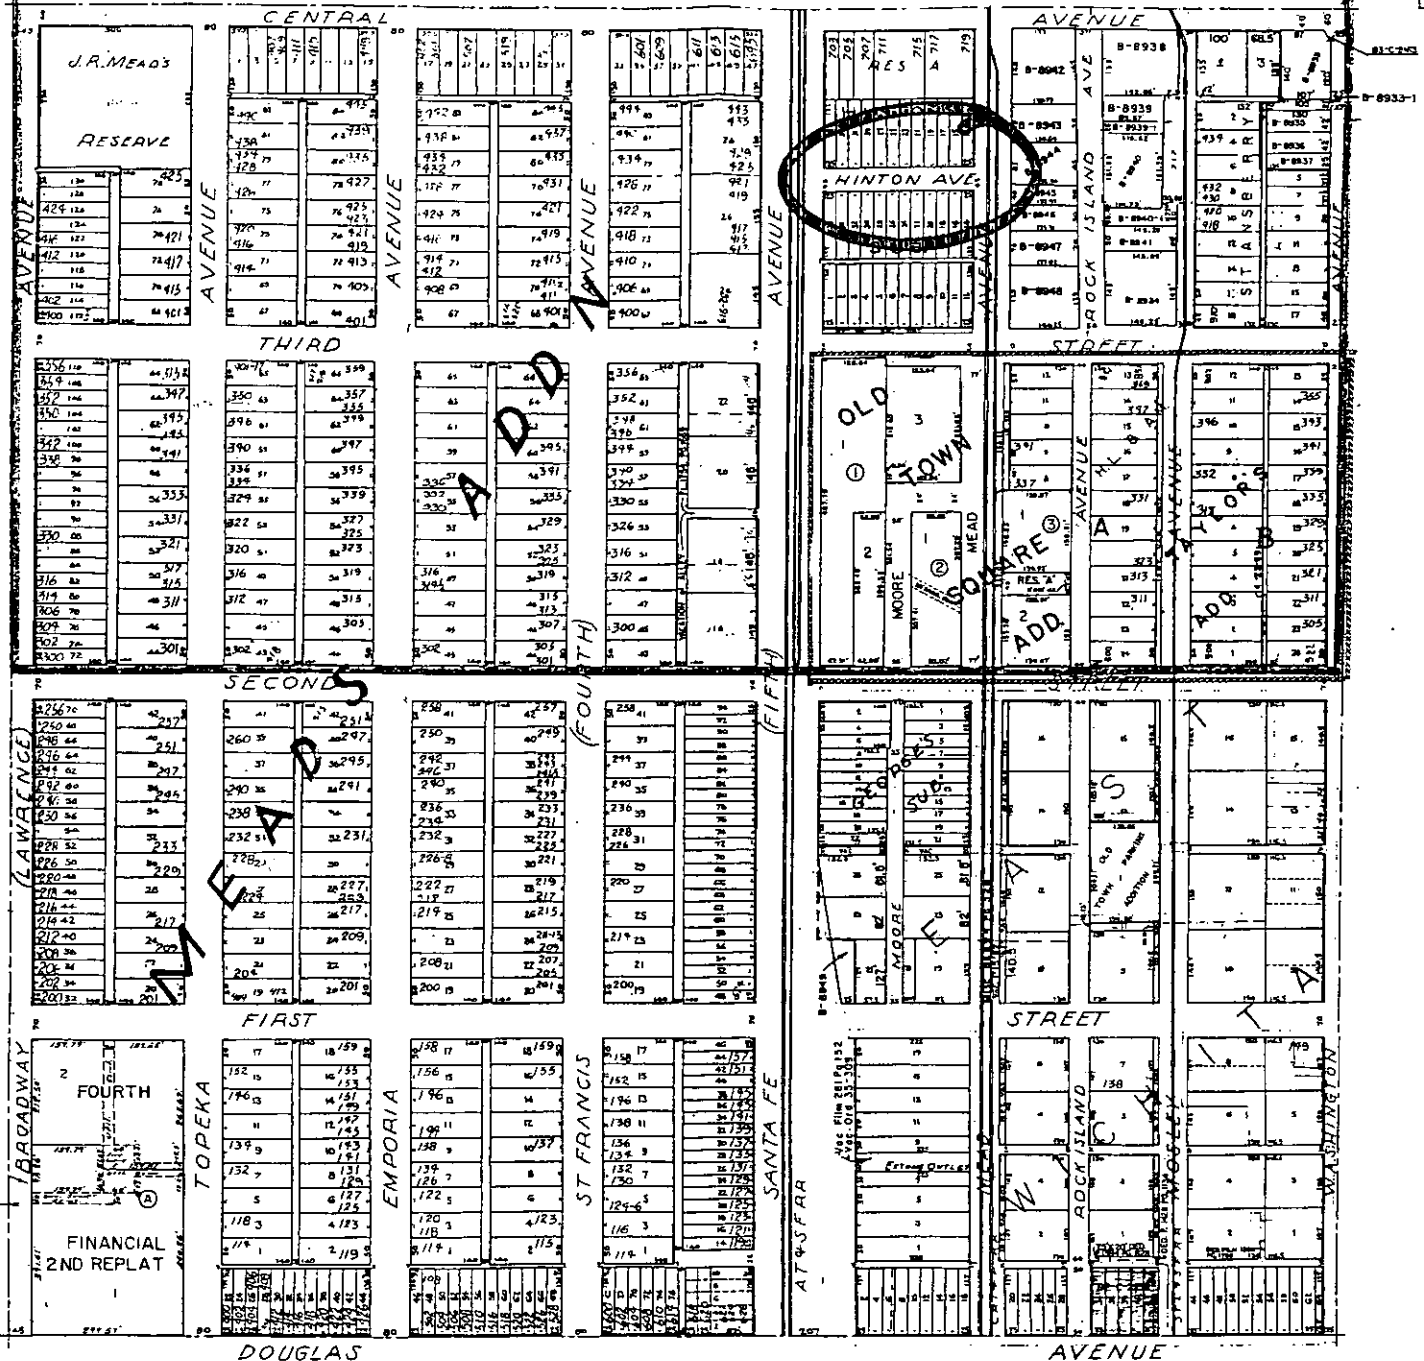

SEDGWICK COUNTY CLERK