


CEDARVALE ACRES

SEDGWICK COUNTY, KANSAS

VAC(2009-1)

C1-B-9

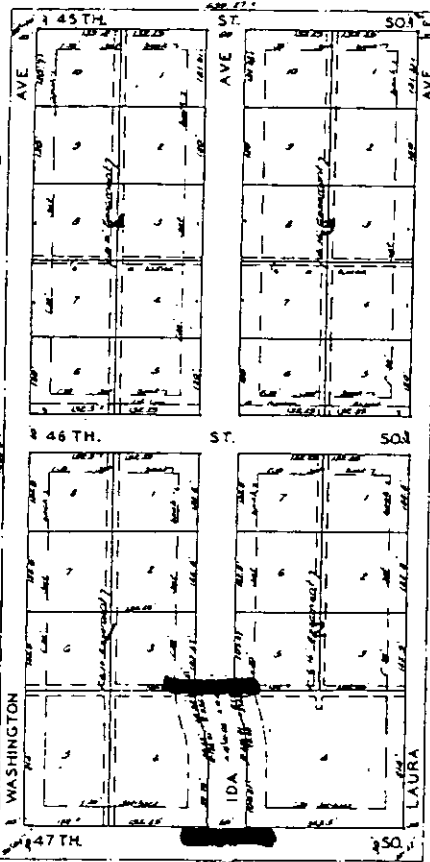

State of Kansas } ss I Clyde M. Baughman Surveyor
Sedgwick County } in and for said County and State do hereby certify
that I have surveyed and plotted CEDARVALE
ACRES Sedgwick County, Kansas and that the
accompanying plat is a true and correct exhibit
of the property surveyed described as follows:
The West 1/2 of the S.W. 1/4 of the S.E. 1/4 Sec. 16, T. 46 N., R. 12 E.

Know all men by these presents that we Elmer J. White and Sadie White (his wife) have caused the land described in the Surveyors certificate to be plotted into lots, blocks, streets and avenues to be known as CEDARVALE ACRES Sedgwick County, Kansas. Easements are hereby granted as indicated on the plat for the construction and maintenance of all public utilities. The streets and avenues are hereby dedicated to and for the use of the public.

The undersigned City Clerk, a person of the County of Sedgwick, State of Kansas, do hereby certify that on this 15th day of October 1932 before me a Notary Public in and for said County and State came Elmer J. White and Sadie White, his wife to me known to be the same persons who executed the foregoing instrument of writing and duly acknowledge the execution of the same as their voluntary act and deed. In testimony whereof I have hereunto set my hand and affixed my notarial seal the day and year above written.

Notary Public
My Commission Expires Sept. 5, 1933

This plat of CEDARVALE ACRES Sedgwick County, Kansas, has been submitted to and considered by the City Planning Commission of Wichita, Kansas and is hereby transmitted to the Board of City Commissioners with the recommendation that such plat be approved as proposed. Dated this 15th day of October 1932. The City Planning Commission of Wichita, Kansas.

Approved by the Board of Commissioners this 15th day of October 1932.
City Clerk.

Approved by the Board of Commissioners this 15th day of October 1932.
County Commissioners.
Entered on transfer record this 15th day of October 1932.
County Clerk.


State of Kansas } ss This is to certify that
Sedgwick County } this plat was filed for record in the office
of the Register of Deeds, this 15th day of
October 1932 at 12:00 o'clock P.M.
and is duly recorded.

We, The Division of Home Missions and Church Extension of the Board of Missions and Church Extensions of the Methodist Church Inc., do hereby certify that we are the owners of a certain mortgage from The Wichita Methodist City Union, Inc., secured by the above described property, known as CEDARVALE ACRES Sedgwick County, Kansas which mortgage was dated 10-23-1932 filed in book 111 page 21 of the mortgage record. Sedgwick County, Kansas and we do hereby consent to the dedication of the streets, avenues and easements as indicated on the plat for the construction and maintenance of public utilities.

Notary Public
My Commission Expires

State of Kansas } ss. Be it remembered that on this
15th day of October 1932 before me a Notary
Public in and for said County and State came
Elmer J. White and Sadie White, his wife
extension of the Board of Missions and Church
extension of the Methodist Church Inc., to me known
to be the same persons who executed the foregoing
instrument of writing and duly acknowledge the
execution of the same as their voluntary act and
deed. In testimony whereof I have hereunto set my
hand and affixed my notarial seal the day and
year above written.

Notary Public
My Commission Expires

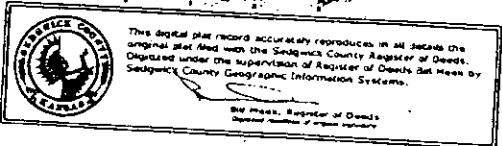

9007009-11

☐ = SITE

Film 439
Page 1408
Film 439
Page 1404

