


VAC2009-14

SWEETBRIAR ADDITION

AND REPLAT OF PART OF BENJAMIN HILLS SECOND ADDITION, TO WICHITA, SEDGWICK COUNTY, KANSAS.

STATE OF OKLAHOMA COUNTY OF ... Attest: My Commission Expires ...

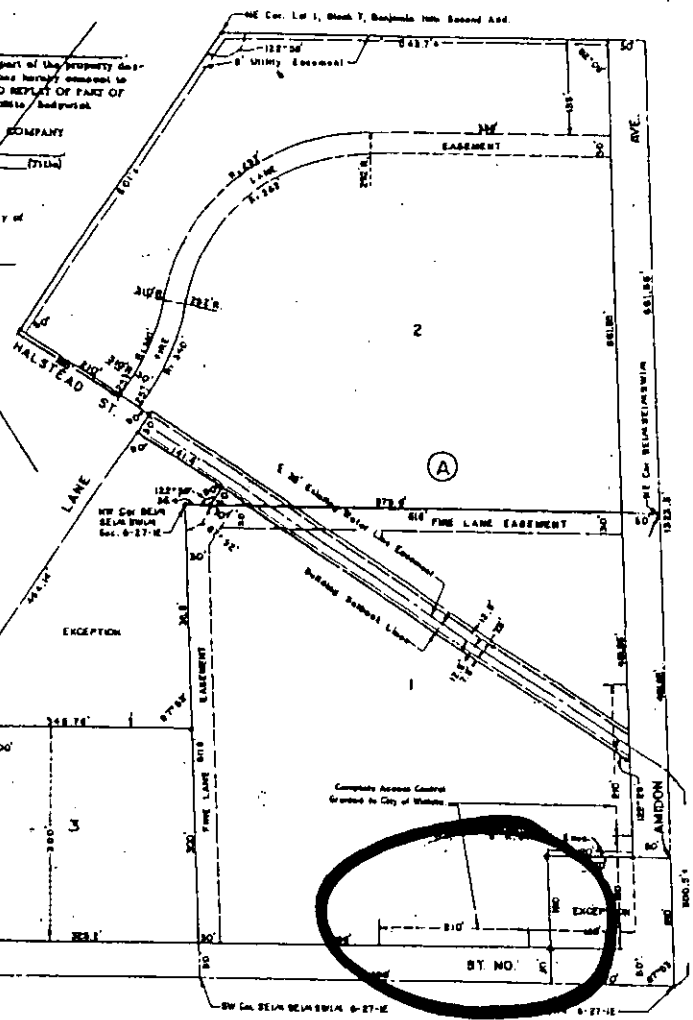

STATE OF KANSAS COUNTY OF SEDGWICK

I, Leonard O. Taylor, Civil Engineer in said state and county, do hereby certify that I have surveyed and plotted 'SWEETBRIAR ADDITION AND REPLAT OF PART OF BENJAMIN HILLS SECOND ADDITION'...

Leonard O. Taylor, Civil Engineer

Know all men by these presents that Sweetbriar Gardens, Inc., a corporation, by its president, E. A. McLean, and E. A. McLean, a single person, have owned the land described in the civil engineer's certificate to be platted into lots, a block, a street and an avenue...

Complete access control to Twenty-First Street North from that portion of Lot 1 in said Addition, extending from a point 180 feet north of the north line of Twenty-First Street North to a point 370 feet north of the north line of Twenty-First Street North...

ATTEST: George Stealing, Secretary; E. A. McLean, President

STATE OF KANSAS COUNTY OF SEDGWICK

It is remembered that on this 2nd day of June, 1965, before me, a Notary Public in and for said County and State, came E. A. McLean, a single person, as an individual, and E. A. McLean, President of Sweetbriar Gardens, Inc., a corporation...

My Commission Expires October 3, 1968. Signed: Notary Public

ATTEST: [Signature] Cashier; [Signature] Vice-President

STATE OF MISSOURI COUNTY OF JACKSON

It is remembered that on this 27th day of October, 1968, before me, the undersigned, a Notary Public in and for the County and State aforesaid, came Lloyd Trumbull, Vice-President of Peace Bank of Commerce, Kansas City, Missouri, a corporation...

My Commission Expires July 14, 1969. Signed: Notary Public

This plat of 'SWEETBRIAR ADDITION AND REPLAT OF PART OF BENJAMIN HILLS SECOND ADDITION'...

Approved by the Board of City Commissioners this 27th day of July, 1968. Signed: City Clerk

Approved by the Board of City Commissioners this 27th day of July, 1968. Signed: City Clerk

