




Savoy Company, P.A.
 433 S. Hydraulic
 Wichita, KS. 67211-1911

PH (316) 265-0005
 FAX (316) 265-0275
www.savoyco.com

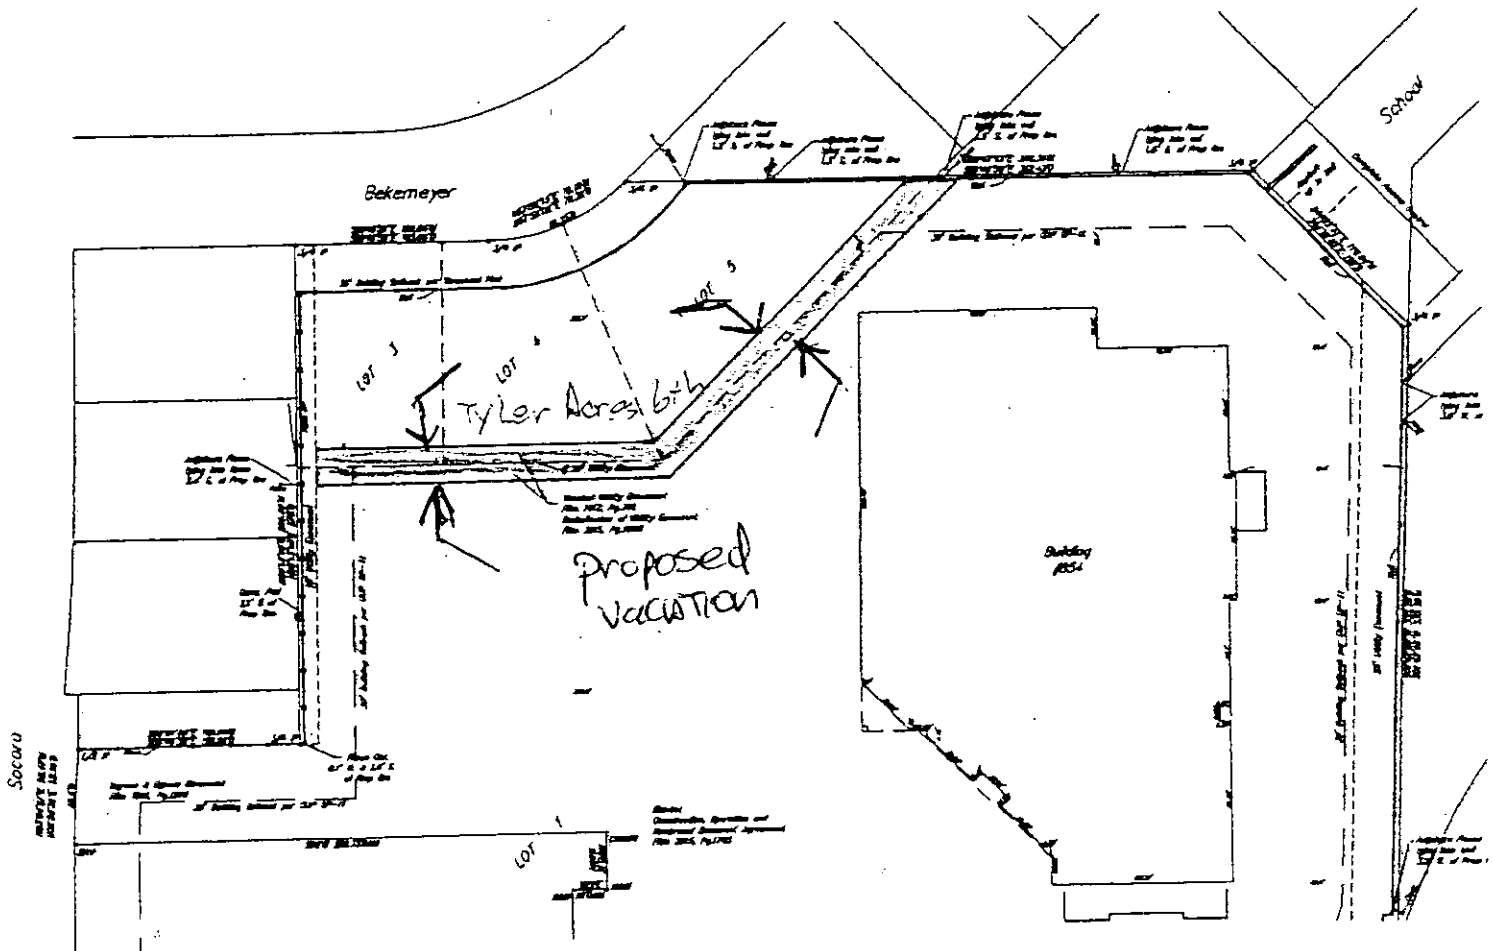

UAC2009-19