


VIA CHRISTI - WEST CAME
SEDGWICK COUNTY, KAN



Doc # /FL#-PG: 28012703
 Date: 10/10/2008
 Time: 10:50:08 AM

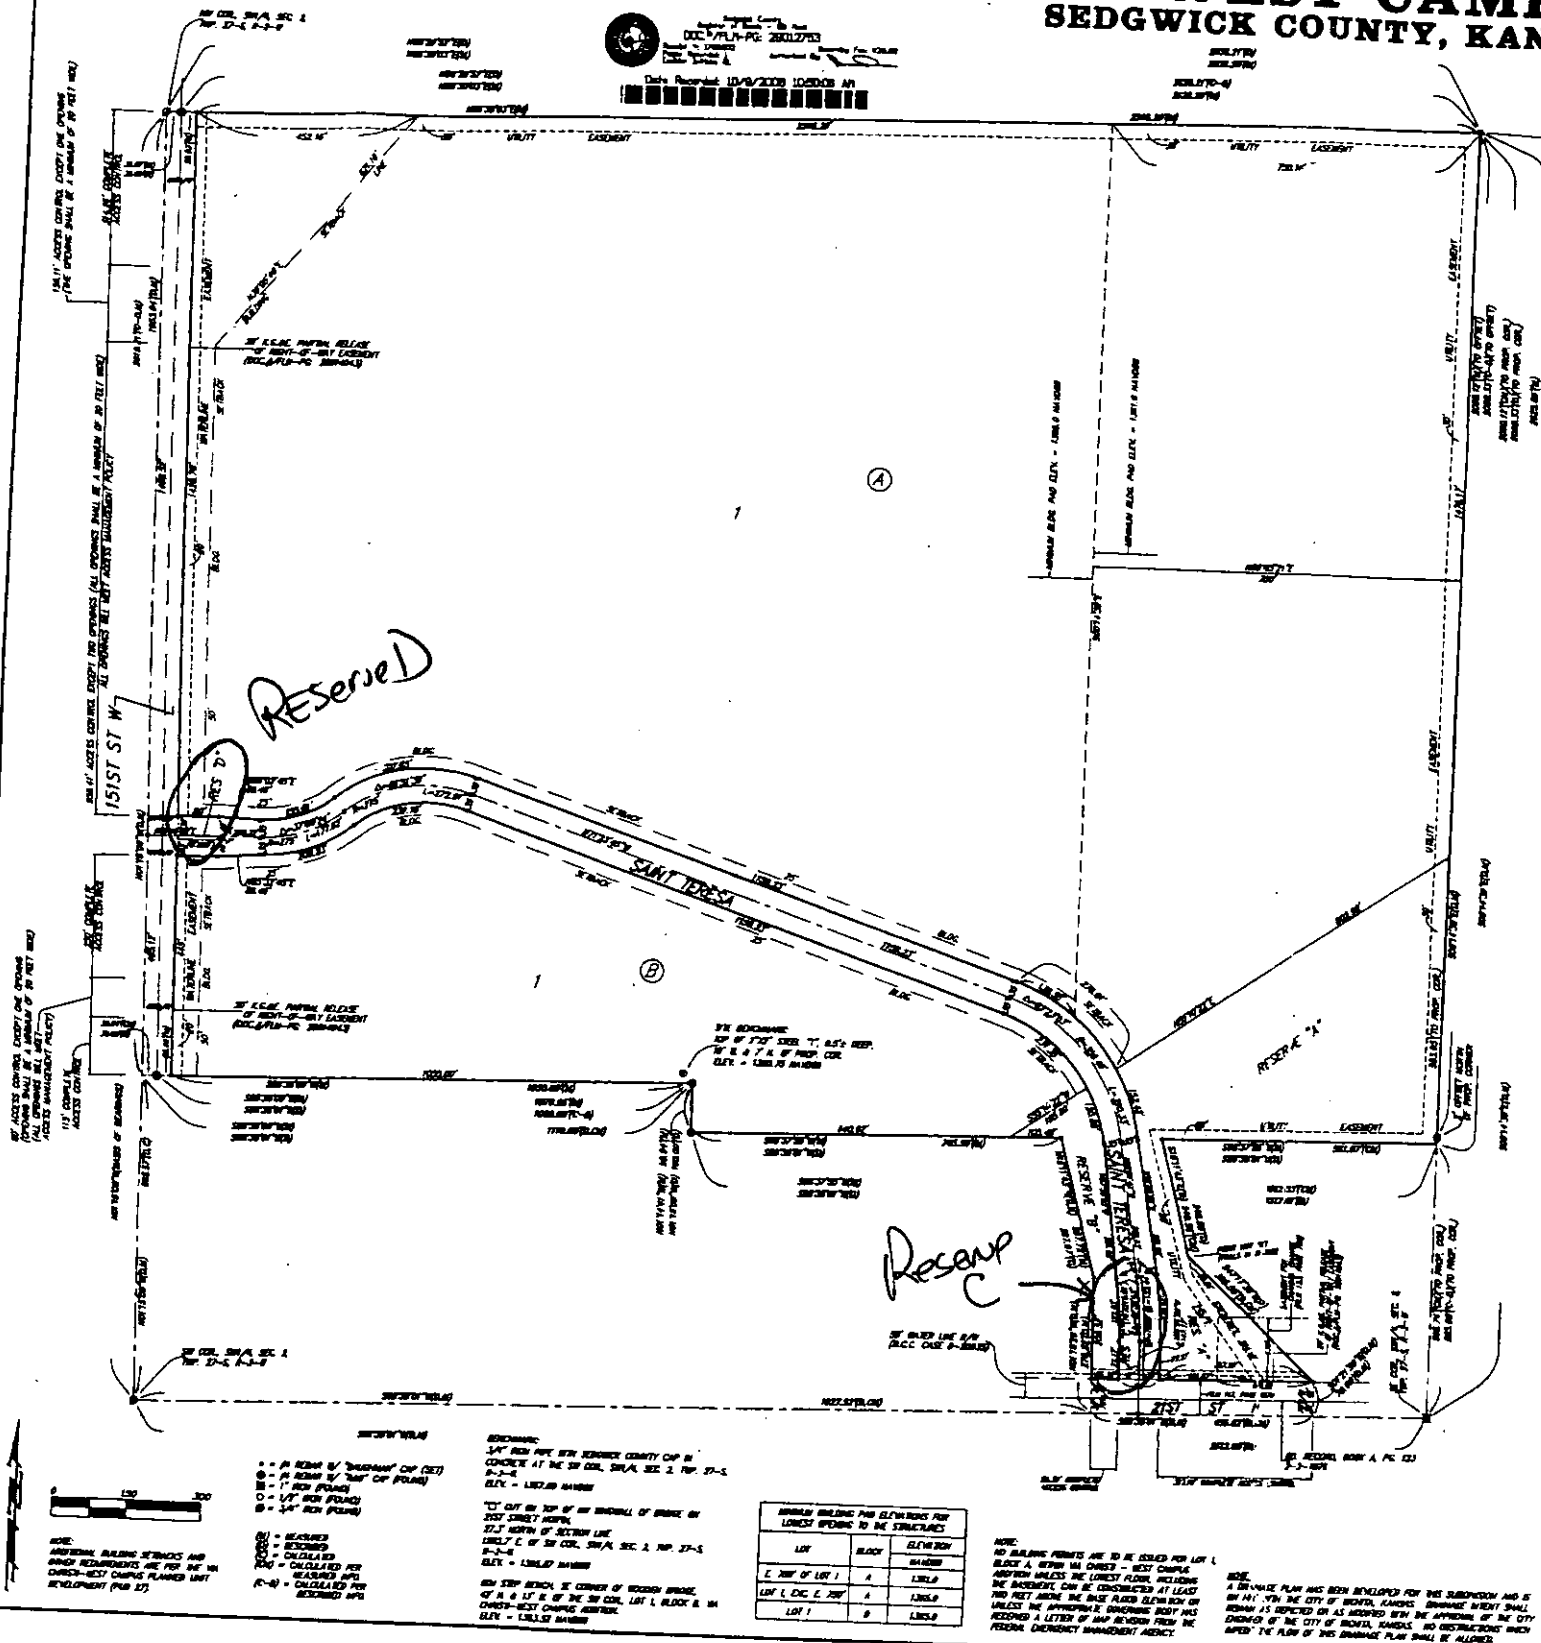

MINIMUM BUILDING PAD ELEVATIONS FOR LOWEST OPENING TO THE STRUCTURES		
LOT	BLOCK	ELEVATION
		MINIMUM
