





UNC2004-316

3H

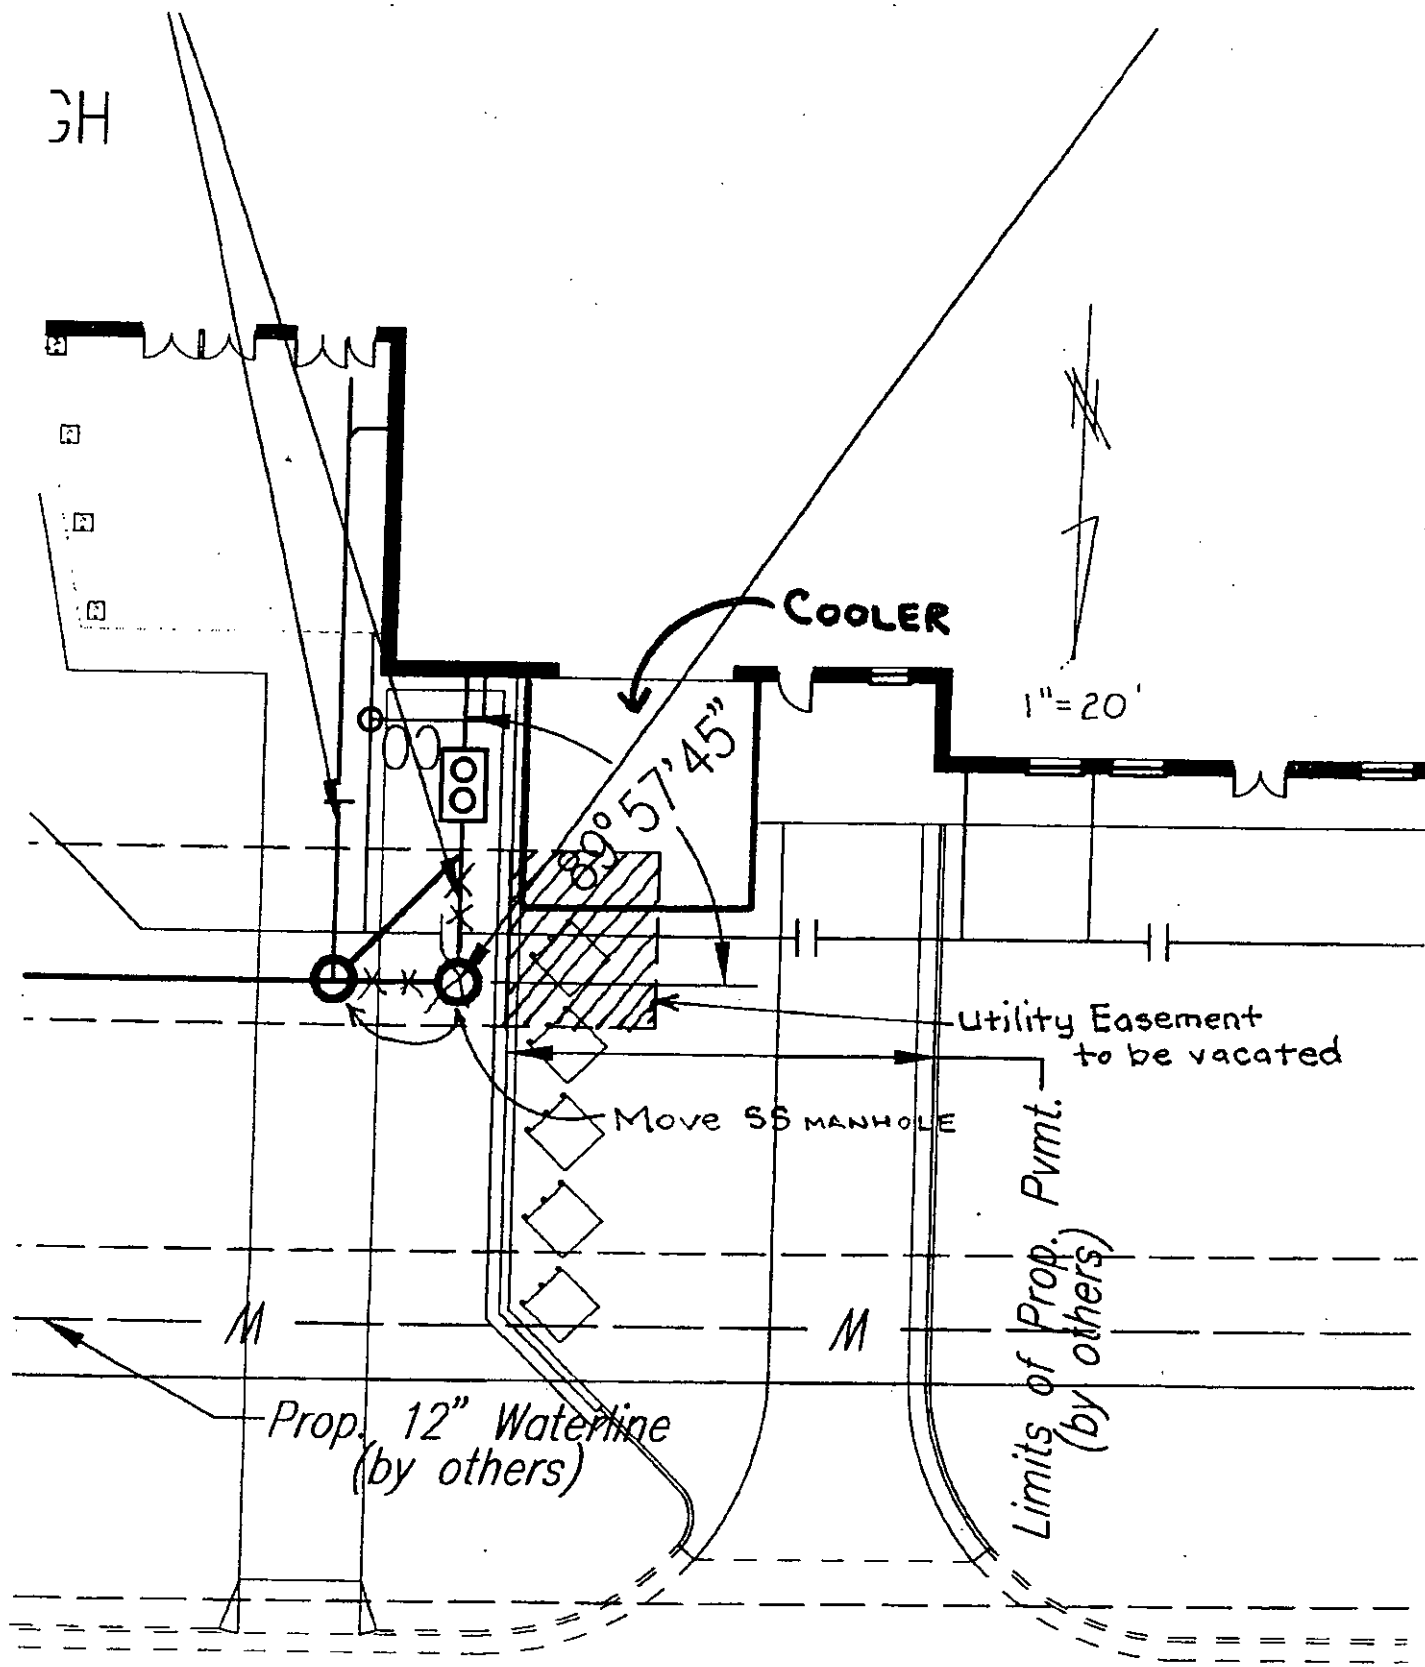

VAC2009-34