


EXHIBIT

PART OF WOODLAND HEIGHTS 2ND ADDITION

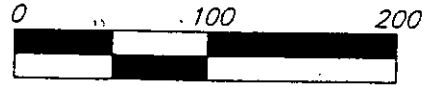

COMPLETE ACCESS CONTROL PER ORIGINAL PLAT OF WOODLAND HEIGHTS 2ND ADDITION PLAT

COMPLETE ACCESS CONTROL VACATED AND ONE POINT OF ACCESS GRANTED TO RIDGE ROAD, SAID POINT OF ACCESS TO ALIGN WITH BRUNSWICK AS LOCATED ON THE WEST SIDE OF RIDGE ROAD, (FILM 2048, PAGES 980 & 981)

40.01' ACCESS
OPENING

BRUNSWICK

60'R/W

CURB

CURB

RIDGE ROAD

60'R/W

CURB

CURB


10' STREET DEDICATION
(DOC. #/FLM-PC: 28680329)

410.08'

LOT

WOODLAND HEIGHTS

2ND ADD.

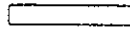

SHADE LANE

9 MAR 2010



Baughman Company, P.A.

315 Ellis St., Wichita, KS 67211 P 316-262-7271 F 316-262-0149

ENGINEERING | SURVEYING | PLANNING | LANDSCAPE ARCHITECTURE

C:\PLAT\WH2X.DWG-MCC