

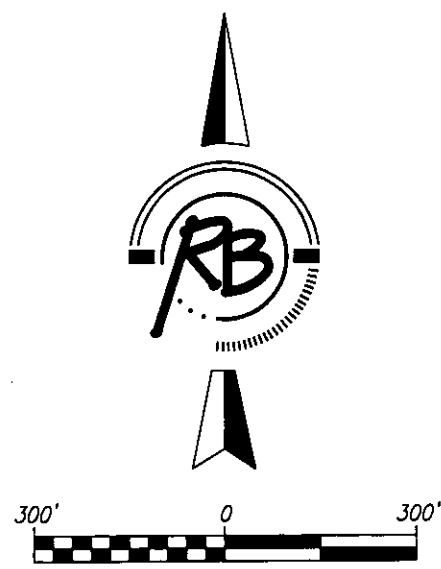


ACCESS CONTROL EXHIBIT

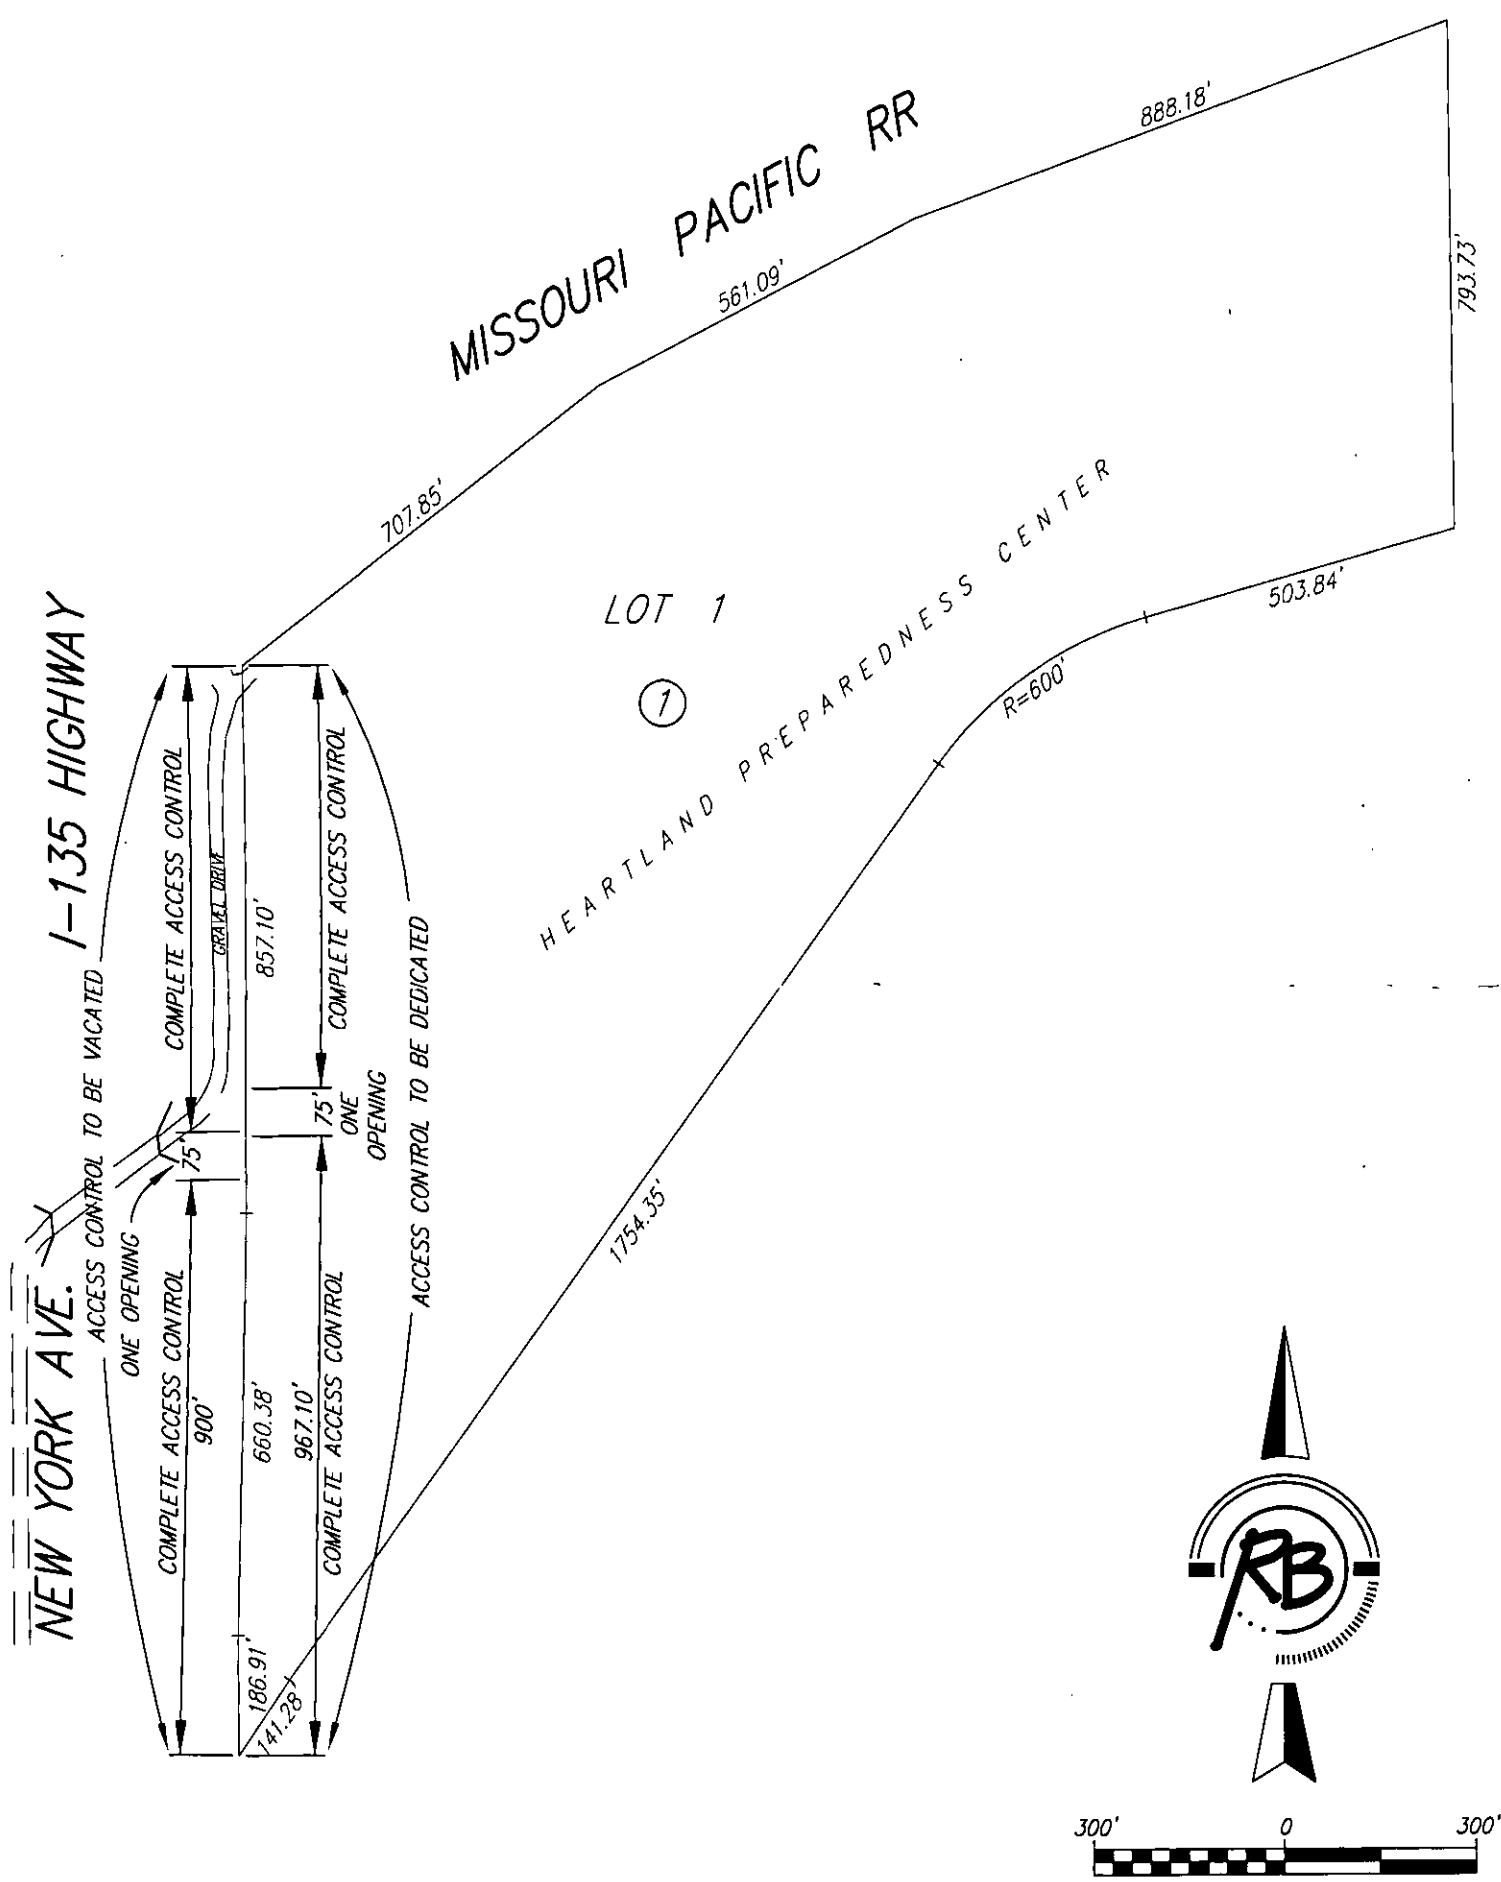

DWG FILE: SURVEY BASE
 PROJECT NO. 3606V
 APRIL 1, 2010

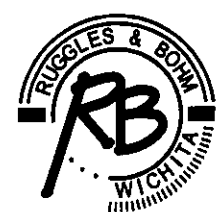

Ruggles & Bohm, F.A.
 Engineering, Surveying, Land Planning
 924 North Main (316) 264-8008
 Wichita, Kansas 67203 (316) 264-4621 fax
 www.rbkansas.com E-mail: info@rbkansas.com