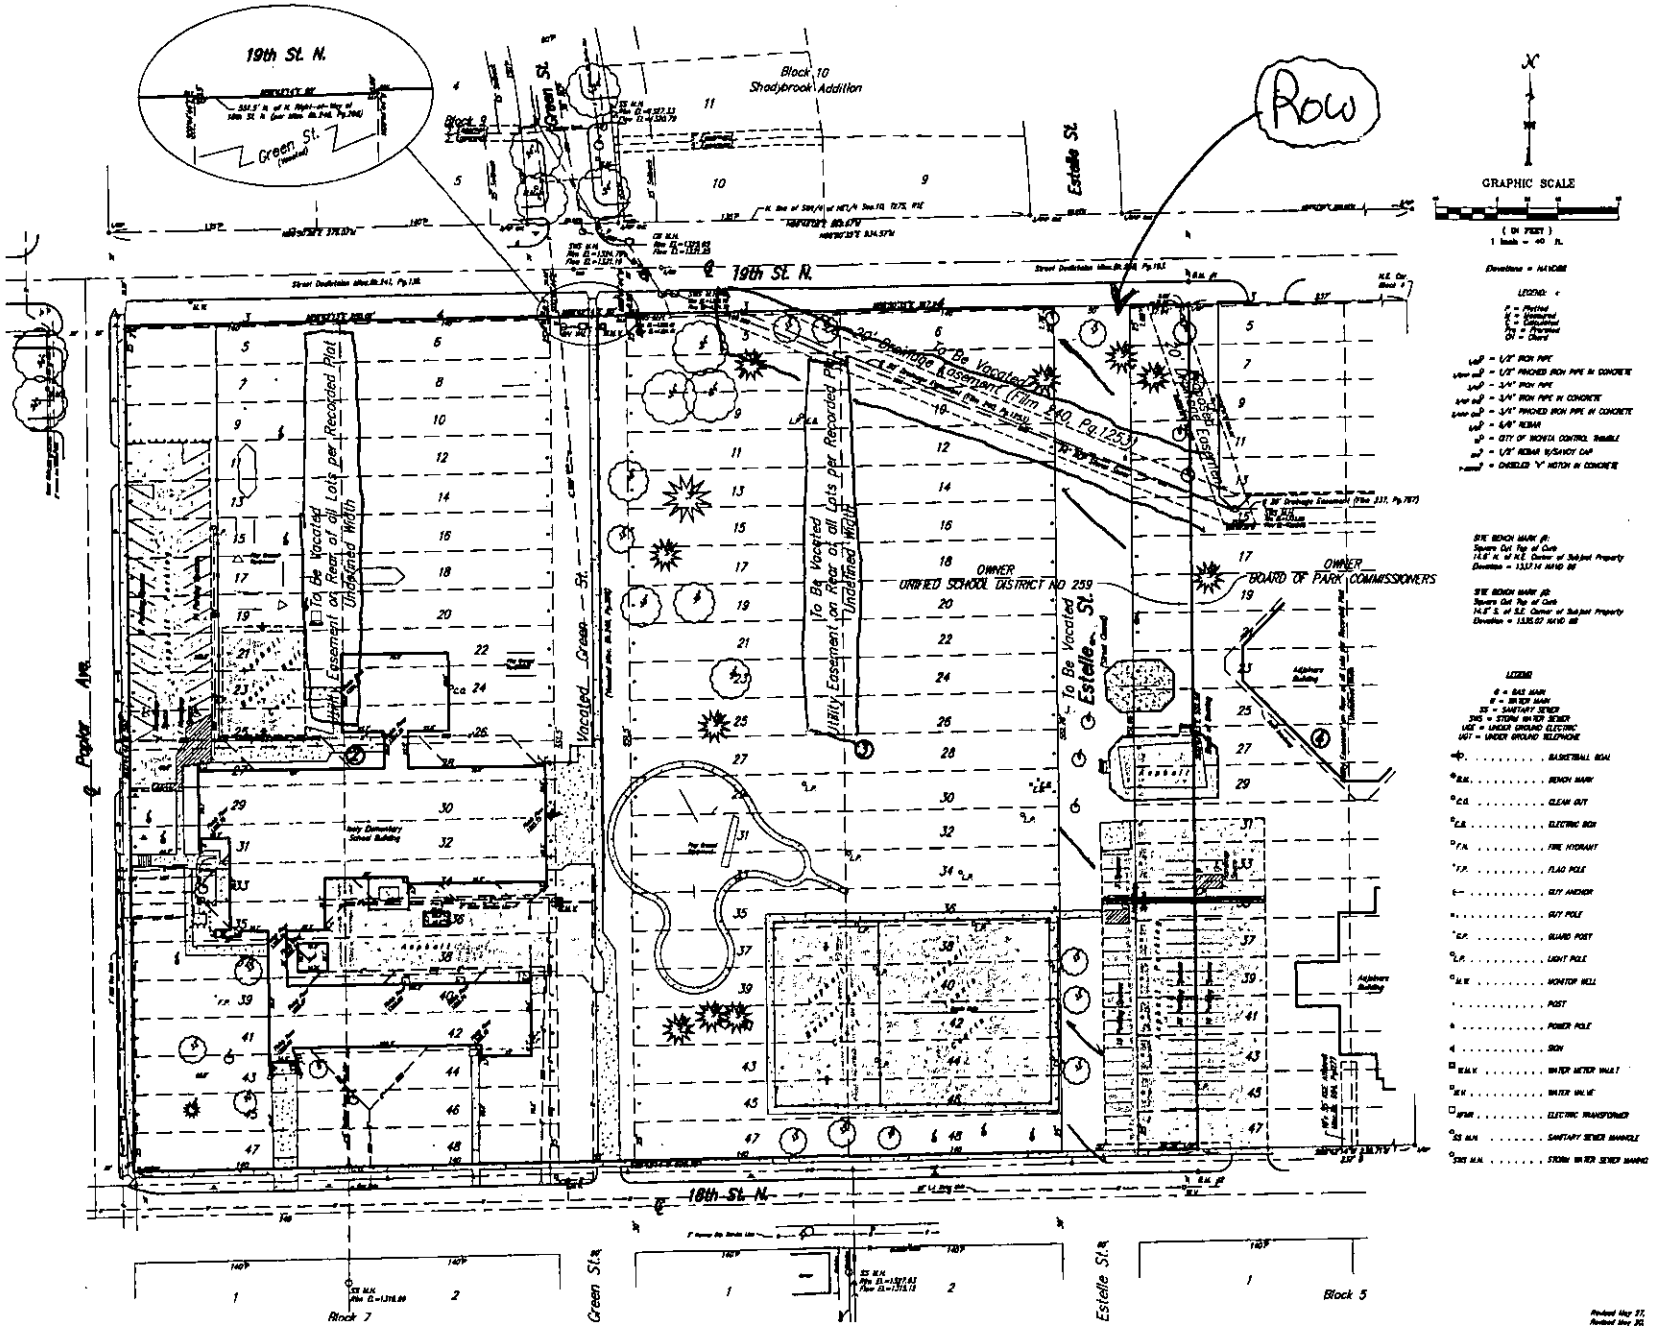
19th St. N.
Green St.
Block 10
Shadybrook Addition
Estelle St.
ROW
GRAPHIC SCALE
Poplar Ave.
To Be Vacated Utility Easement on Rear of all Lots per Recorded Plat Undefined Width
Vacated Green St.
To Be Vacated Utility Easement on Rear of all Lots per Recorded Plat Undefined Width
To Be Vacated Estelle St.
OWNER UNIFIED SCHOOL DISTRICT NO 259
OWNER BOARD OF PARK COMMISSIONERS
18th St. N.
Block 7
Green St.
Estelle St.
Block 5

VAC 2010-18