

OF 1/4TH STREET
N.D.


NW MAIN PUMP STATION

AN ADDITION TO WICHITA, SEDGWICK COUNTY, KAN

SCALE: 1" = 50'

• = 3/4" IRON PIPE W/PEC CAP UNLESS OTHERWISE NOTED

North 1/4 Corner,
Section 12, T27S, R2W
Found Iron Pipe in
Marble over Stone

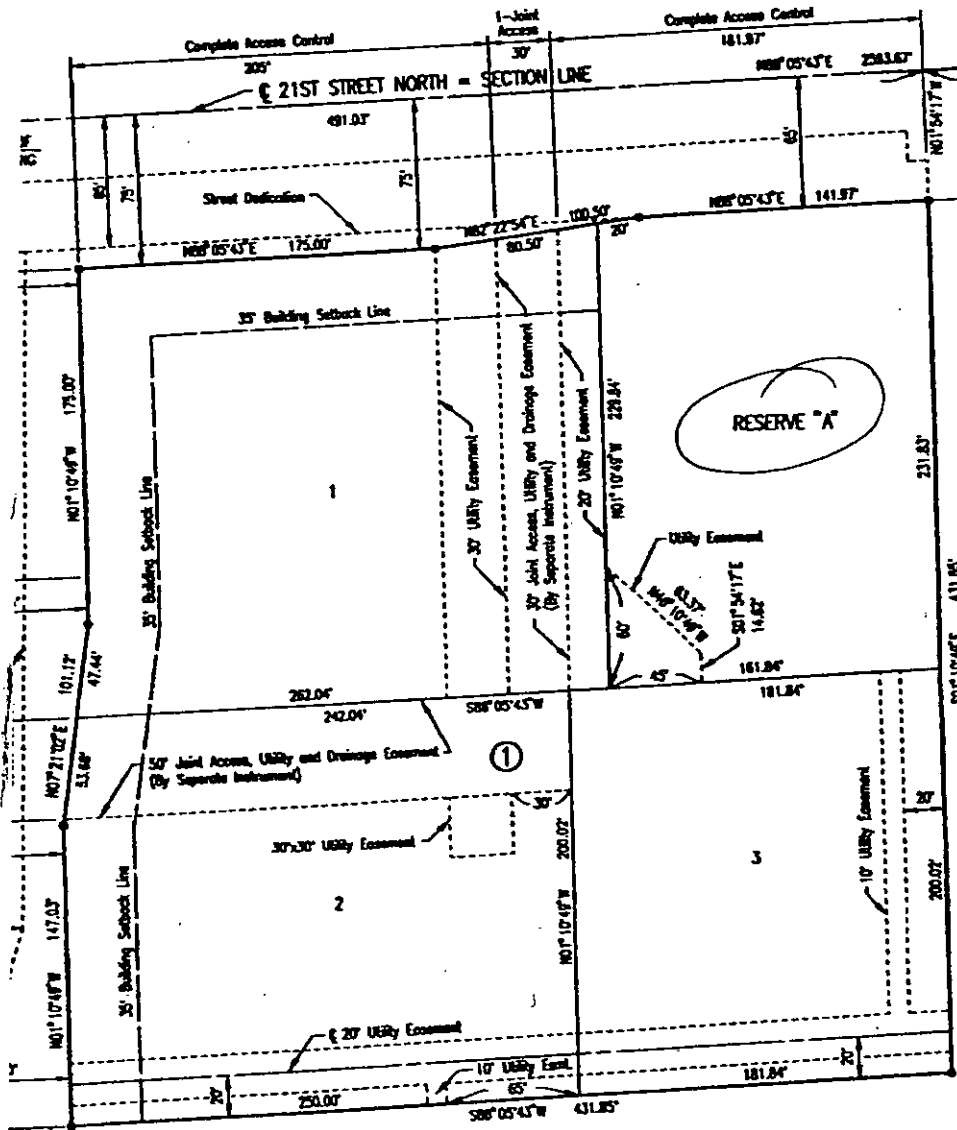

VAC 2010-19

STATE OF
COUNTY
WE, THE
SURRENDER
AND PLACE
INTO RECORD
A TRICK
EASE OF
THENCE
45.18 S
EXCEPT
A TRICK
NORTH OF
OF THE
FEET, 45.18
PUMP
EASE
400
TO A
SECTION