



VAC 2010-30

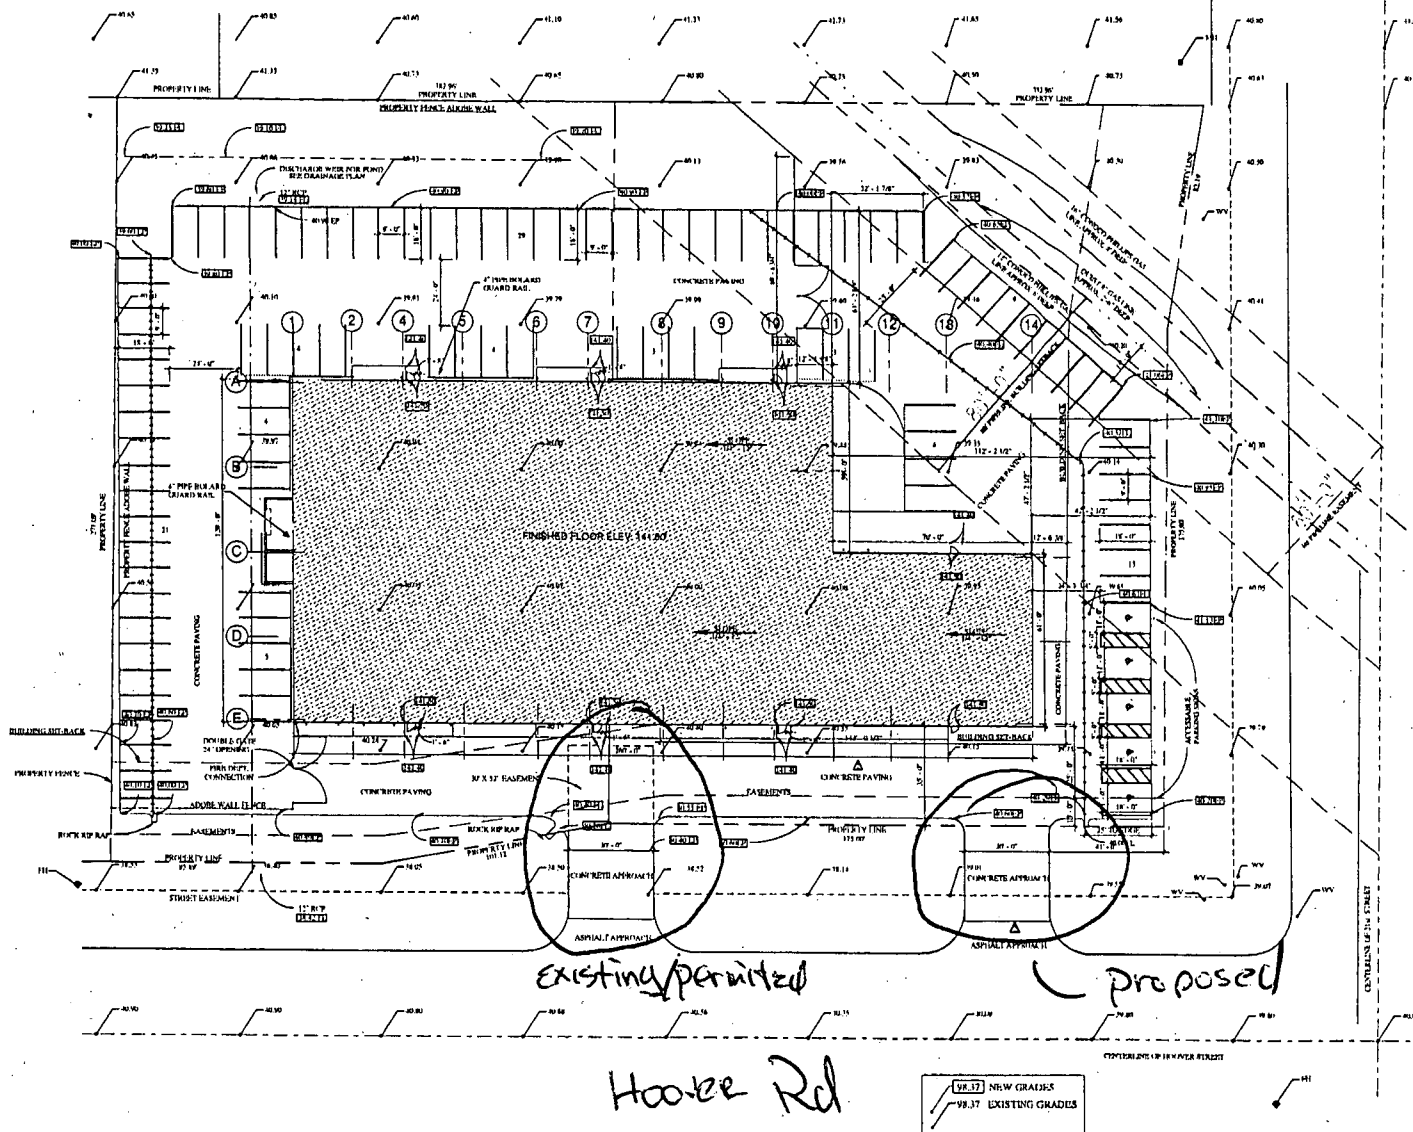

21st St N

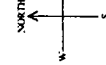



EVANS BUILDING CO. INC.
9901 W. YORK
WICHITA, KANSAS 67277

A NEW BUILDING FOR
AUTOMASTERS

WICHITA, KS

2222 N. HOOVER RD.

PROPERTY
WICHITA CITY LICENSE NO. 28
Subdiv. Co. License No. 1000



WOLF ASSOCIATES
ARCHITECTURE


DATE: 04/10/10
DR. BY: EFL
CK. BY: Checker

PROJECT NO.
10-108

SHEET
SA1.1

PC129-7

20.00
D

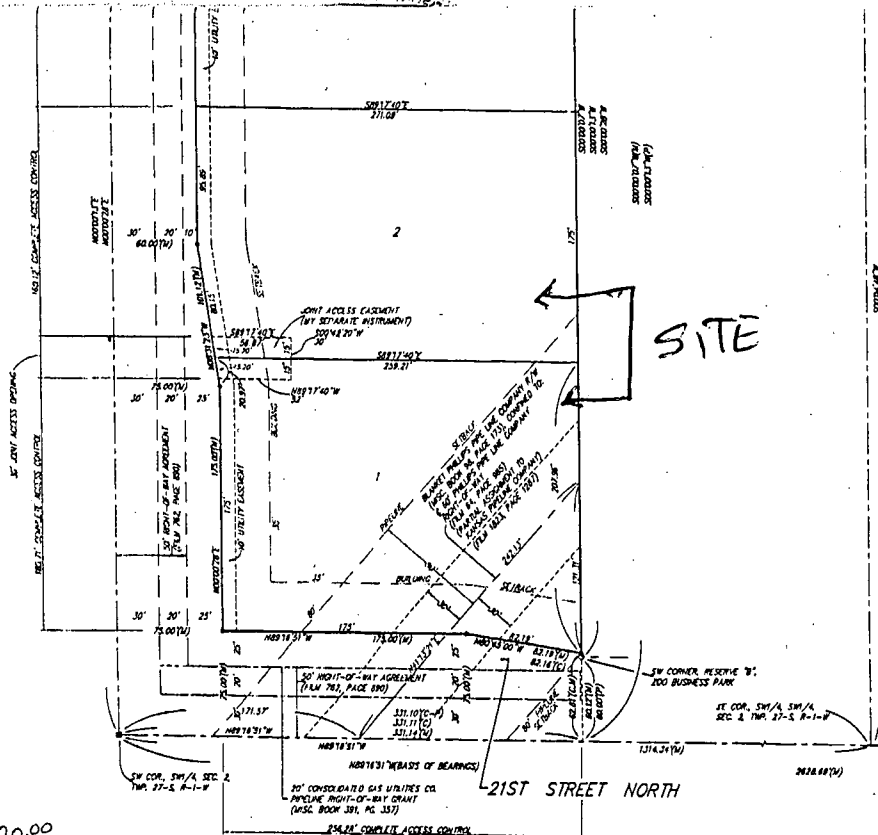

this plat approved and all calculations shown hereon accepted by the City Council of the City of Wichita, Kansas, this 19 day of AUGUST, 2001.

At the direction of the City Council



[Signature] City Manager
Chris Cherches

[Signature] City Clerk
Pat Burnett

Reviewed in accordance with K.S.A. 58-2005 on this 24th day of June, 2001.

[Signature]
Tricia L. Robello, L.S. #1246
Deputy County Surveyor
Sedgwick County, Kansas



Entered on transfer record this 23rd day of August, 2001.

[Signature] County Clerk
Don Brace

State of Kansas) ss This is to certify that this plat has been
Sedgwick County) filed for record in the office of the Register of Deeds, this 24th day
of August, 2001 at 5:04 o'clock A.M. and is duly recorded.



[Signature] Register of Deeds
Bill Meek

[Signature] Deputy
Linda Kizzire

#2004039



BAUGHMAN COMPANY P. A.
ENGINEERING, SURVEYING & PLANNING

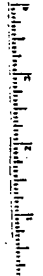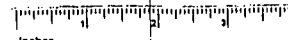

This digital plat record accurately reproduces in all details the original plat filed with the Sedgwick County Register of Deeds. Digitized under the supervision of Register of Deeds Bill Meek by Sedgwick County Geographic Information Systems.

Bill Meek, Register of Deeds
Digitized version of original signature