




VAC2010-37

water & sewer

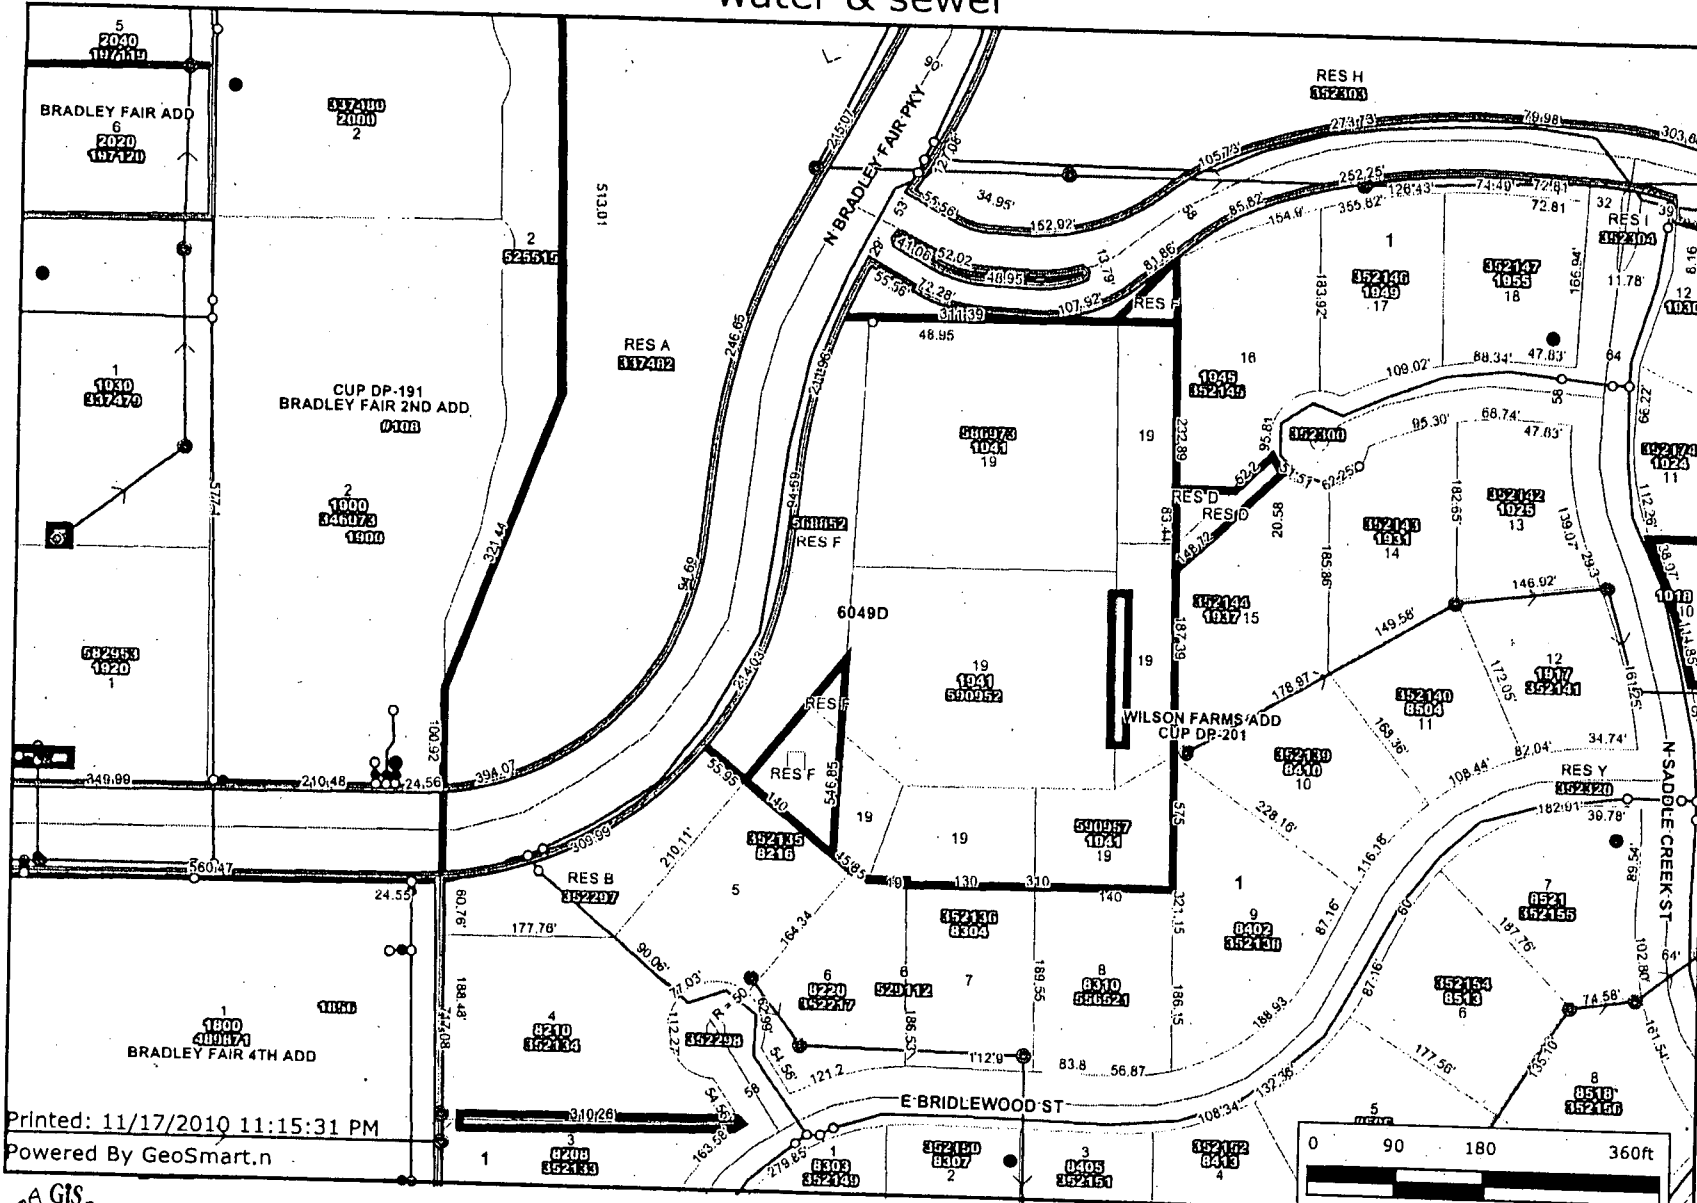


- McConnell AOI
- Sewer Manholes
- Sewer Observation Manholes
- Hydrant Schematic
- Water Valve Schematic
- Water Node Schematic
- City Limit Boundaries
- Historic Districts
- Old Town Delano Overlay District
- NO
- YES
- Property Parcels
- Lot Block
- Subdivisions
- Sewer Flow
- Sewer Lines
- Water Lines Schematic
- Roads
 - State Highway
 - US Federal Highway
 - Interstate
 - KTA
 - Arterial
 - Collector
 - Minor
 - Ramp
- Railroads
- Quarter Section
- Waterways

Printed: 11/17/2010 11:15:31 PM
Powered By GeoSmart.n



Every reasonable effort has been made to assure the accuracy of the maps and associated data provided herein. This information is provided with the understanding that the data are susceptible to a degree of error, and conclusions drawn from such information are the responsibility of the reader. The City of Wichita makes no warranty, representation or guaranty as to the content, accuracy, timeliness or completeness of any of the data provided herein. Some data provided here and used for the preparation of these maps has been obtained from public records not created or maintained by the City of Wichita. The City of Wichita shall assume no liability for any decisions made or actions taken or not taken by the reader in reliance upon any information or data furnished hereunder. The user should consult with the appropriate departmental staff member, e.g. Planning, Parks & Recreation, etc. to confirm the accuracy of information appearing in the visual presentations accessible through these web pages.




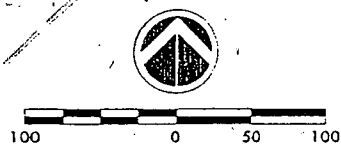

LEGEND

- = Fence
- = Storm sewer
- G — = Gas line
- UGE — = Underground electric
- UGT — = Underground teleco
- = Sanitary sewer
- W — = Water line
- FH — = Fire Hydrant
- WV — = Water Valve
- SSMH — = Sanitary sewer manhole

ZONED: "CUP DP-191"

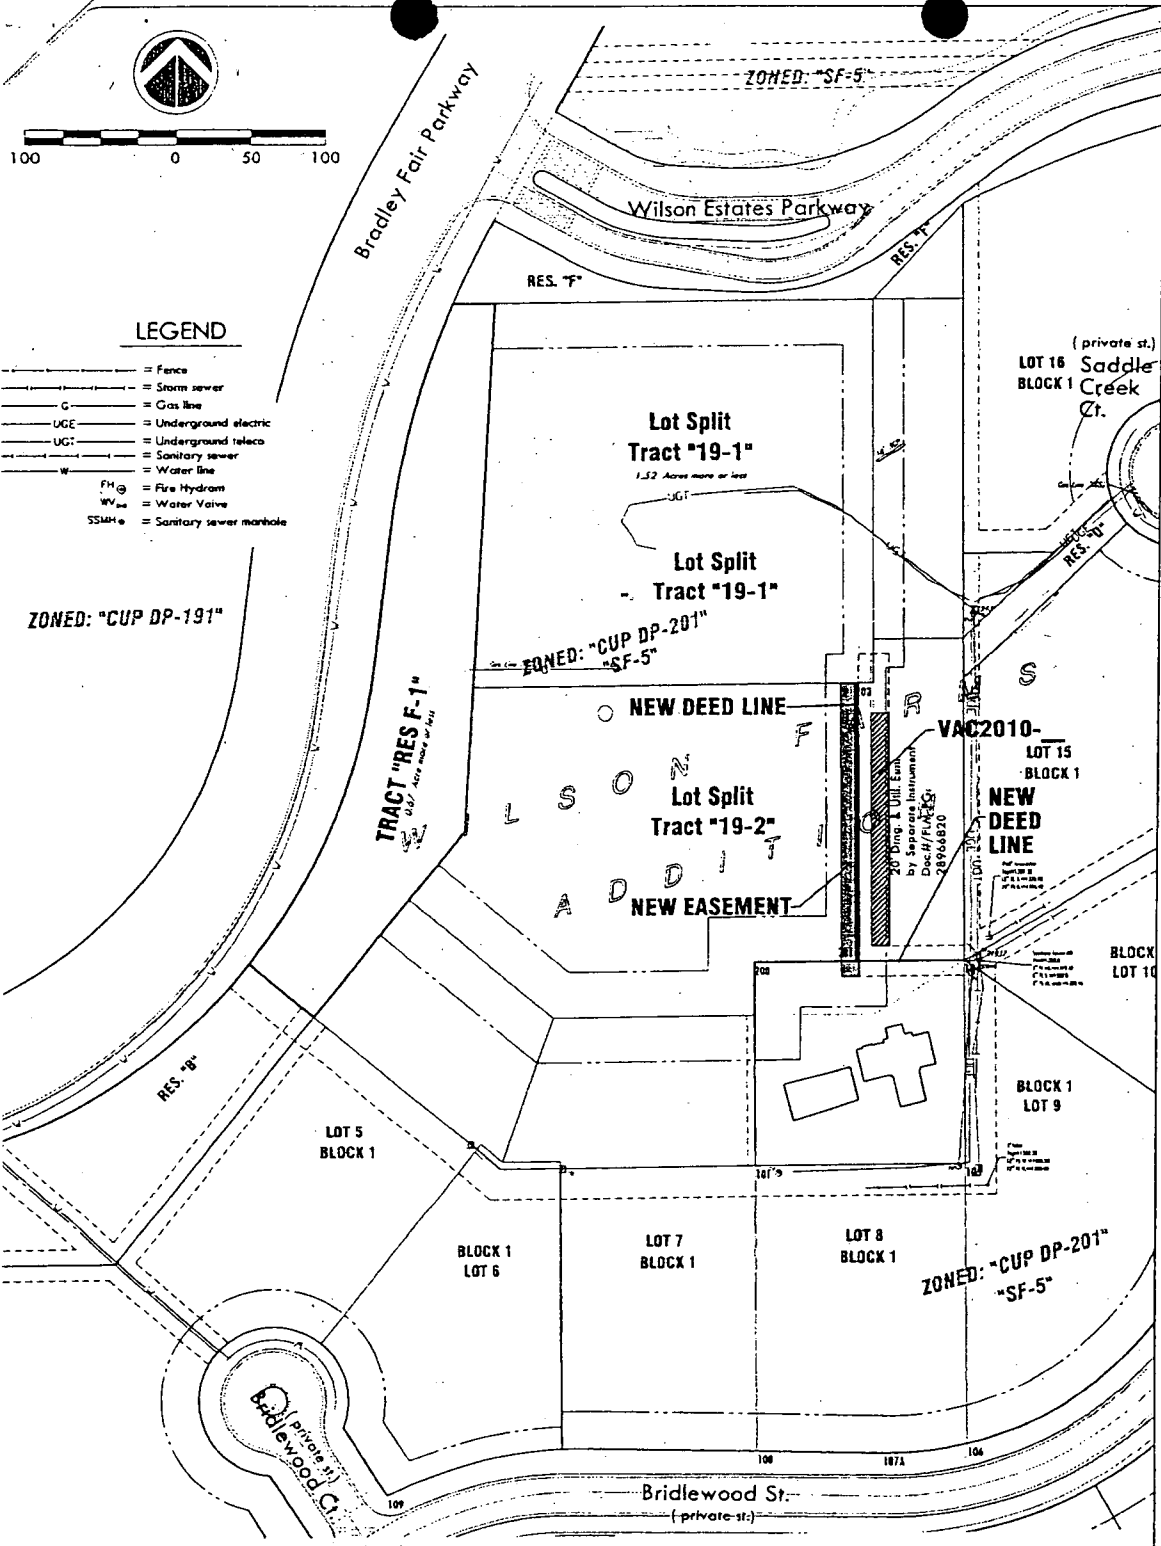

6/6/2008
Lot split SVB2008-30

RECORDED 7-15-1997		
WILSON FARMS ADDITION		
PROJECT NAME		
VACATION CASE EXHIBIT		
DRAINAGE & UTILITY EASEMENT		
SHEET TITLE		
BDL	BDL	CLM
DESIGN BY:	DRAWN BY:	CHECKED BY:
411 N. WEBB ROAD		
WICHITA, KS. 67206		
316-684-9600		
OCT. 2010	07653	1 / 2

\\dm\server\planning\top\01534.dwg 1/1/2008 11:38:11 AM COT