




Savoy Company, P.A.

433 S. Hydraulic
Wichita, KS 67211-1911

PH (316) 265-0005
FAX (316) 265-0275
www.savoyco.com

Page 2 of 3

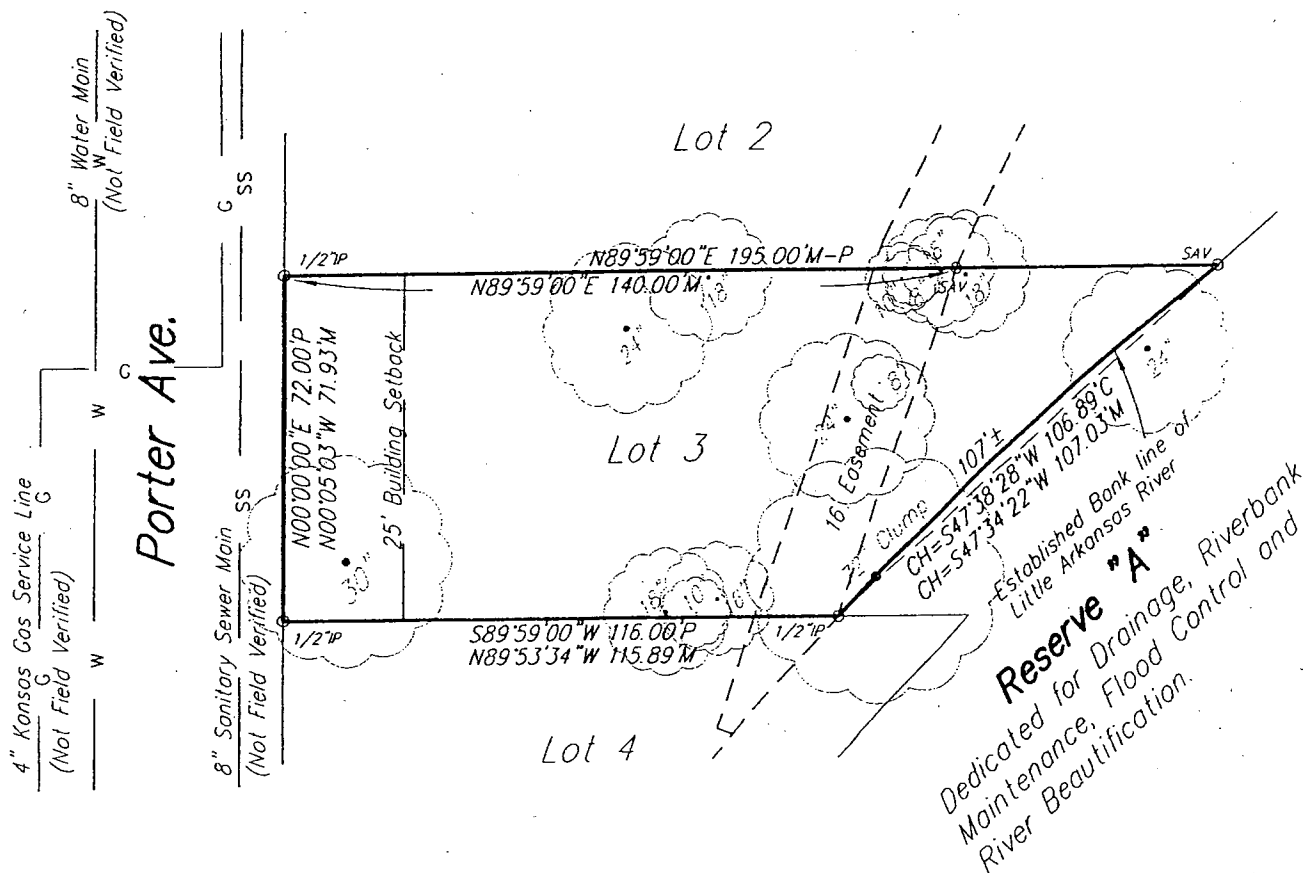

1" = 40'

PROJECT NO. 11GG12413 B

LEGEND:

G = GAS MAIN
W = WATER MAIN
SS = SANITARY SEWER

P = Plotted
M = Measured
C = Calculated
CH = Chord

- 1/2" IP 1/2" IRON PIPE (FOUND)
- 3/4" IP 3/4" IRON PIPE (FOUND)
- SAV 1/2" REBAR W/SAVOY CAP (SET)




Savoy Company, P.A.

433 S. Hydraulic
Wichita, KS 67211-1911

PH (316) 265-0005
FAX (316) 265-0275
www.savoyco.com

Page 3 of 3

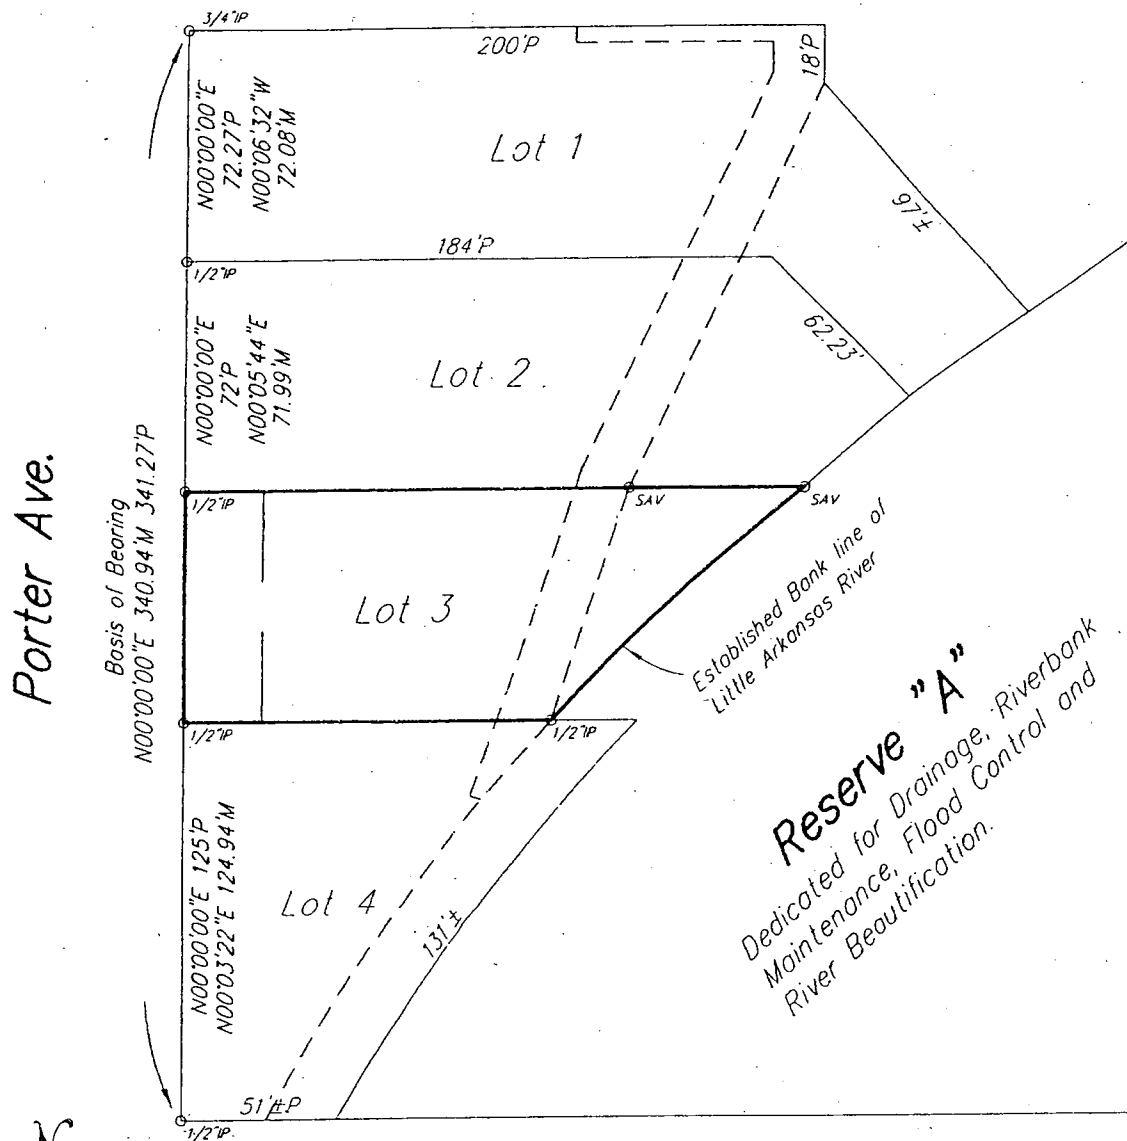

1" = 60'

PROJECT NO. 116612+13 B


P = Plotted
M = Measured
C = Calculated
CH = Chord

- ° 1/2" IP 1/2" IRON PIPE (FOUND)
- ° 3/4" IP 3/4" IRON PIPE (FOUND)
- ° SAV 1/2" REBAR W/SAVOY CAP (SET)



VAC2011-25

water, sewer, & stormwater

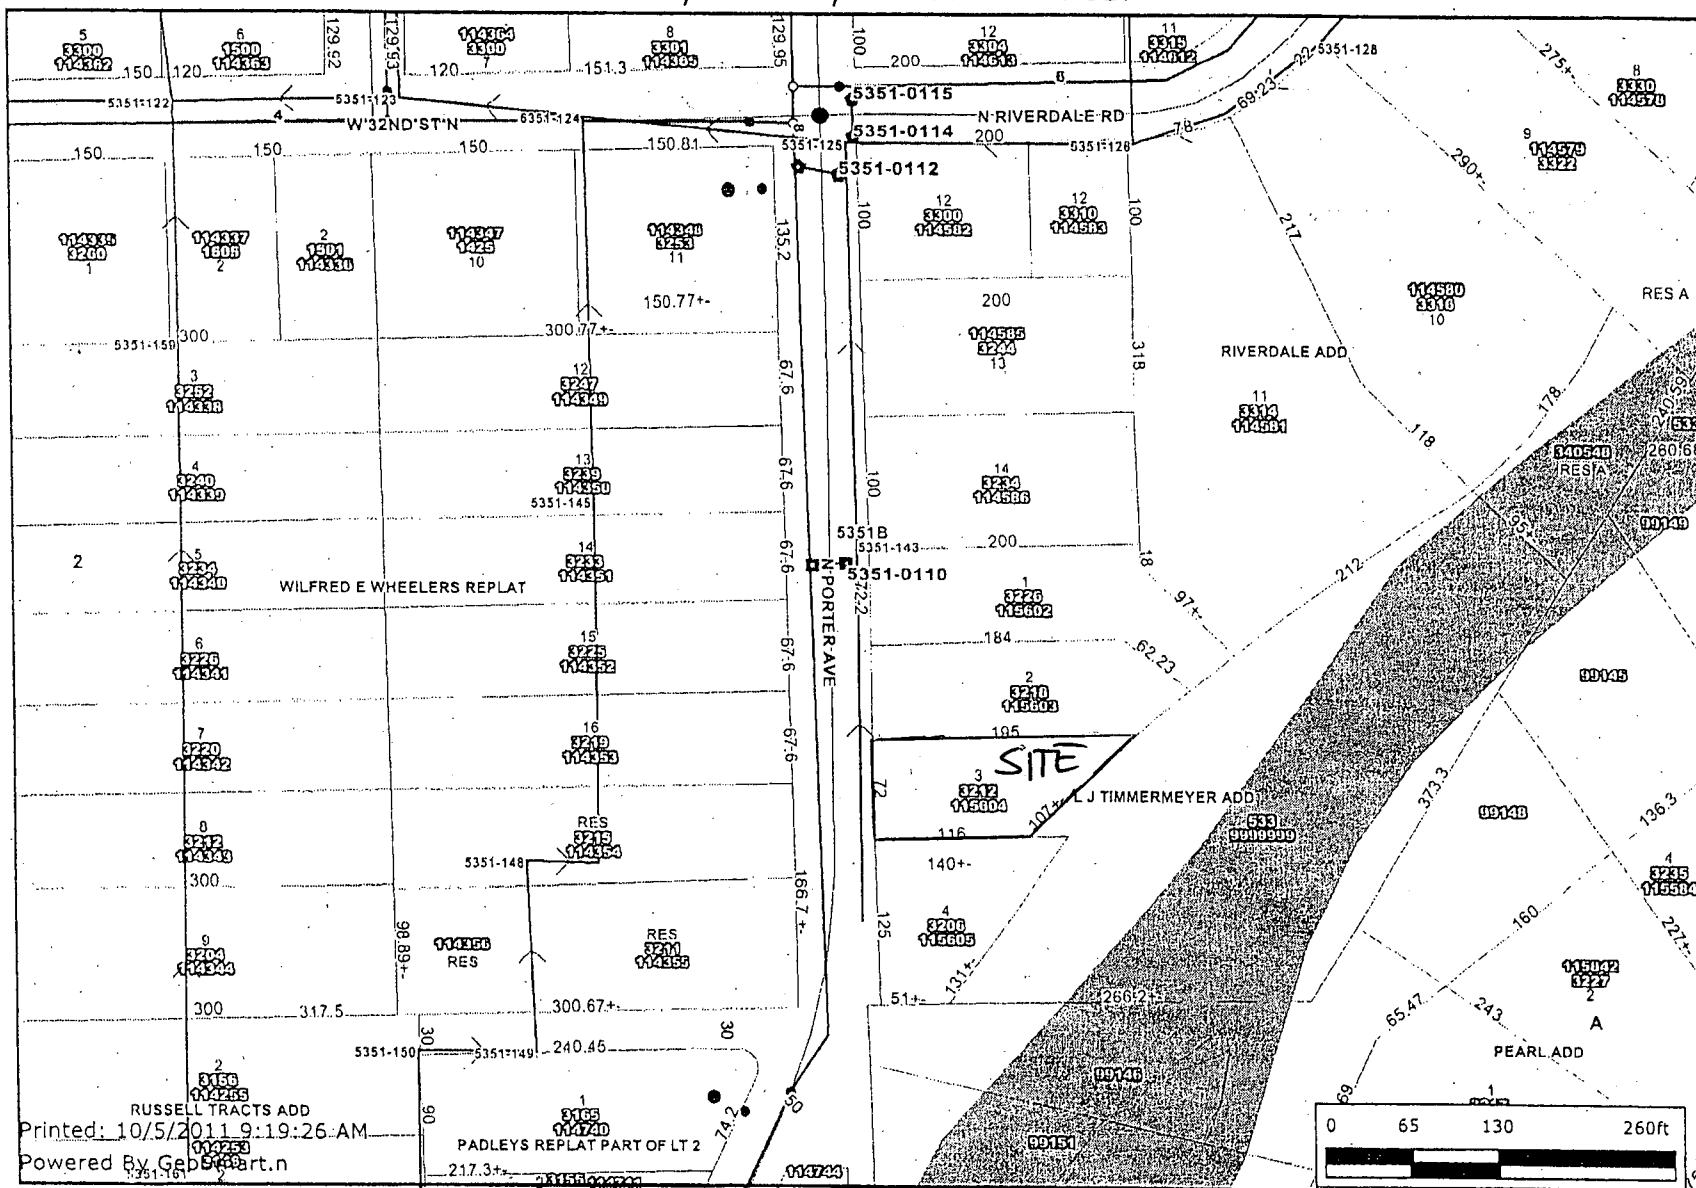

Label Structure
Addresses

Label Address

Label Control
Number

Label SubDiv
Lot Num

Label SubDiv
Block Num

Label SubDiv

Label Street
Vacation

Label Road
Dimension

Label Court
Radius

Label Lot
Parcel
Dimension

Label Lot
Dimension

Label Sewer
Manholes

Public
Wellheads

Hydrant
Schematic

Water Valve
Schematic

Water Node
Schematic

Storm Conduit

Storm
Structures

Inlet

Manhole

Outfall

Toe Drain

Relief Well

Other

WATER APPLI-
CATIONS

Printed: 10/5/2011 9:19:26 AM

Powered By GeoPart.n



Every reasonable effort has been made to assure the accuracy of the maps and associated data provided herein. This information is provided with the understanding that the data are susceptible to a degree of error, and conclusions drawn from such information are the responsibility of the reader. The City of Wichita makes no warranty, representation or guaranty as to the content, accuracy, timeliness or completeness of any of the data provided herein. Some data provided here and used for the preparation of these maps has been obtained from public records not created or maintained by the City of Wichita. The City of Wichita shall assume no liability for any decisions made or actions taken or not taken by the reader in reliance upon any information or data furnished hereunder. The user should consult with the appropriate departmental staff member, e.g. Planning, Parks & Recreation, etc. to confirm the accuracy of information appearing in the visual presentations accessible through these web pages.

