


LEGAL DESCRIPTION:

LOT 8, BLOCK F, PROSPECT PARK ADDITION, SEDGWICK CO., KS.

35TH STREET SOUTH

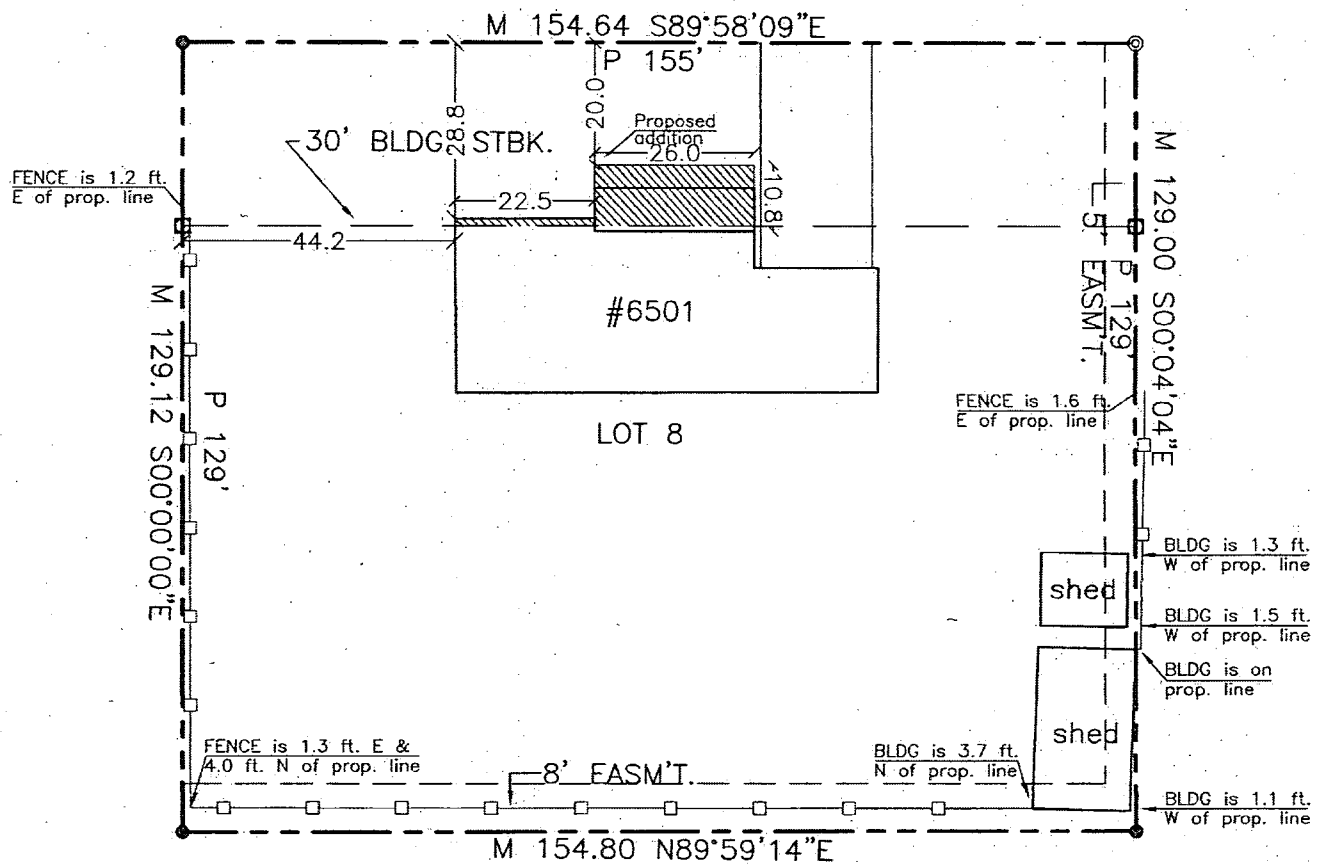

- - "Armstrong" capped rebar set
- ⊙ - "Baughman" capped rebar found
- - hub set on 30' setback line
- M - measured distance
- P - plat distance



SCALE 1"=30'