

ALTA/MCSM Land Title Survey
Larksfeld Place

**SURVEYOR'S CERTIFICATE
TO ALL PARTIES INTERESTED IN TITLE TO THE
PREMISES SURVEYED**

LEGAL DESCRIPTION

Lot 3, and 4, Block 1, west one half, into
 Addition, on Addition to Wichita, Sedgewick County,
 Kansas.
 Parcel #2: Lot 1, and Reserve A, and Reserve B, in Block 1,
 Wichita, Sedgewick County, Kansas.
 Parcel #4: Reserve A, Convictors Retirement Center Addition,
 on Addition to Wichita, Sedgewick County, Kansas.

State of Kansas)
) ss
 County of Sedgewick)


We, Baughman Company, P.A., Surveyors in aforesaid county and state do hereby certify to the aforesaid parties, that under the supervision of the undersigned, we did on this 20th day of September, 2008, perform a survey of the above described property:

This drawing is a true and correct exhibit of said survey based on actual measurements where the monuments are of the character and occupy the positions as indicated.

This is exactly what this map is for and the survey on which it is based were made in accordance with "Minimum Standard Data Requirements for ALTA/ACSM Land Surveys", jointly established and adopted by ALTA and NCS in 2003, and includes Items 1, 2, 3, 4, 5, 7(a), 8, 9, 10, 11(e), 13, of Table A thereof. Pursuant to the Accuracy Standards as adopted by ALTA and NCS and in effect on the date of this certification, undersigned further certifies that in my professional opinion, as a land surveyor registered in the state of Kansas, the Relative Horizontal Accuracy of this survey does not exceed that which is specified therein.

This document should contain an original, stamped seal and a surrogate signature in blue ink. If it does not, it is a copy, should be assumed to contain information different. The certification on this document shall not apply to any copies.

385
Date

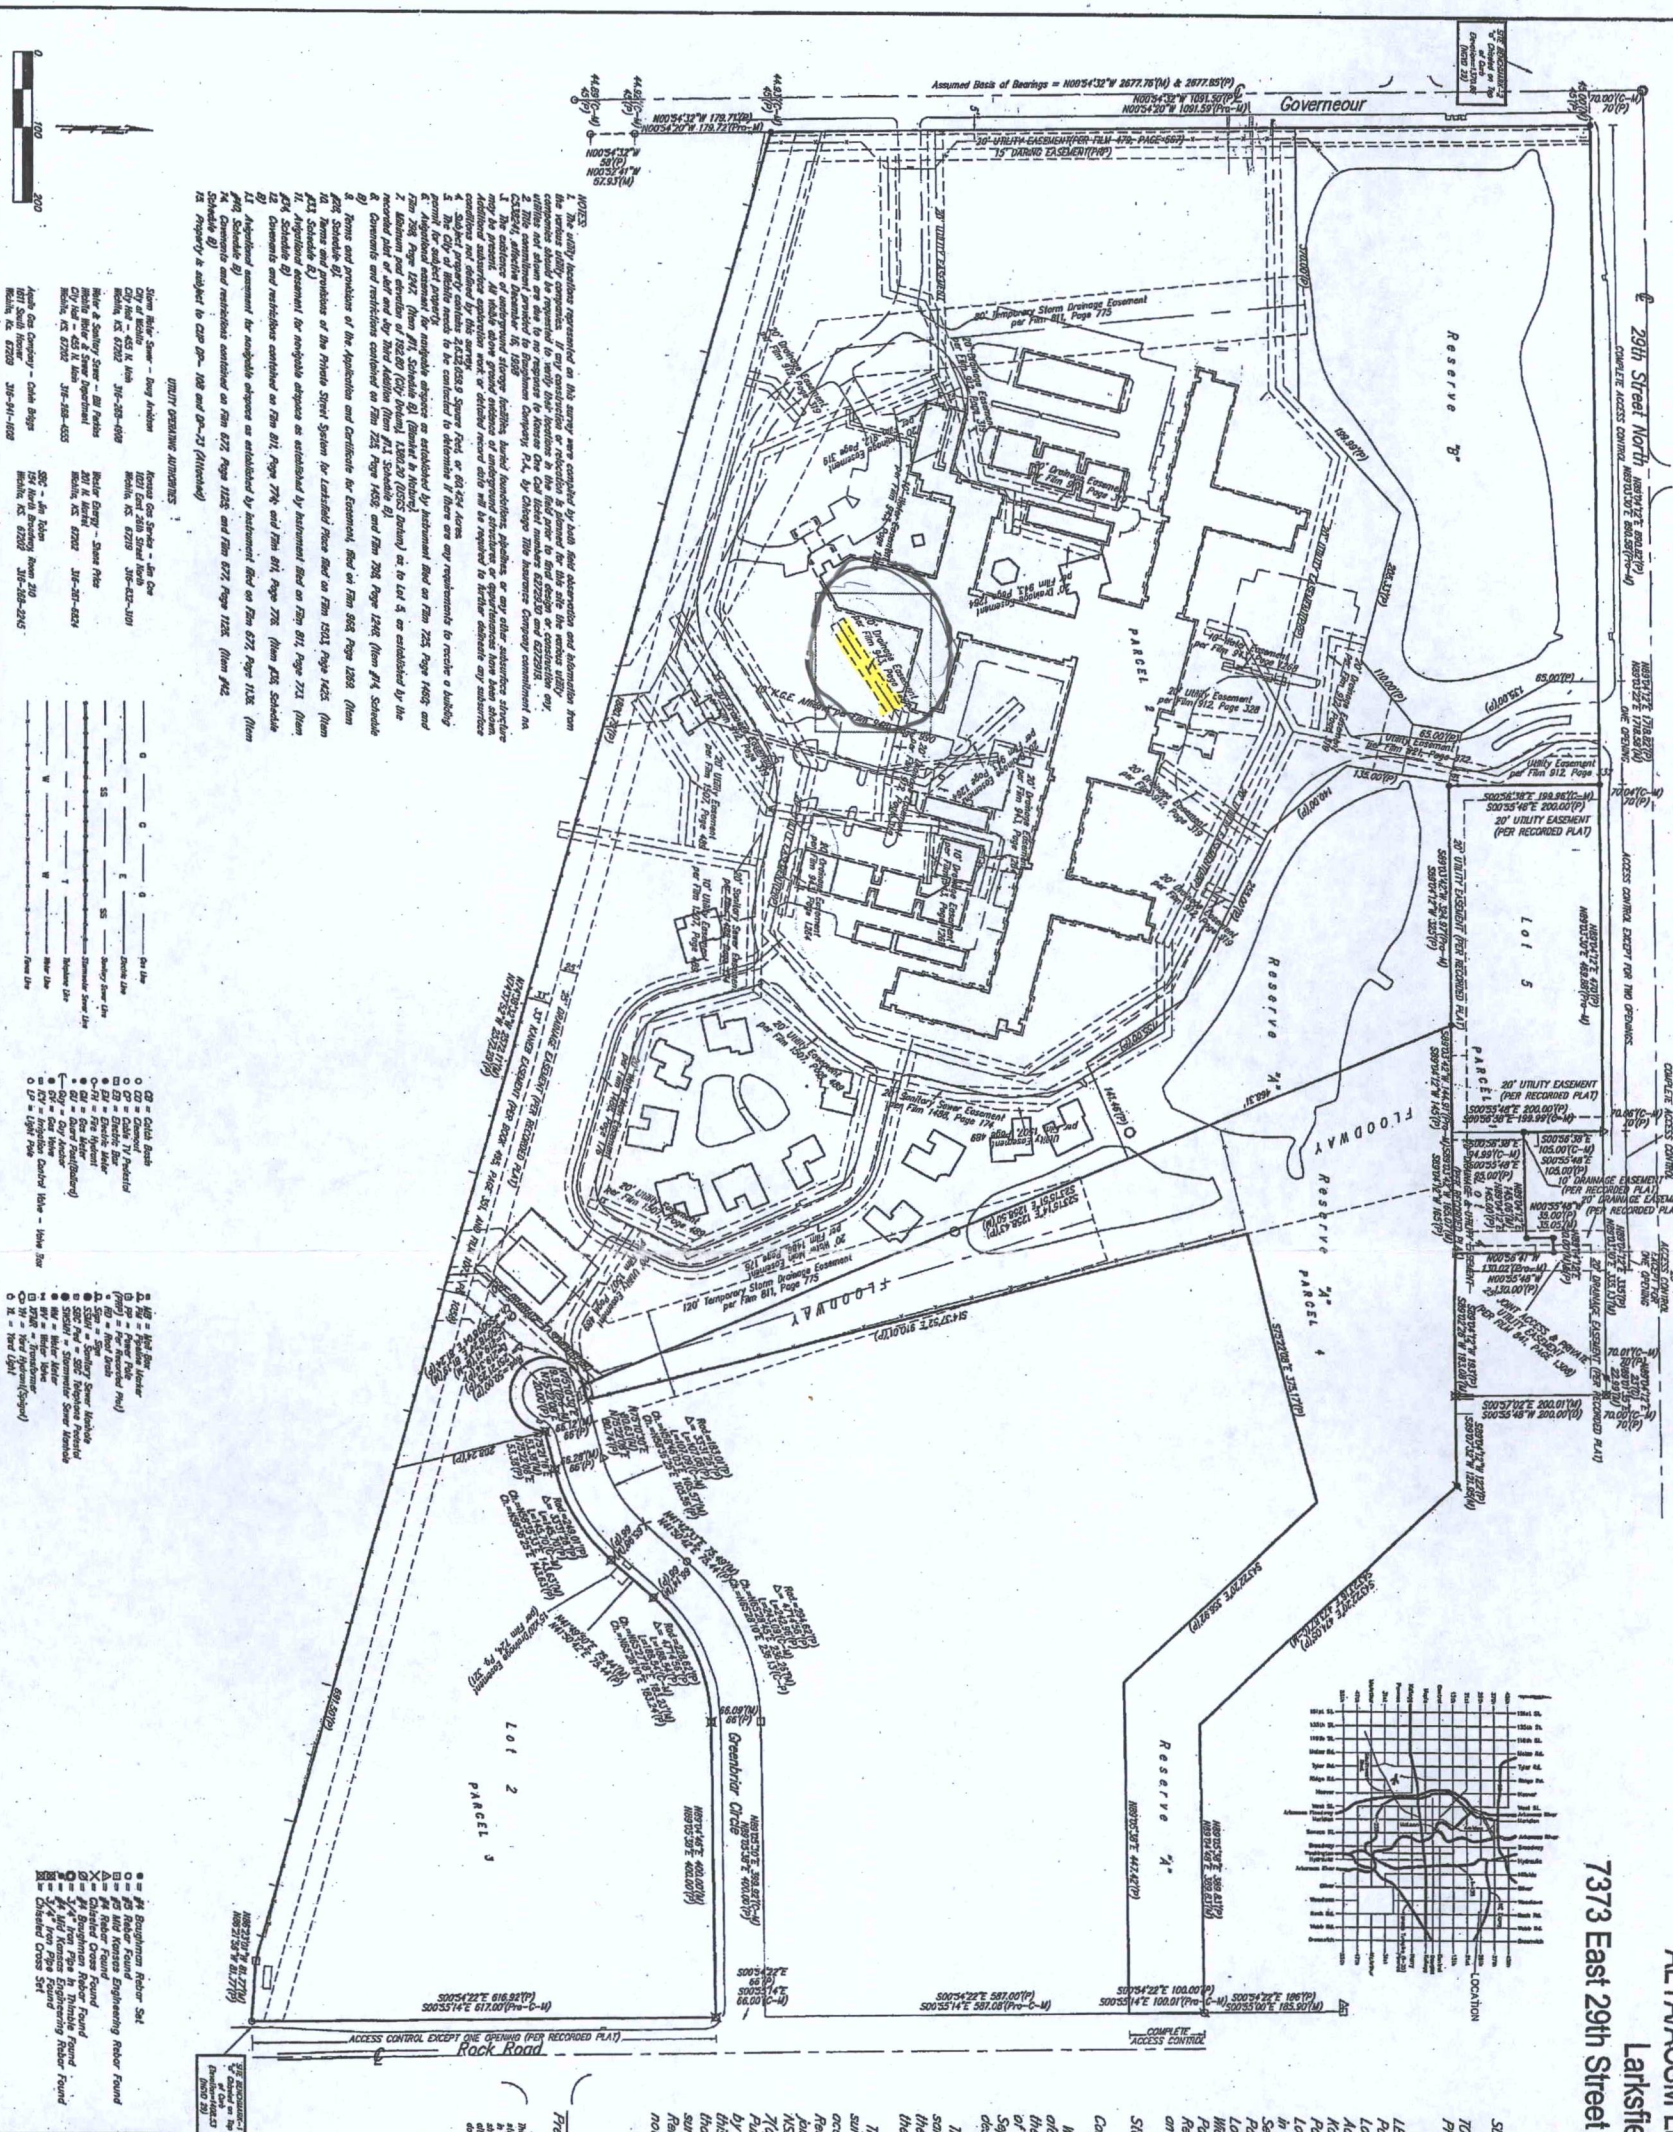



Baughman
 Building Group, P.A. HILL, HILL, WILSON, STEIN, PETERSON, JOHNSON
 ARCHITECTS • PLANNING • INTERIOR DESIGN • LANDSCAPE ARCHITECTURE

EROSION

Page 1 of 6

LARKSFIELD PLACE
 7373 E. 29th St. No., Wichita, KS
ALTA/CADDSM and Title Survey

SCALE **DATE**
 1"=40' November 6, 2006

ADDITIONAL **BY**
 GIS EWS








06401092518