



Wichita-Sedgwick County Metropolitan Area Planning Department

December 28, 2012

Randall J. and Diane Rubenthaler
125 N. Gleneagles
Wichita KS


Re: **VAC2012 -00036-** City request to vacate a portion of a platted easement, generally located midway between Tyler and Ridge Roads, south of 2nd Street, on the southwest side of Woodchuck Lane and Gleneagles Drive (125 N Gleneagles).

Dear Sir or Madam:

At its regular meeting on Tuesday, December 18, 2012, the Wichita City Council considered the request. The action of the City Council was to APPROVE subject to the recommendation by the MAPC.


If you have any questions about this matter, please call 268-4494.

Sincerely,

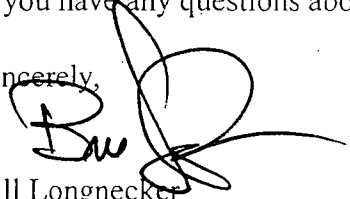
Bill Longnecker
Senior Planner

BL:le

cc: Gary Janzen, Interim City Engineer, Public Works Department, mailstop 1-71 (email)
Carla Jones / Paul Gunzelman, Public Works Engineering, mailstop 1-71 (email)
Julianne Kallman, Public Works Engineering, mailstop 1-71 (email)
Aaron Henning, Public Works Engineering mailstop 1-82 (email)
Terry Nicholas, Public Works Engineering, mailstop 1-82 (email)
Donald Craddock, Public Works Engineering, mailstop 1-81(email)
Zongbin Zhao, Public Works Engineering, mailstop 1-82 (email)
Kerry Gibson, Water & Sewer, mailstop 1-81 (email)
Paul L. Moorhouse, 203 N. Woodchuck, Wichita KS 67212
Larry A. and Ruby K. Keahey, 119 N. Gleneagles, Wichita KS 67212

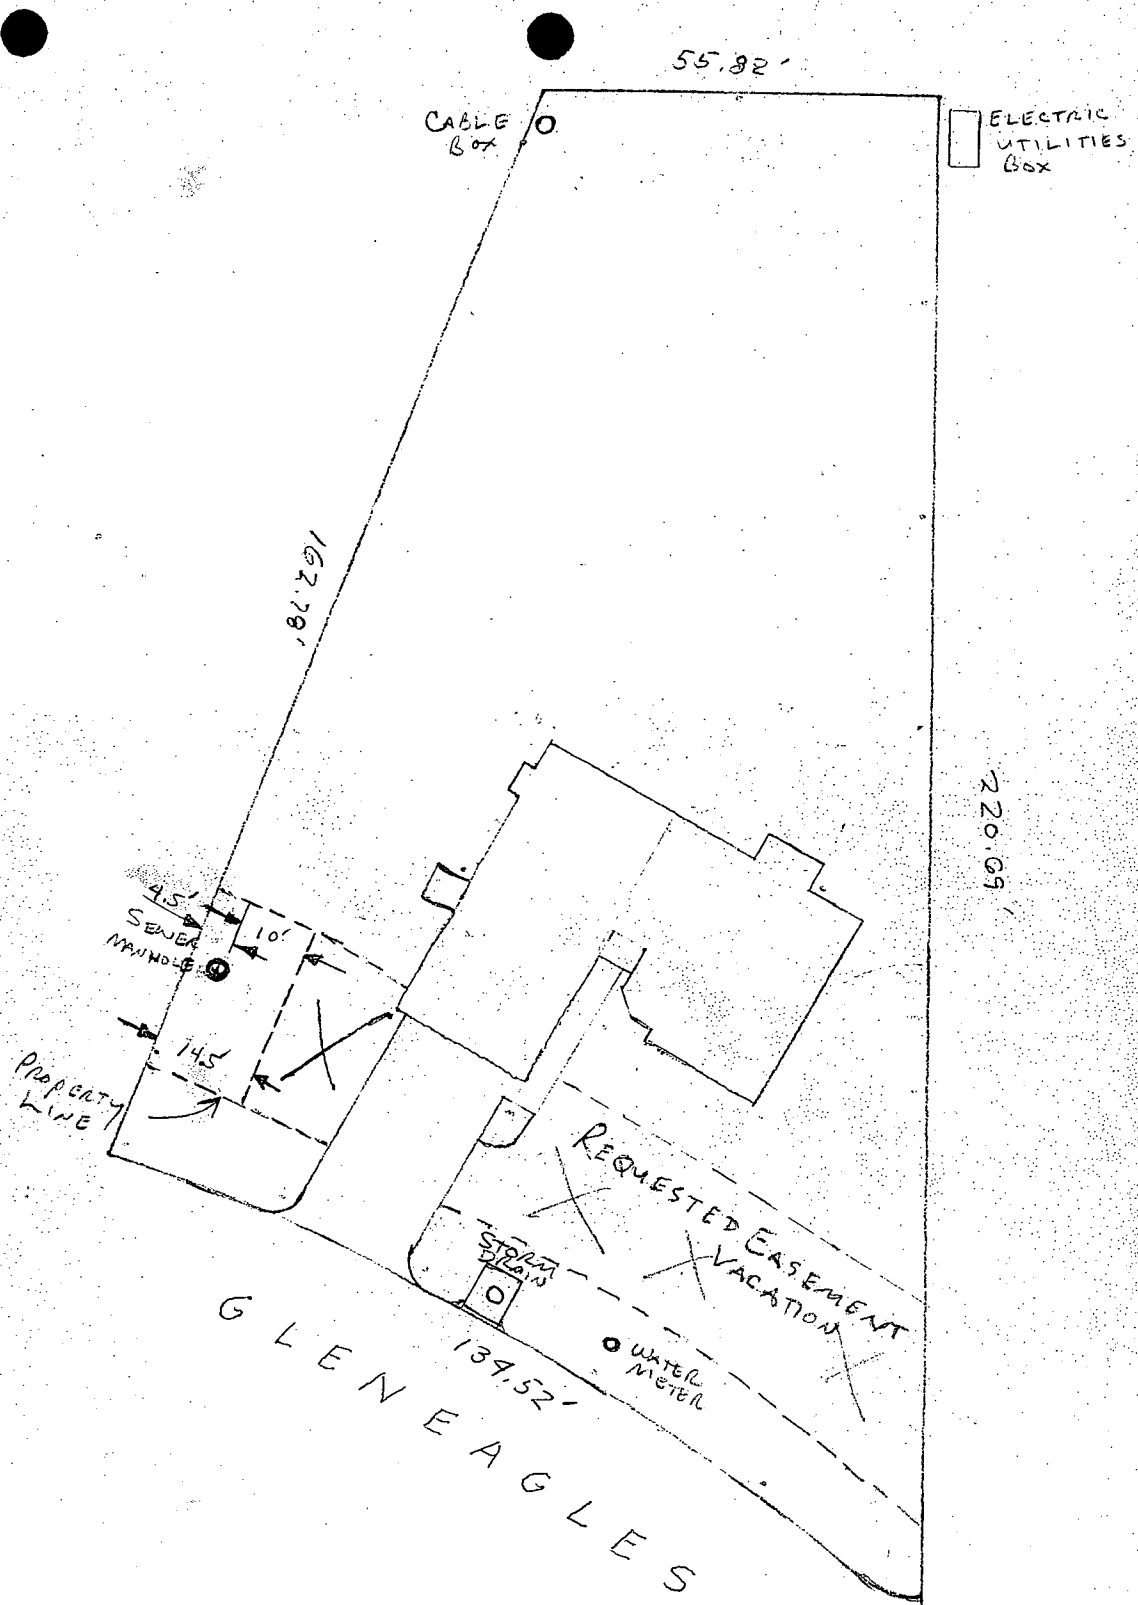

RANDY ROSENTHALER
 125 N. GLENAGLES
 WICHITA, KS. 67212
 722-1652
 SCALE 1" = 27'