


MAPLE AVE.


MCCOMAS AVE.

KESSLER AVE.

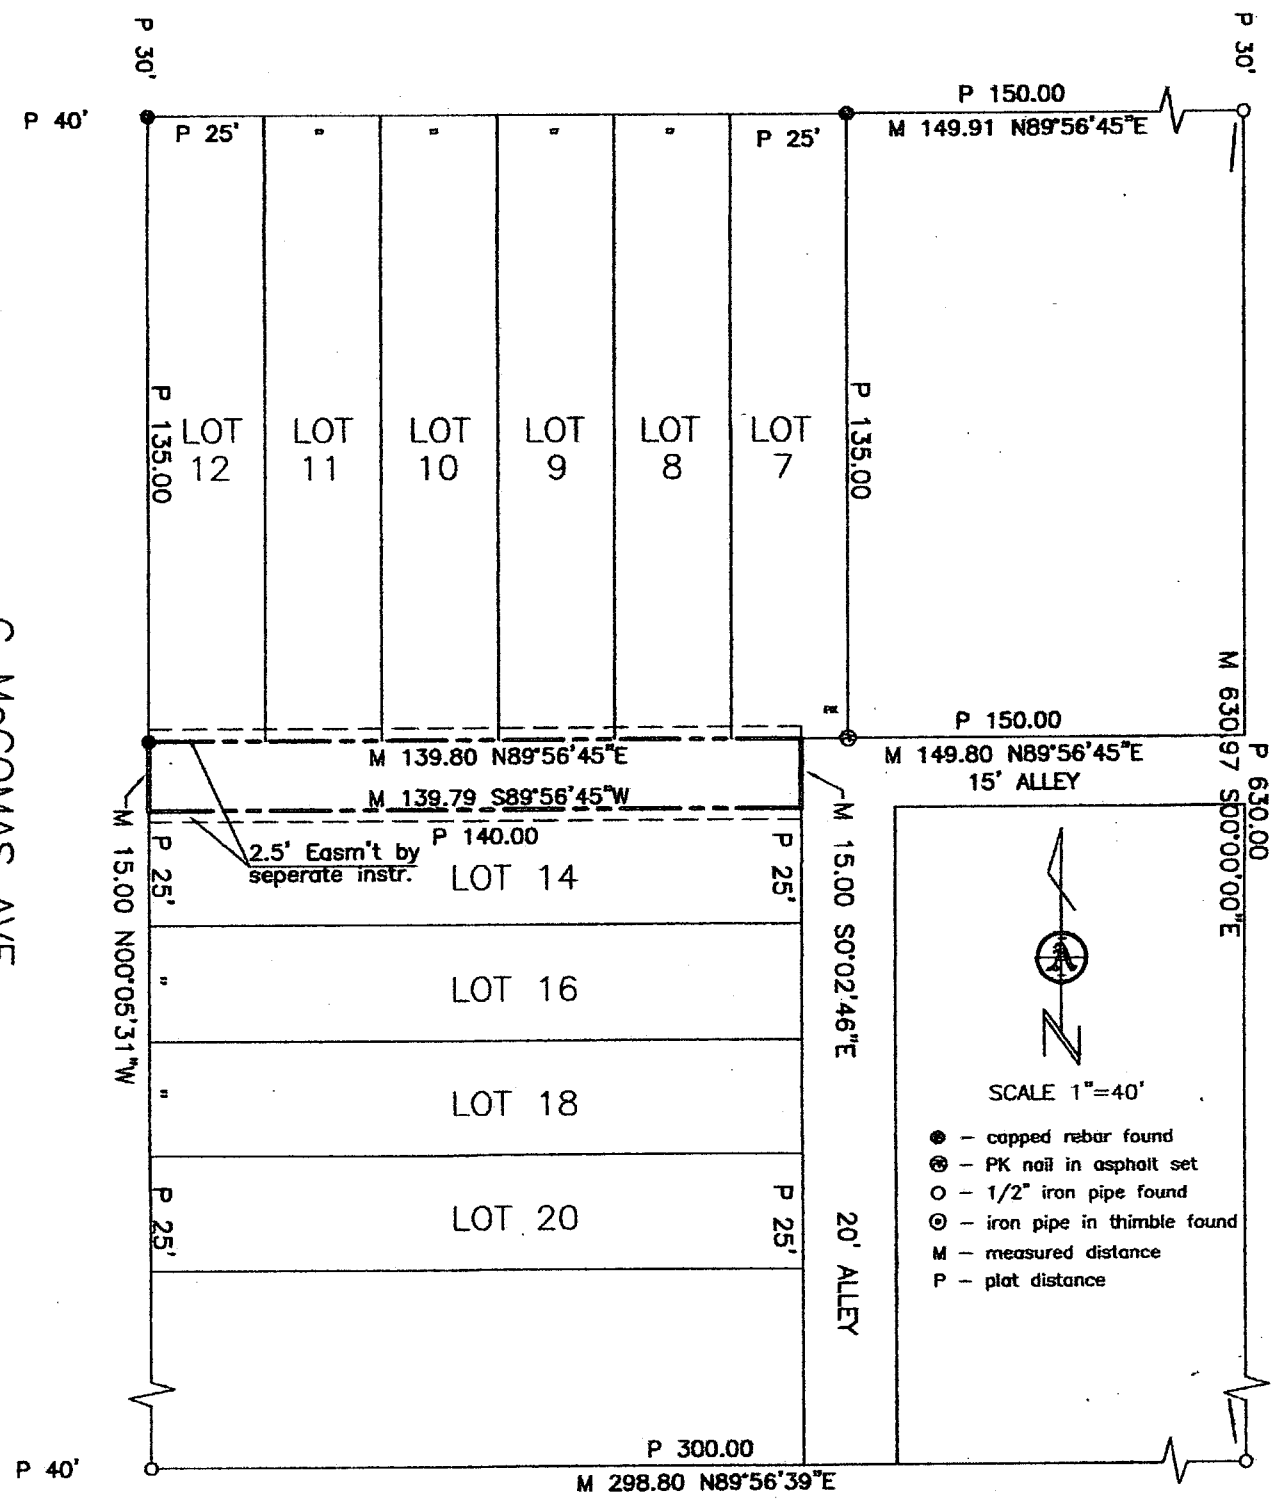


UNIVERSITY AVE.

MAPLE AVE SITE PLAN

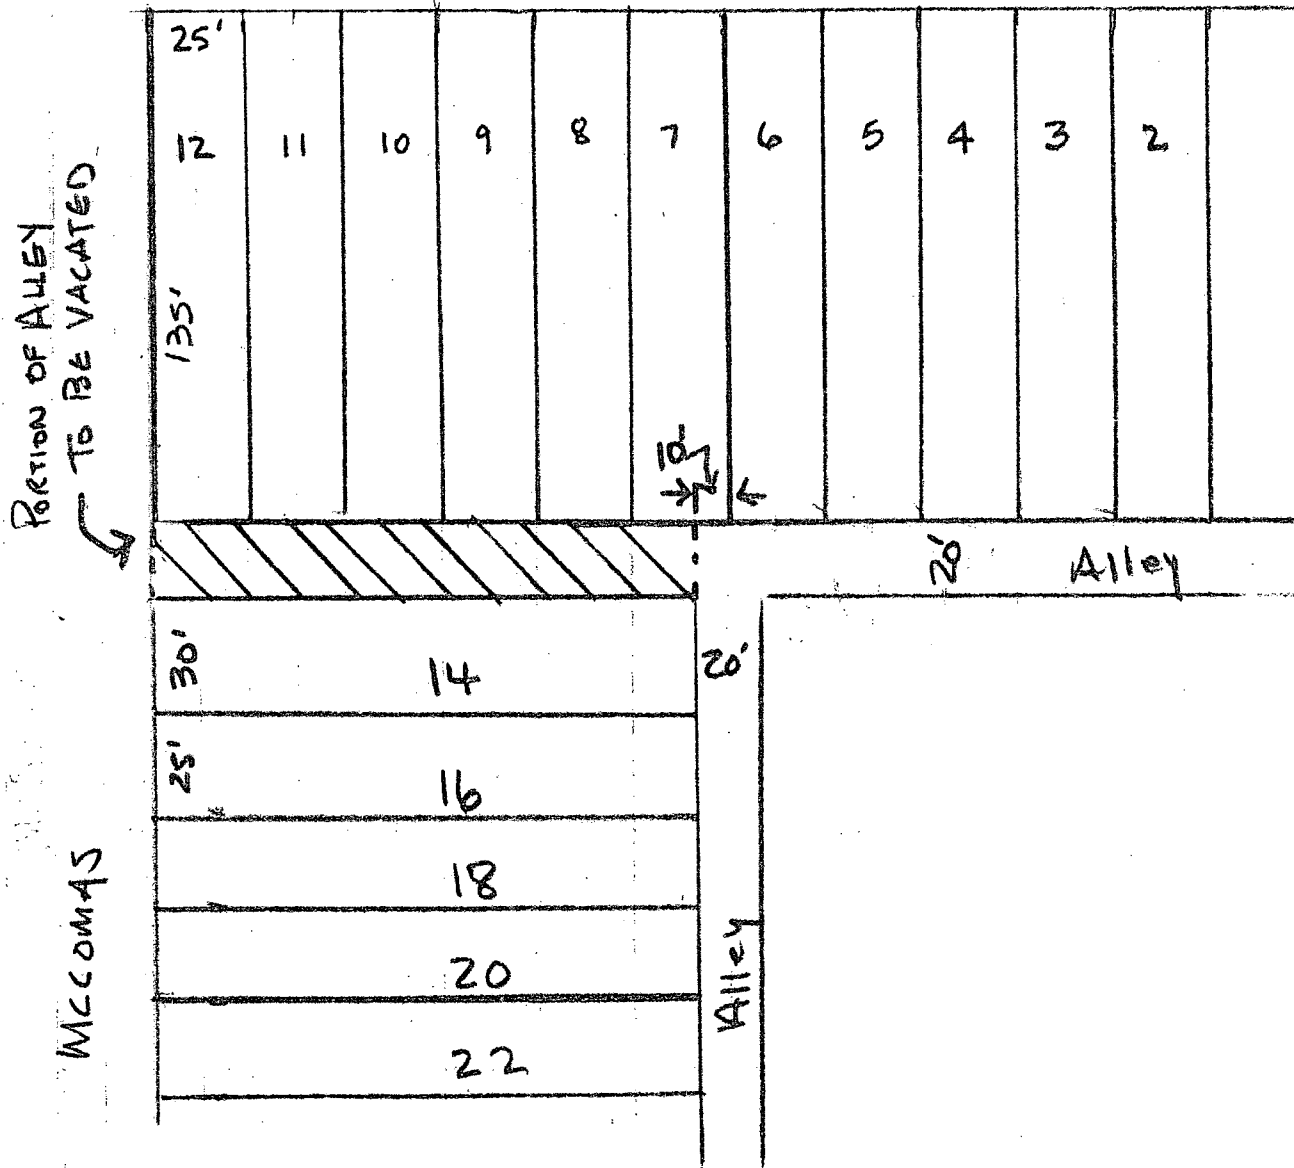

REQUEST TO VACATE ALLEY
MARK SR LLC

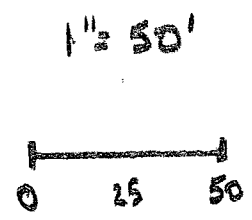

12-3-12