



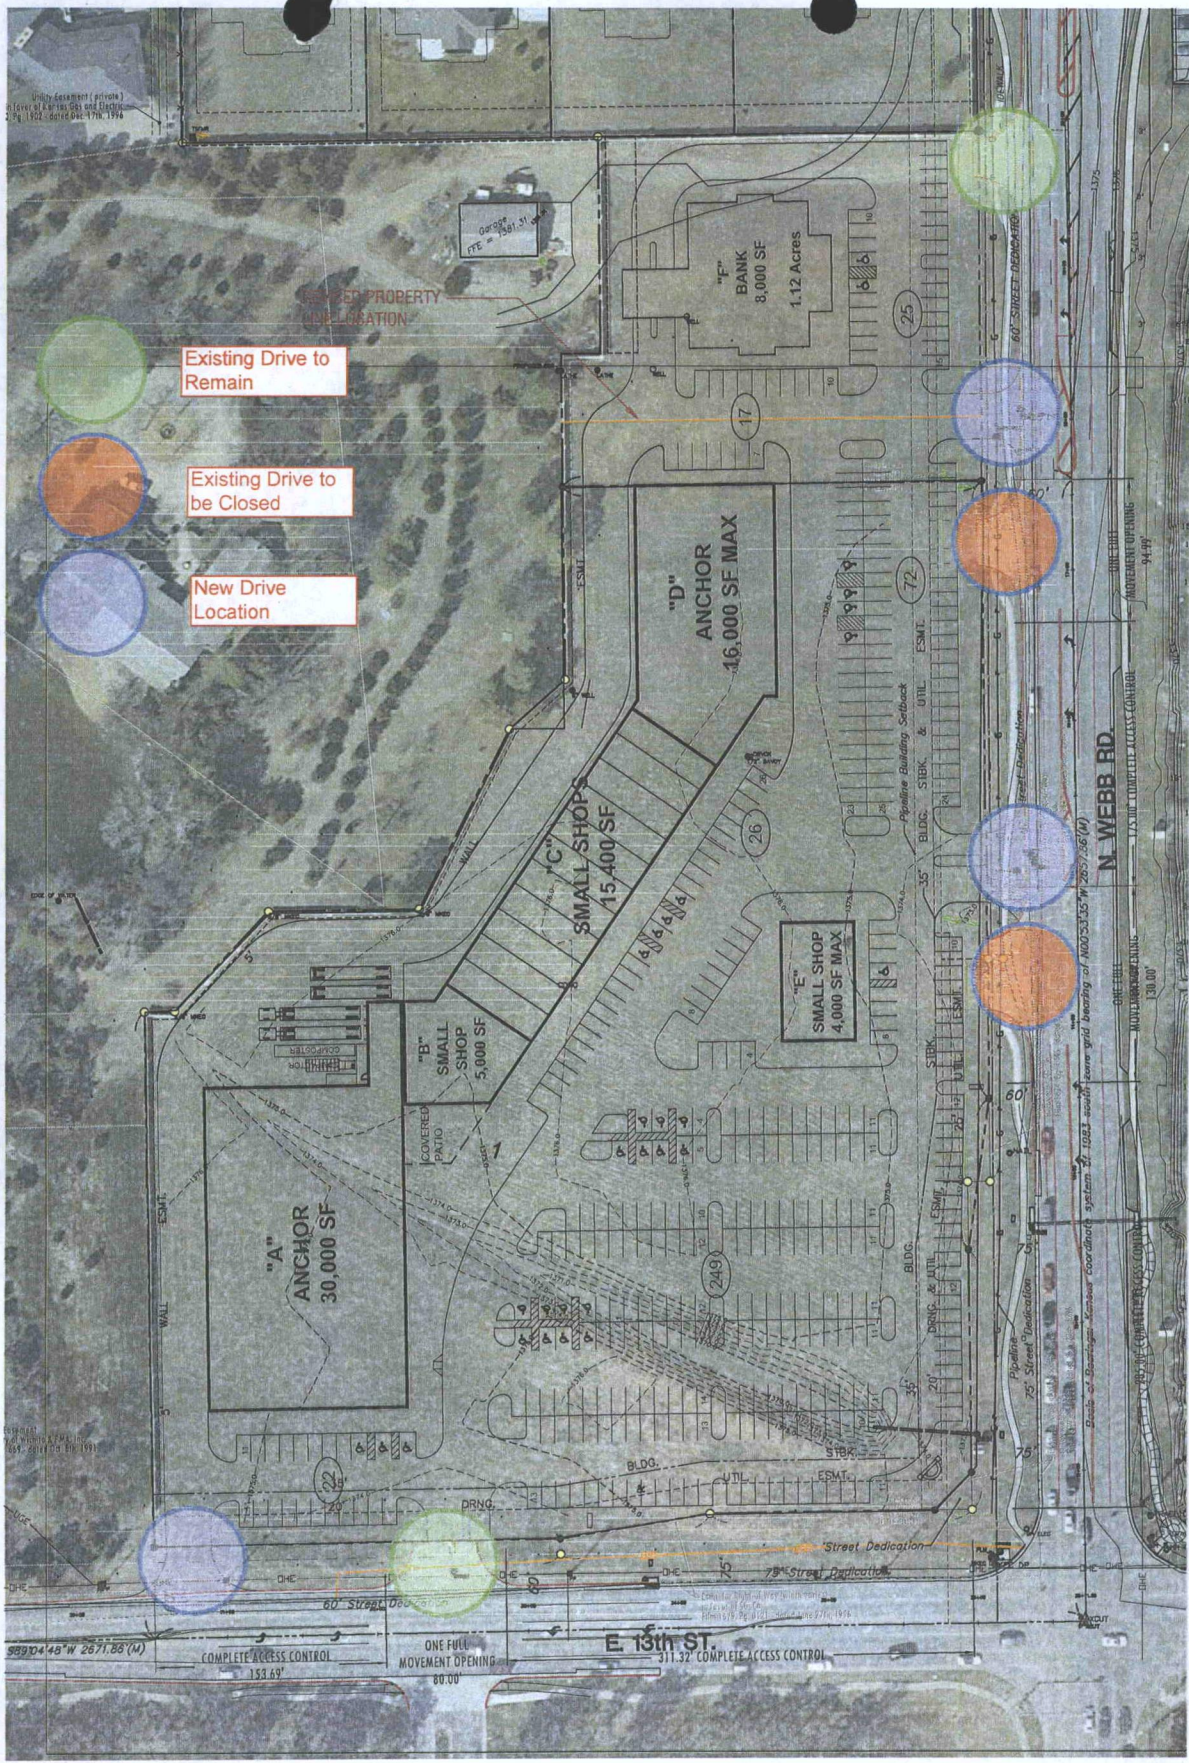


Existing Drive to Remain

Existing Drive to be Closed

New Drive Location

WATERFRONT PLAZA

CONCEPTUAL LAND PLAN

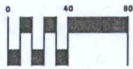

MARCH 01, 2013

MKEC
ENGINEERING
CONSULTANTS, INC.

C:\Users\G457A\My Documents\ConceptPlan01_01_2013.dwg 02/27/2013 08:02:45 AM CST