

SOUTH FIREFLY STREET

STREET CURB

PROPERTY LINE

15'-0"

6'-9 $\frac{1}{2}$ "

1 CAR GARAGE
ADDITION:
12'x38'

12'-0"

18'-9 $\frac{1}{2}$ "

NEW DRIVEWAY

EXISTING DRIVEWAY

EXISTING RESIDENCE

SINGLE CAR GARAGE ADDITION PLAN SHEET



329 FIREFLY CT. WICHITA, KS 3/32" = 1'-0"

DRAWN FOR:
ADAM HENNING

1

ADDENDUM PAGE NUMBER

UAL2013-13

 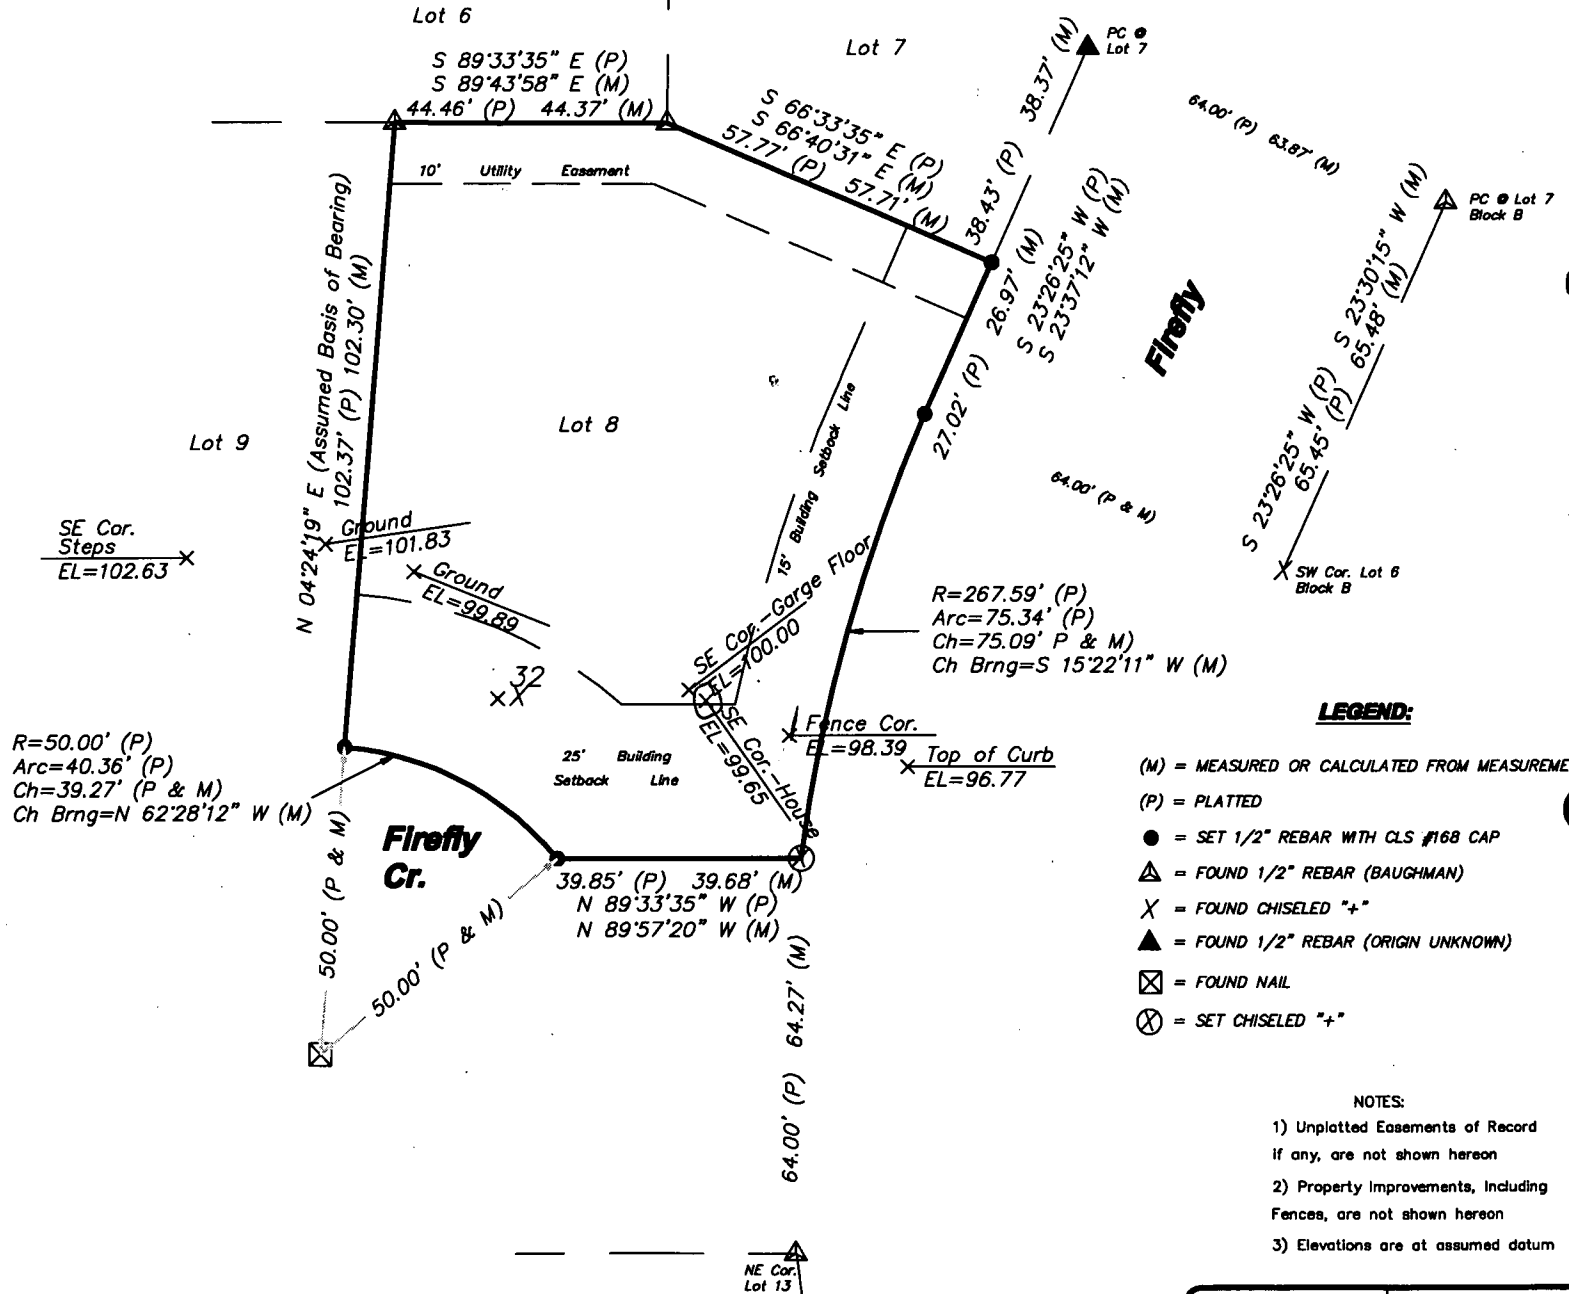

0 15 30

FILE: C:\drawings\boundary\A12500\A12507

Dwn. By: AMB	Aprvd. By: CRA
Dwg. No. A12507	Scale: 1" = 30'