

CRESTVIEW COUNTRY CLUB ESTATES SOUTHCREST ADDITION



TO
SEDGWICK COUNTY, KANSAS

1982

REISS AND GOODNESS ENGINEERS
2160 W. 21st. ST. WICHITA, KANSAS 67203

LEGEND

- 3/4" IRON OR
5/8" REBAR

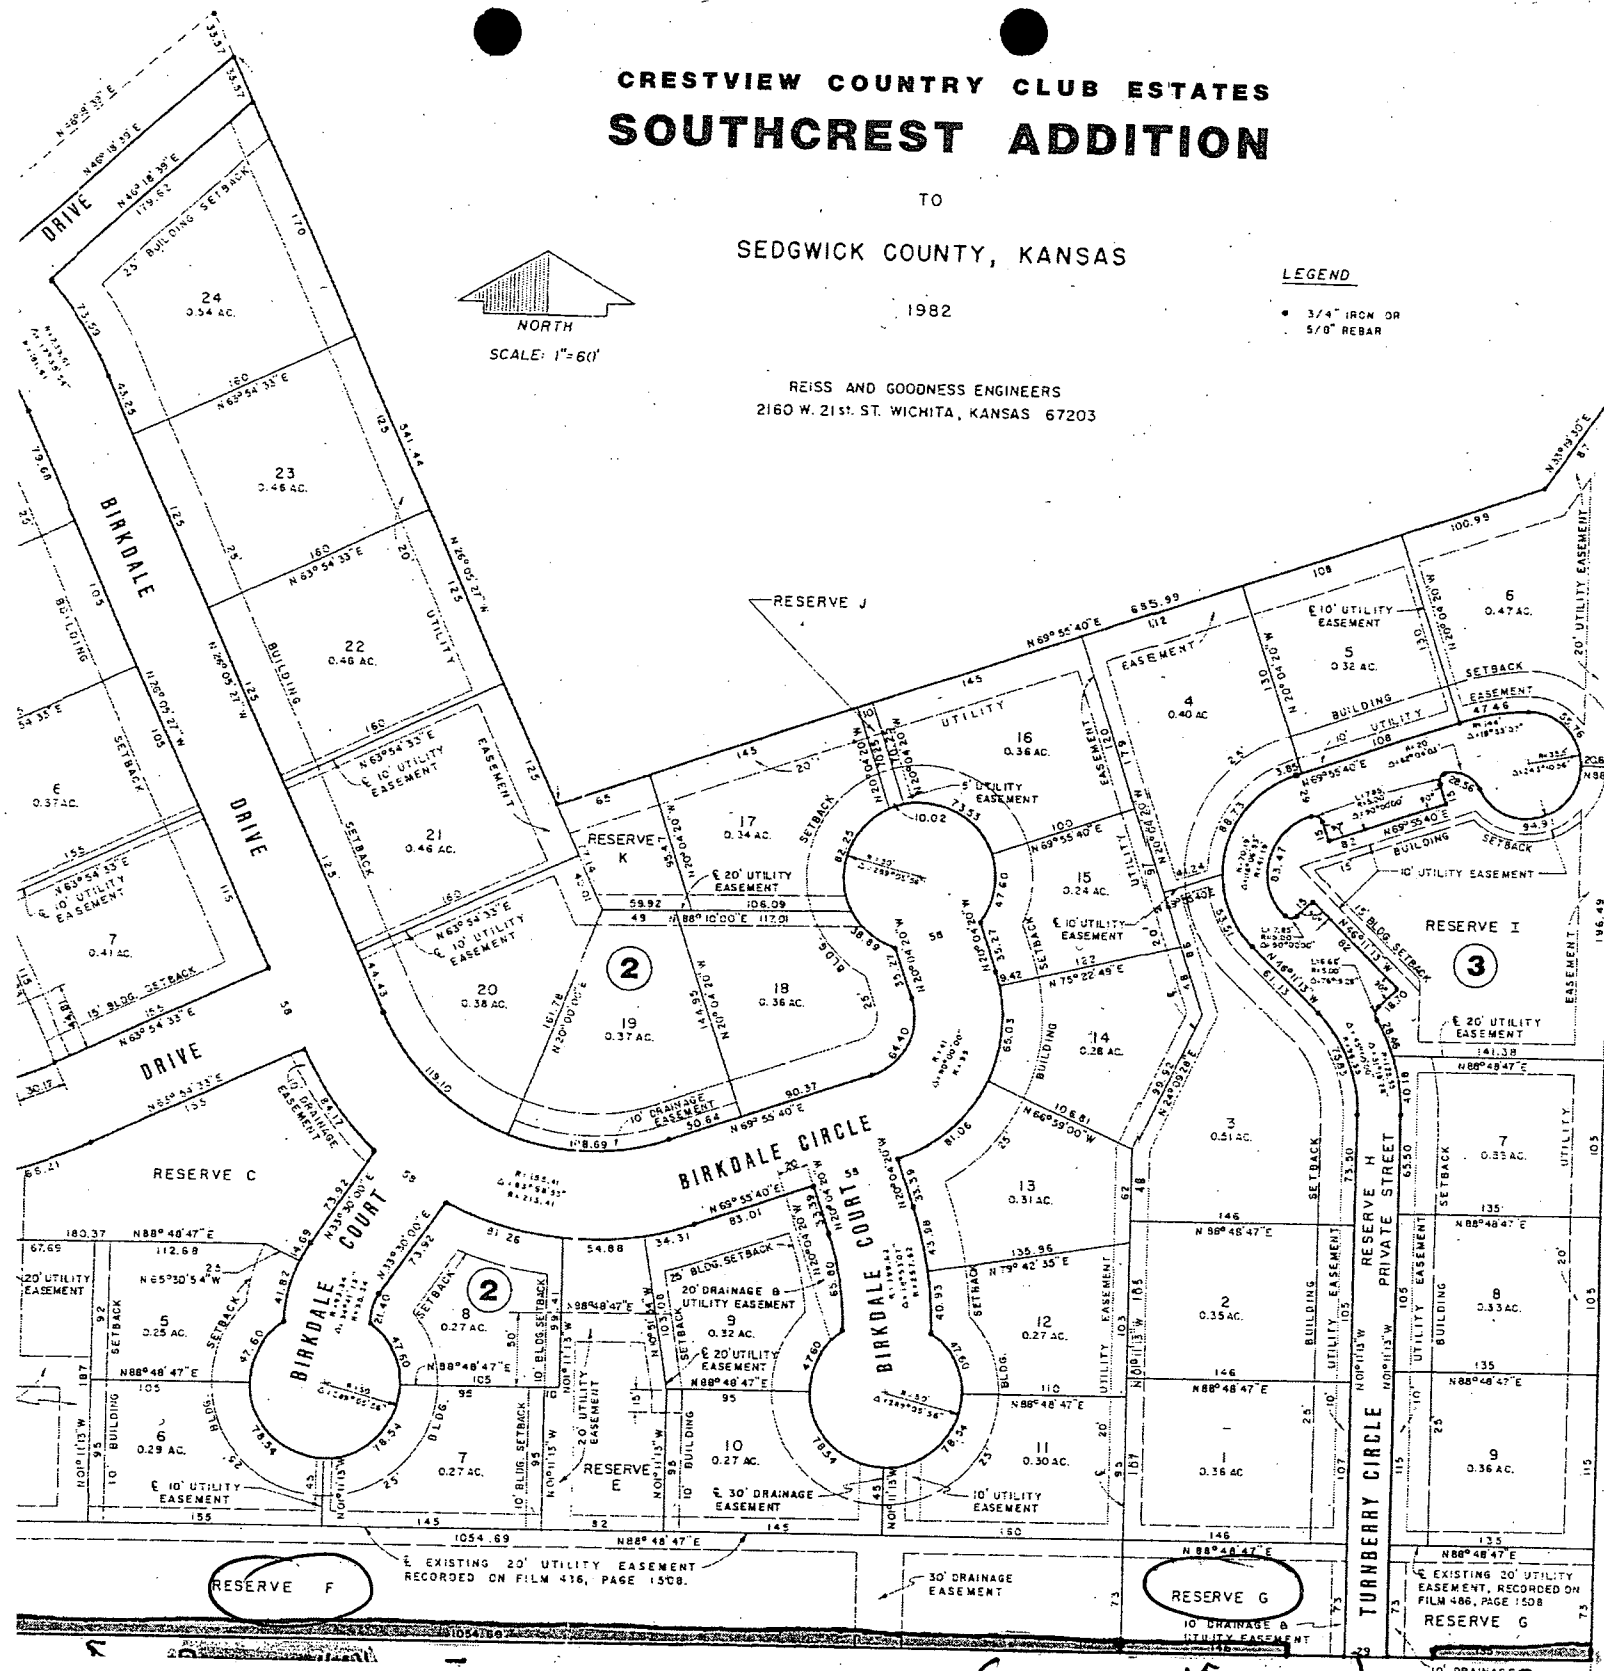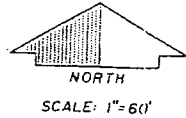

VAC 2013-14 <('Central Avenue')>