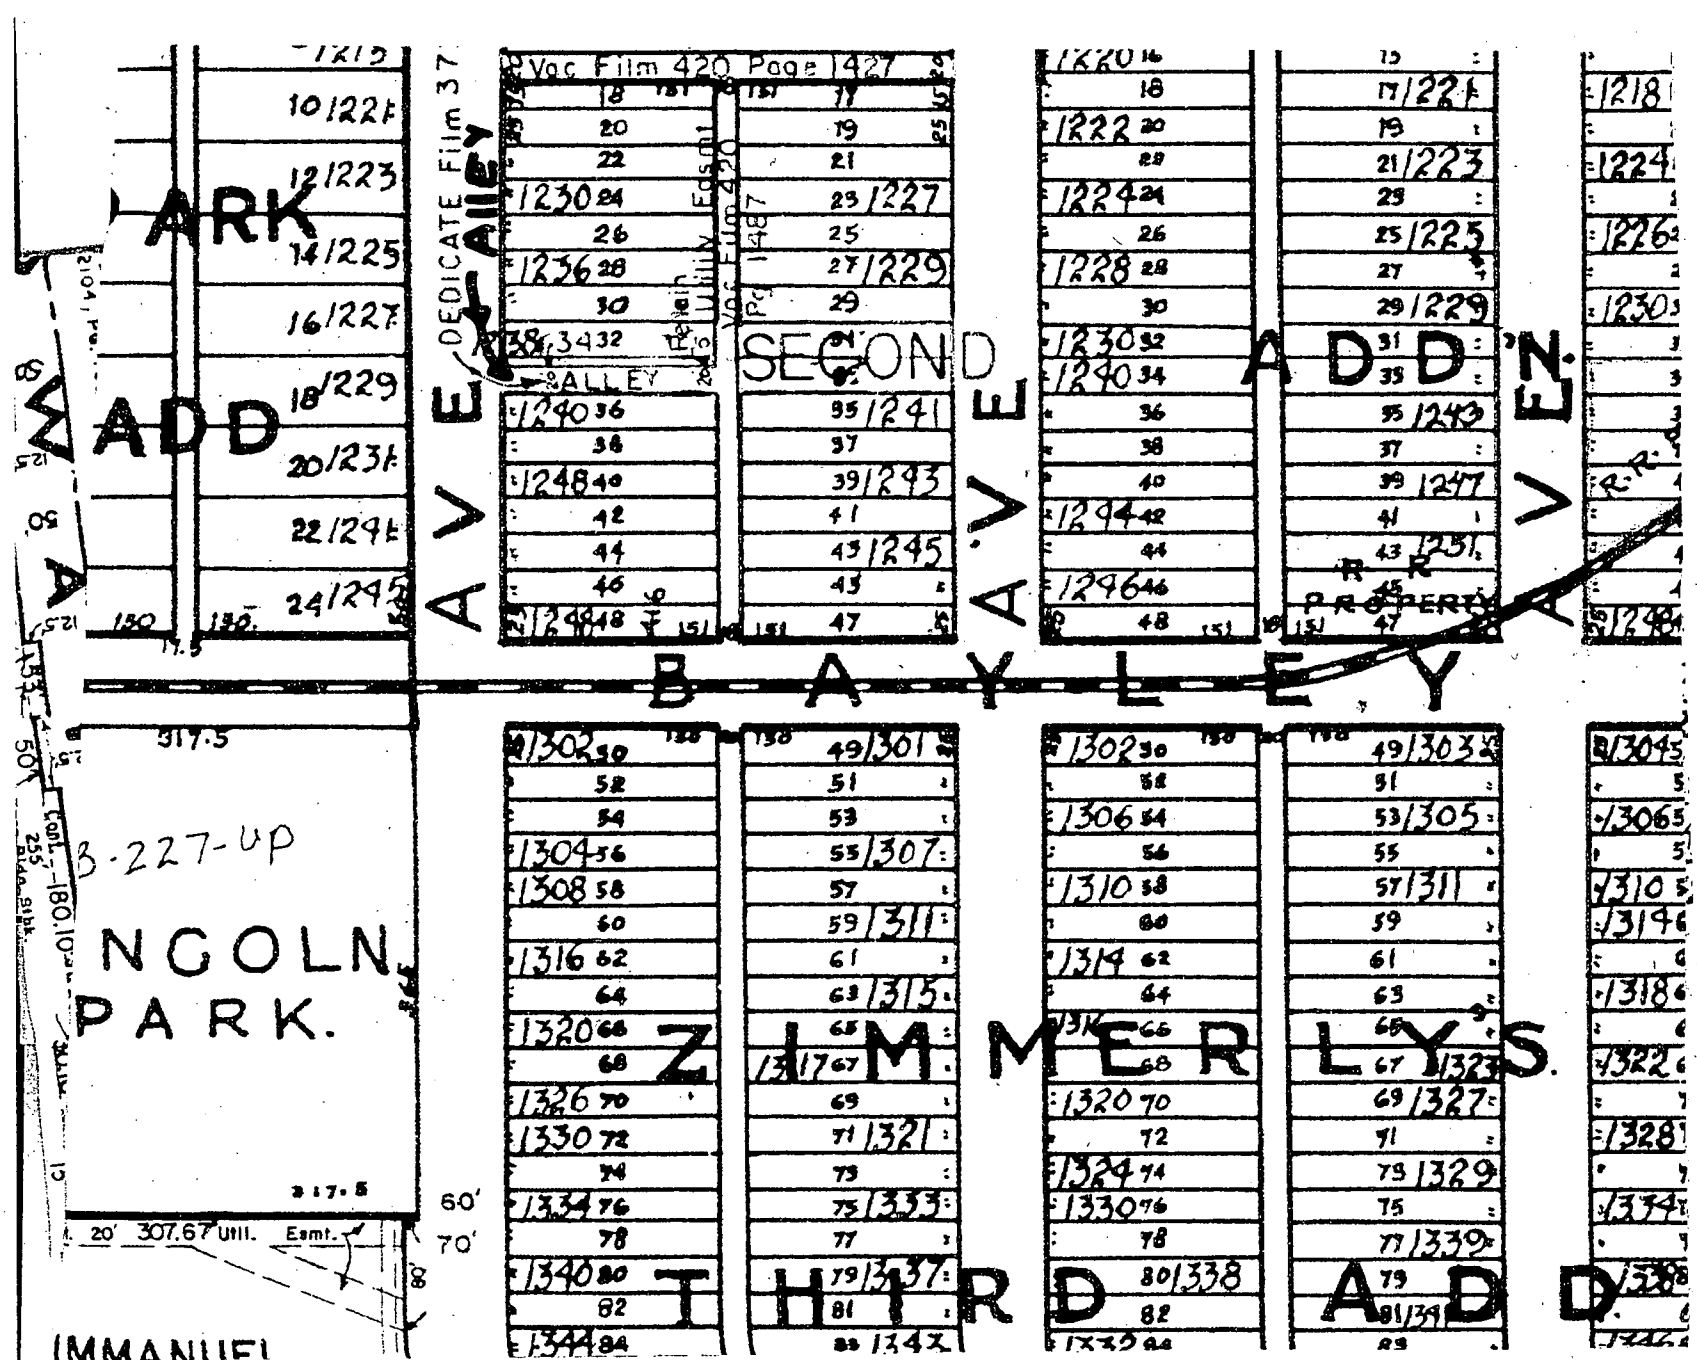
Vac Film 420 Page 1427
DEDICATE Film 37
ALLEY
SECOND ADDN.
VACATED ALLEY
BAYLEY
PROPERTY
ZIMMERLYS THIRD ADD
ADD
PARK
LINCOLN PARK.
B-227-UP
VAC2013-18
317.5
180
Util. Esmt.
60'
70'
80'