


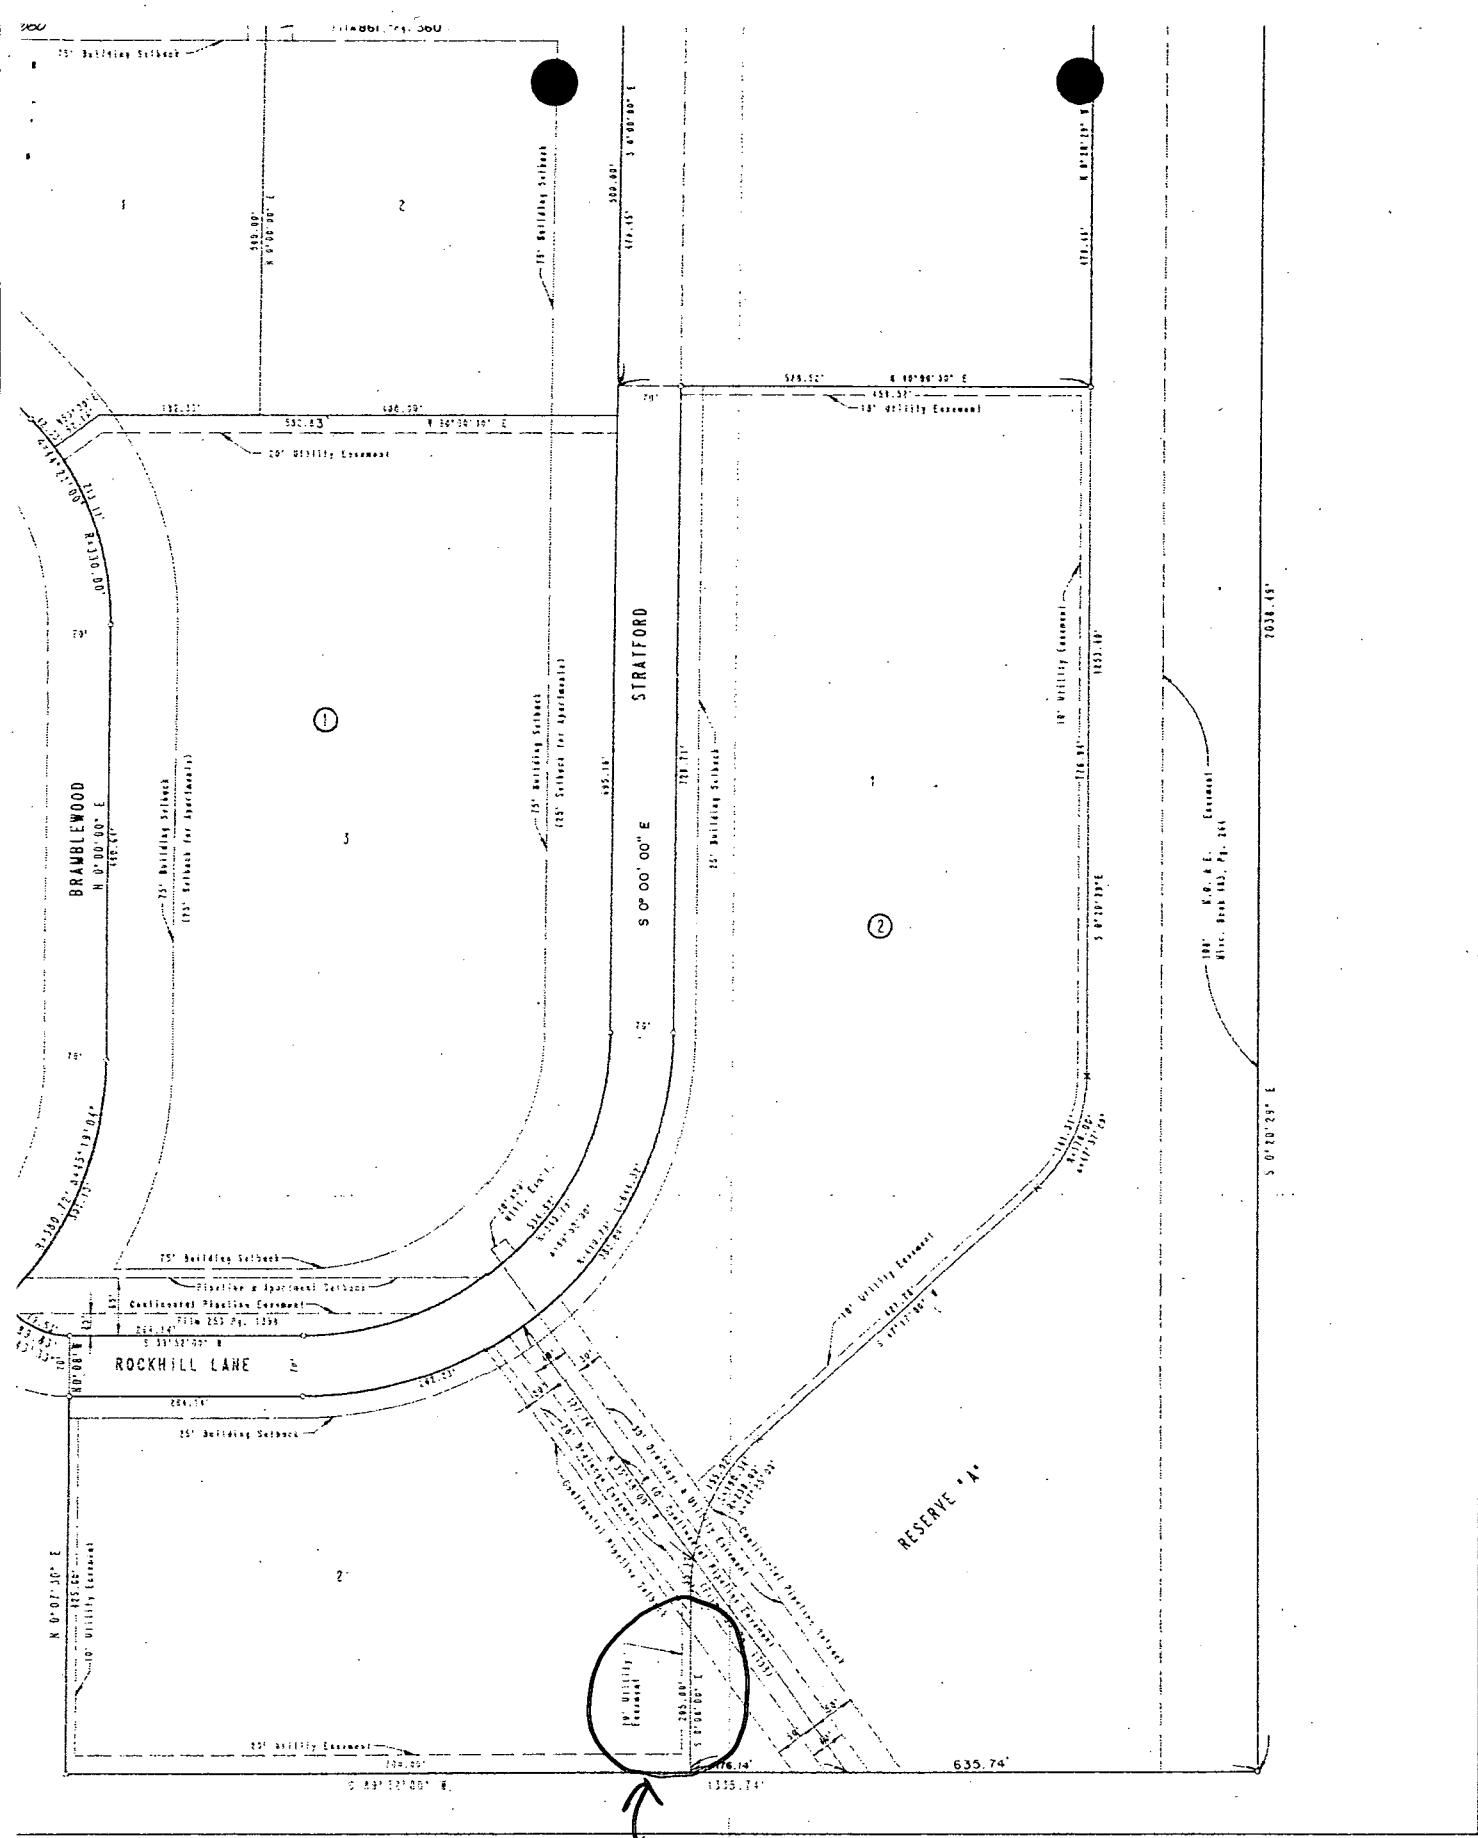

subject easement C-2 2-30

VAC-2013-22