



J. O. Michaelis, Acting Chair
Marvin S. Krout, Secretary

This plat approved and all dedications shown hereon accepted by the City Council of the City of Wichita, Kansas, this 20th day of AUGUST, 2002.

At the direction of the City Council



Chris Cherches, City Manager
Pat Burnett, City Clerk

Reviewed in accordance with K.S.A. 58-2005 on this 12th day of August, 2002.

Tricia L. Robello
 Tricia L. Robello, L.S. #1246
 Deputy County Surveyor
 Sedgwick County, Kansas


Entered on transfer record this 5th day of September, 2002.

Don Brace, County Clerk

State of Kansas) SS This is to certify that this plat has been
 Sedgwick County) filed for record in the office of the Register of Deeds, this 5 day
 of September, 2002 at 11:15 o'clock P.M.; and is duly recorded.


2119190

Bill Meek, Register of Deeds
Linda Kizzire, Deputy

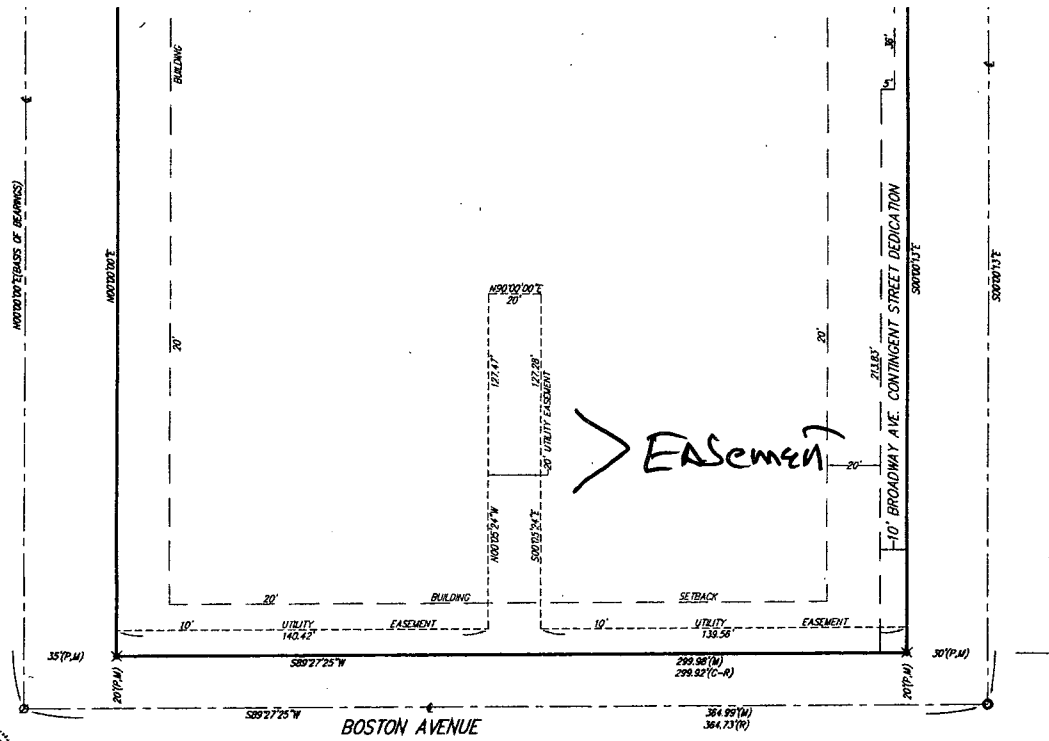

VAC2014-03

BAUGHMAN COMPANY P. A.
 ENGINEERING, SURVEYING, & PLANNING
 318-282-7271 • 318 ELLIS • WICHITA, KANSAS 67211
 P:\PLAT\BANKTON AND SCHOOL\BANKTON.DWG-DWG

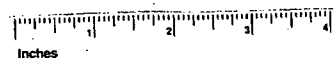

SEDGWICK COUNTY KANSAS

This digital plat record accurately reproduces in all details the original plat filed with the Sedgwick County Register of Deeds. Digitized under the supervision of Register of Deeds Bill Meek by Sedgwick County Geographic Information Systems.

Bill Meek, Register of Deeds
 Digitized rendition of original signature



PC140-1