


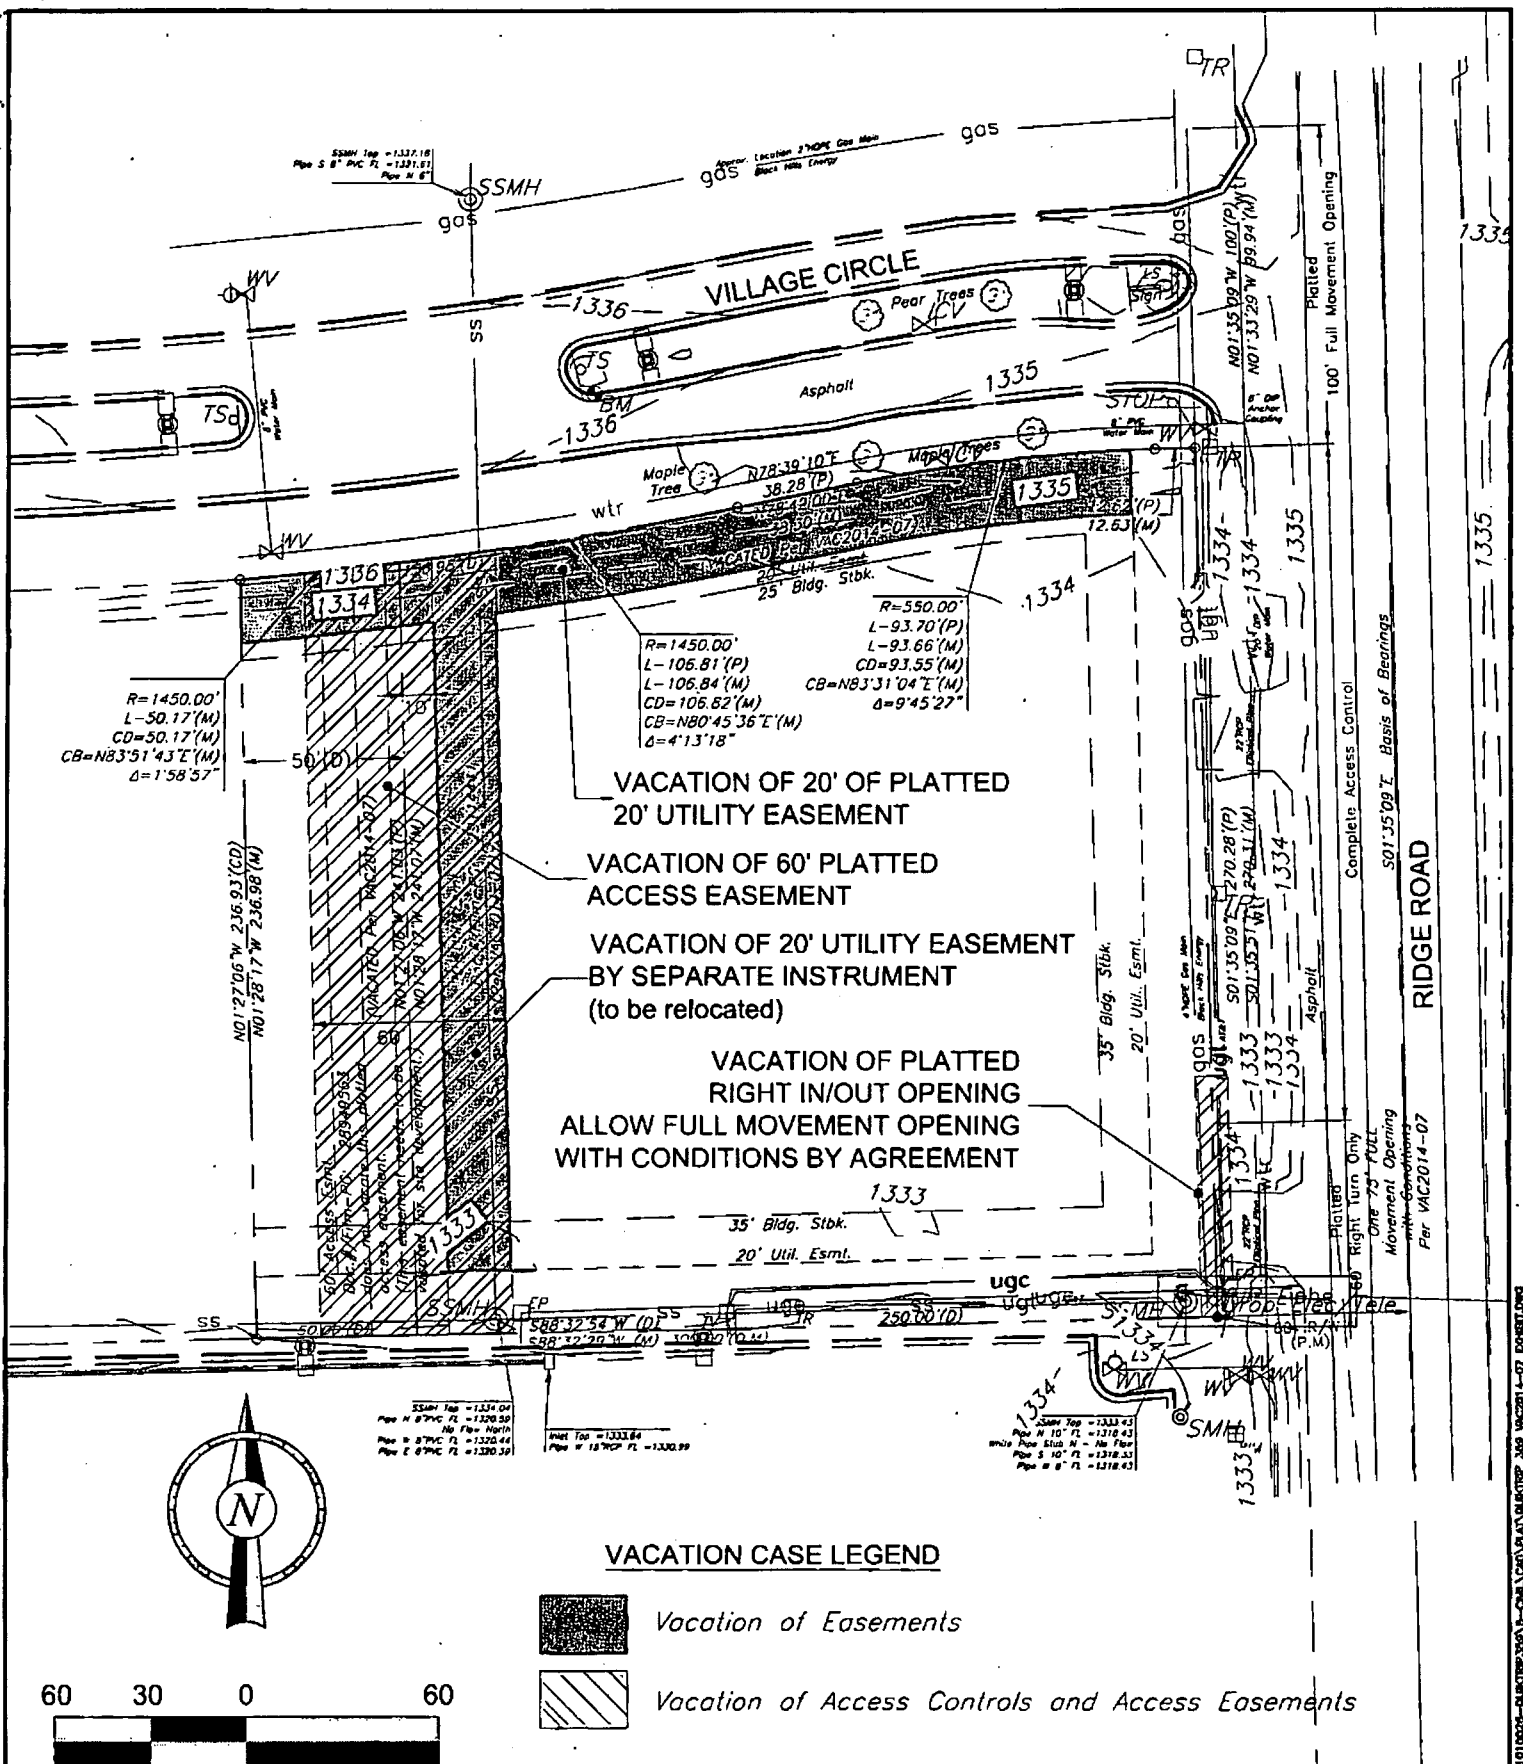

NO.	REVISION	DATE
0	ISSUED FOR USE	4/16/14

©2013
MKEC Engineering
All Rights Reserved
www.mkec.com
These drawings and their contents, including, but not limited to, all concepts, designs, & ideas are the exclusive property of MKEC Engineering (MKEC), and may not be used or reproduced in any way without the express consent of MKEC.



VAC2014-00007 Vacation Case Exhibit B QuikTrip 359		
PROJECT NO. 1401010026	DATE: April 16, 2014	SHEET NO.
DRAWN BY: BDL	DESIGNED BY: BDL	APPROVED BY: GJA
		1 OF 1

\\UTMSRVS001\PROJ\2014\1401010026-QuikTrip 359\B-CAD\DWG\QUKTRIP 359 VAC2014-07.DWG