


*Building Locate
300 Cedar Crest
Wichita, Kansas*

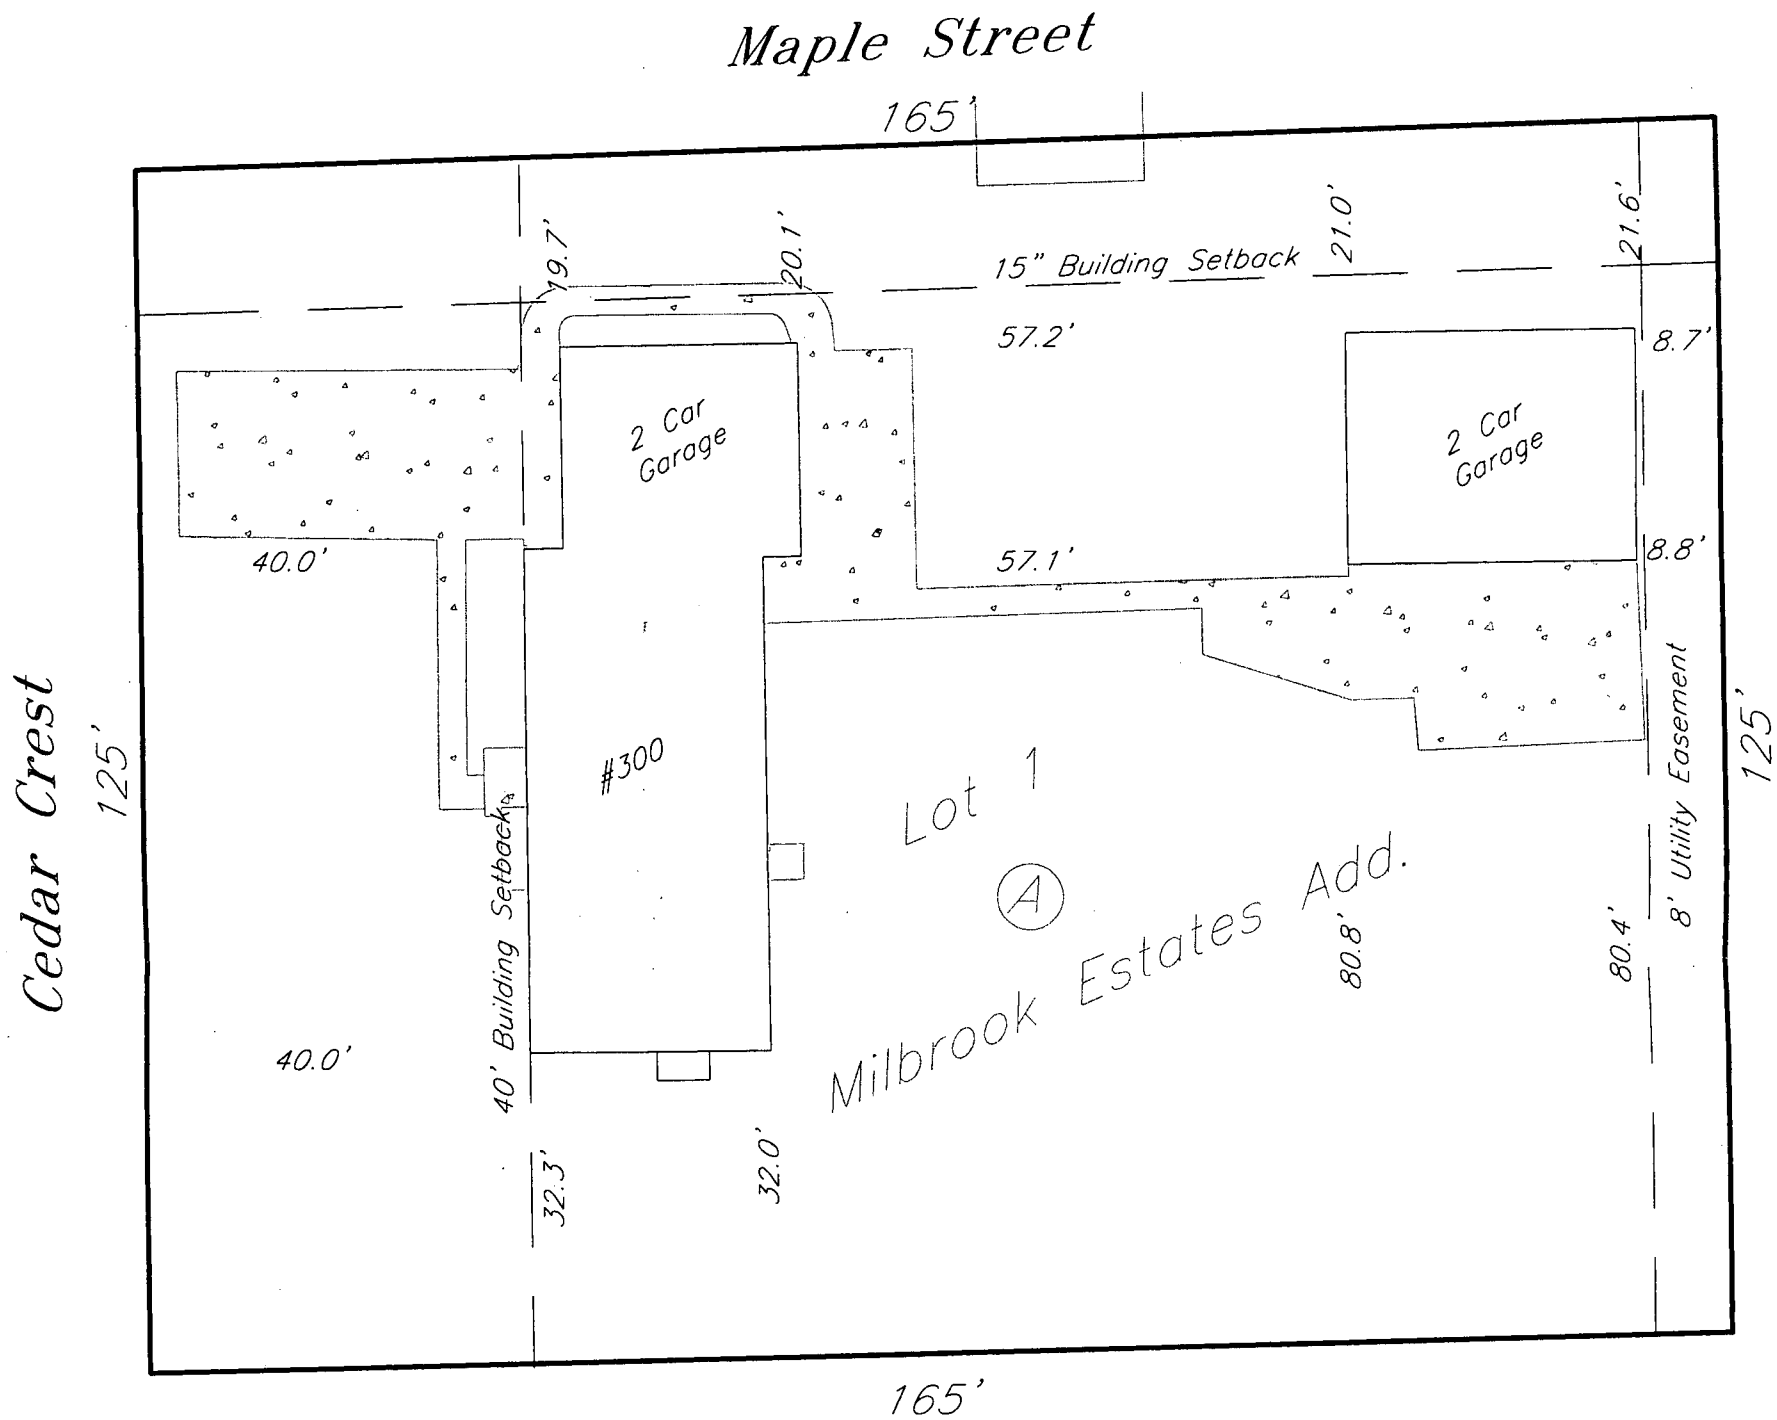

Legal Description
Lot 1, Block A, Millbrook
Estates Addition. Wichita,
Sedgwick County, Kansas.