


SANTA FE INDUSTRIAL DISTRICT
AT WICHITA KANSAS


Vol 2014-35

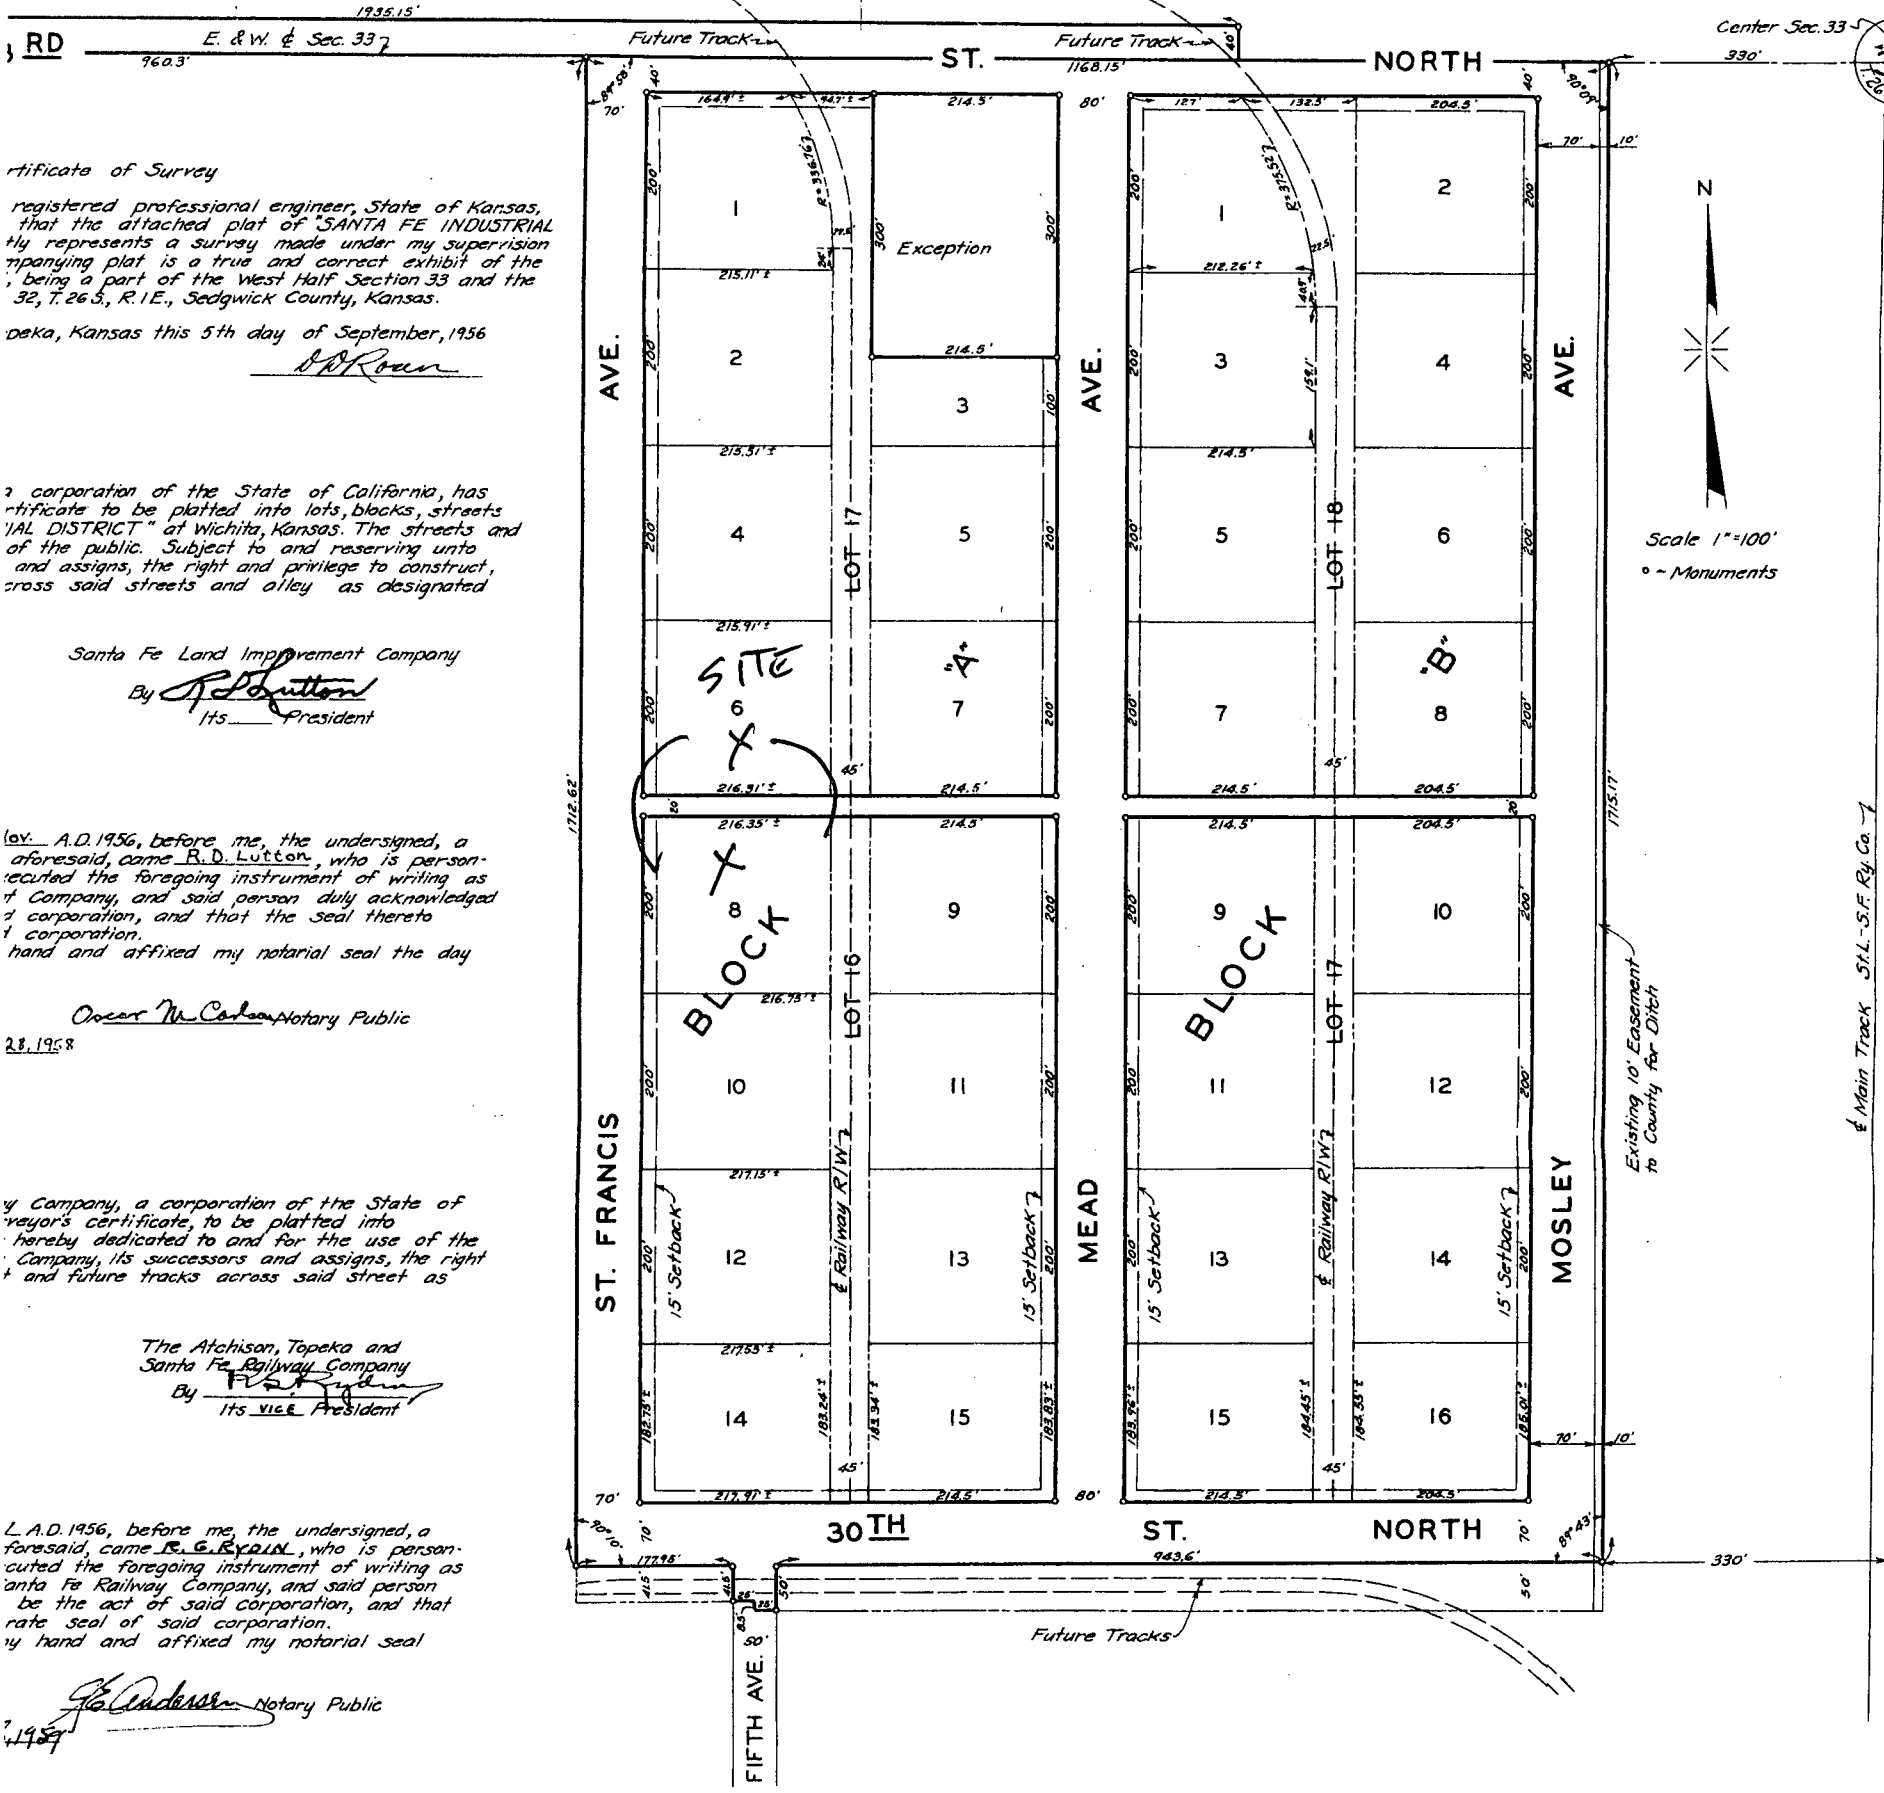

 This digital plat record accurately reproduces in all details the original plat filed with the Sedgwick County Register of Deeds. Digitized under the supervision of Register of Deeds Bill Meek by Sedgwick County Geographic Information Systems.

Bill Meek, Register of Deeds
Digitized rendition of original signature

33RD ST. NORTH

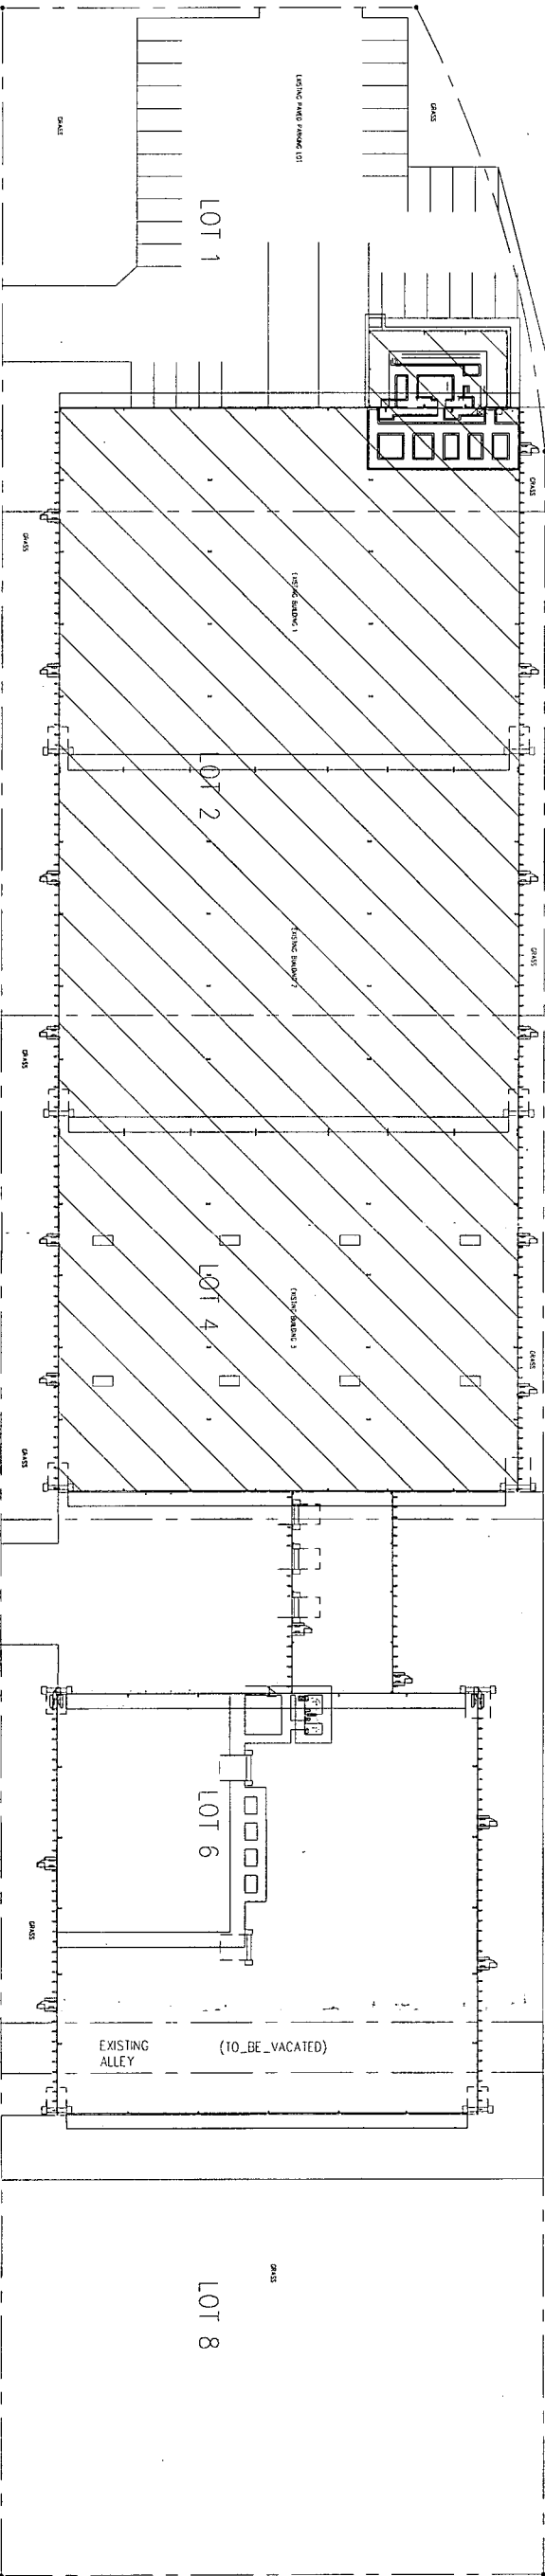

RAIL ROAD SPUR

ST. FRANCIS STREET

