

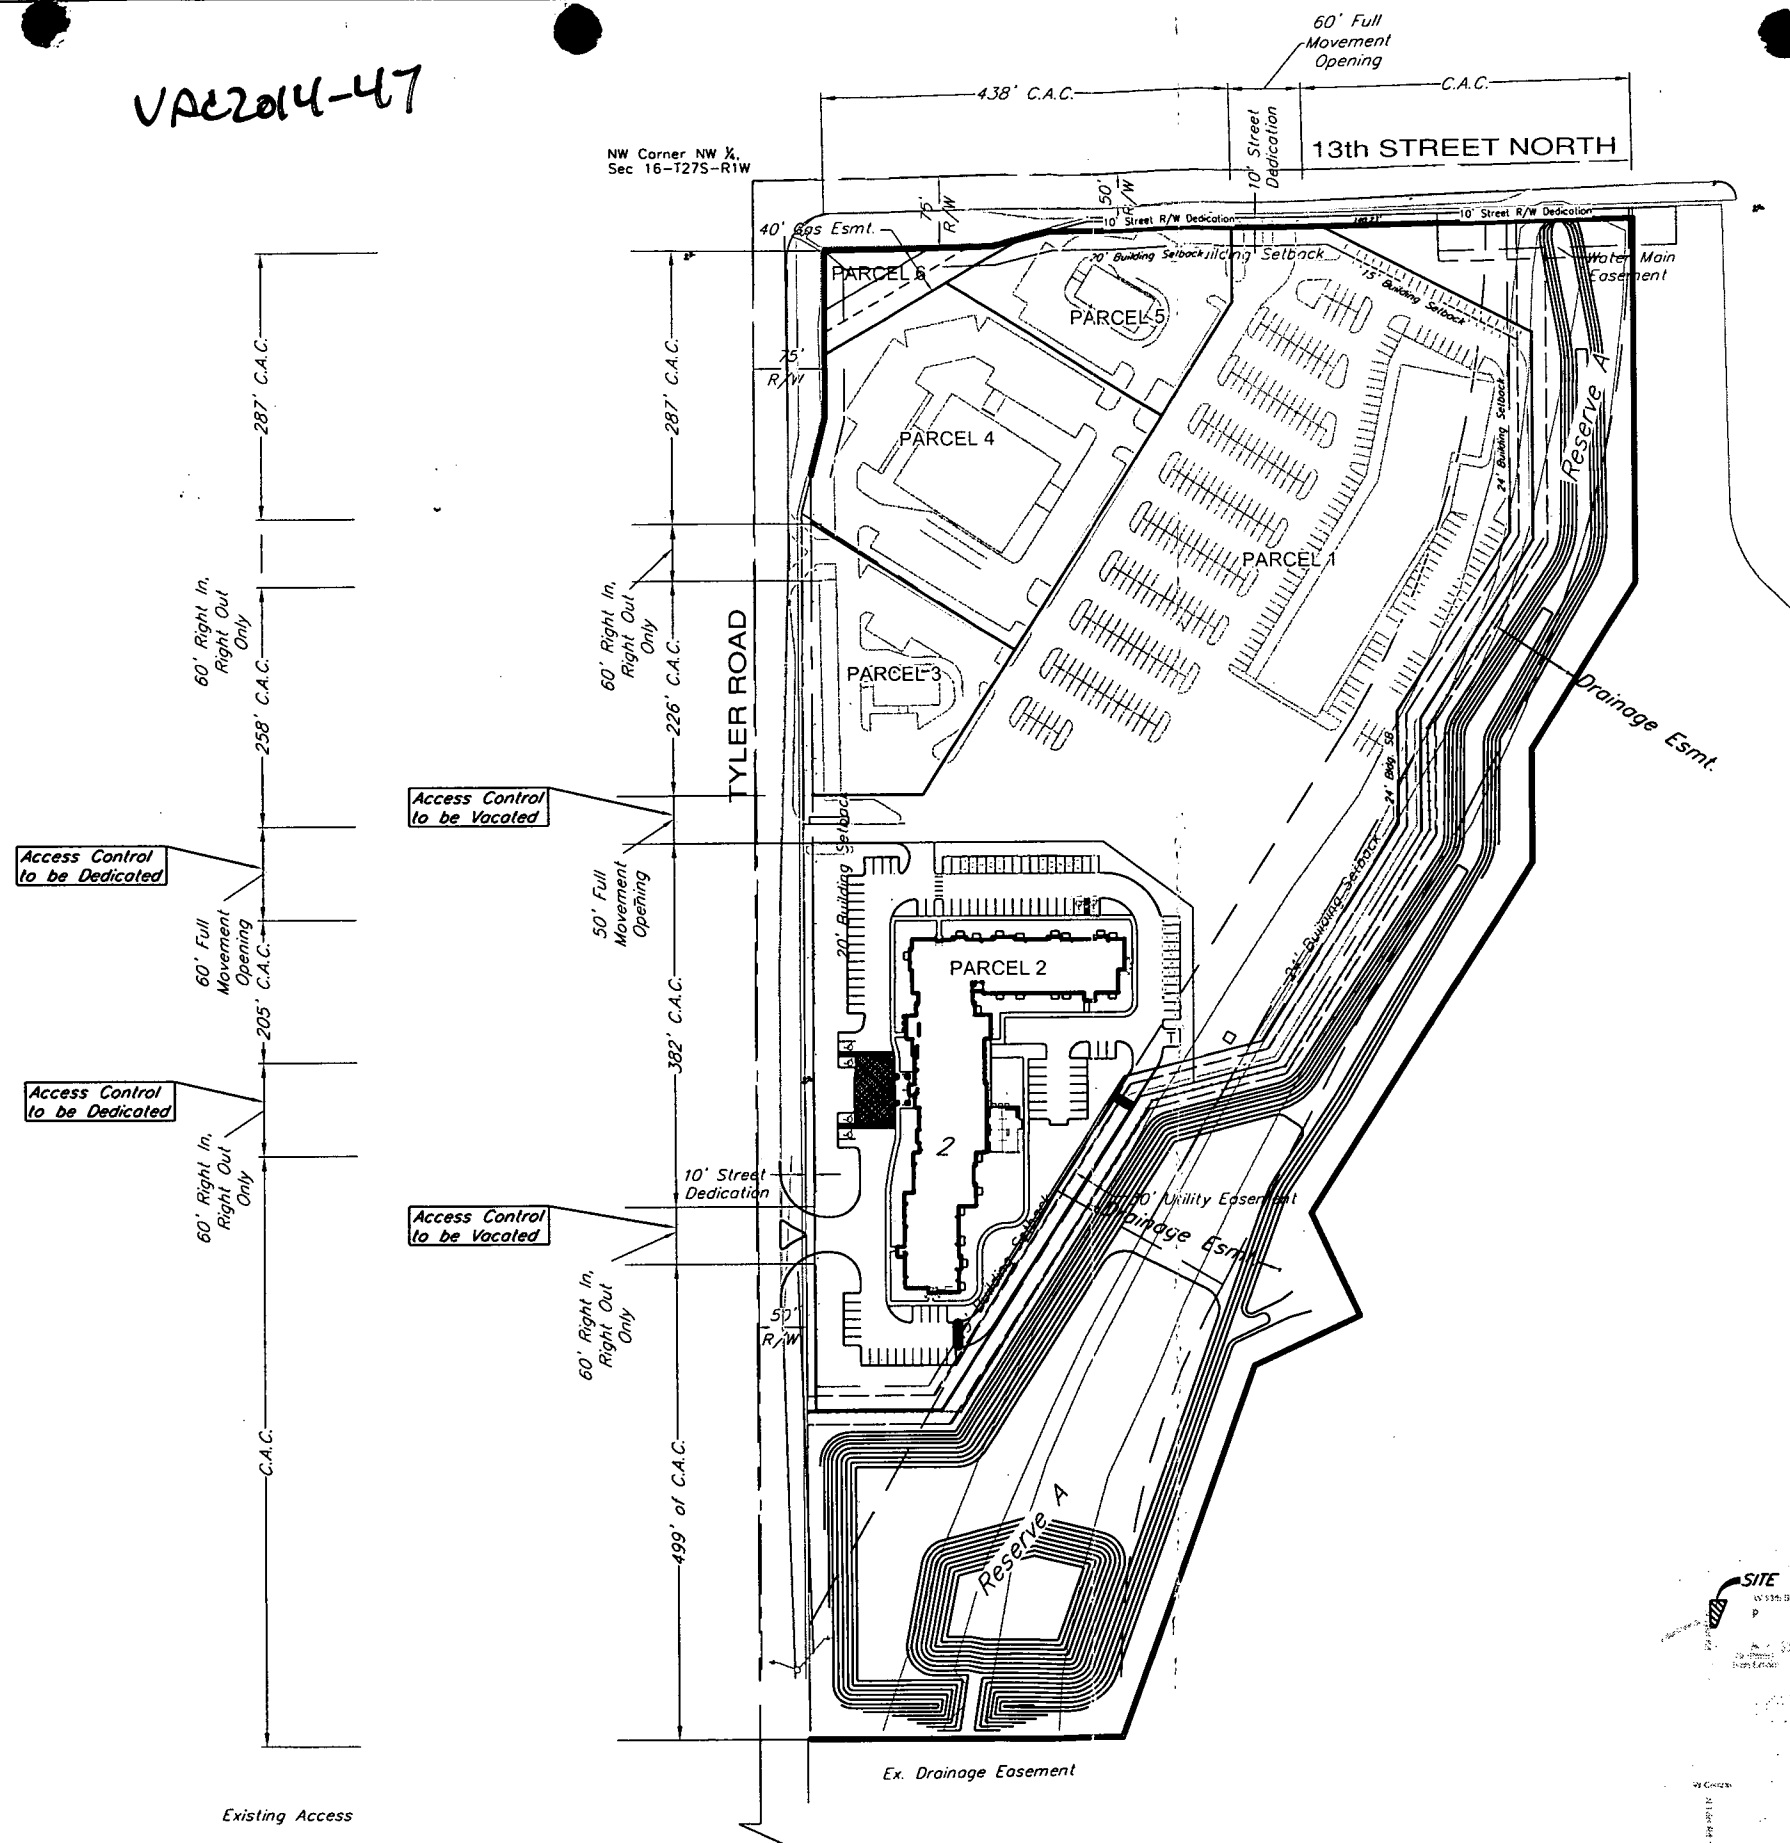


VAC2014-47

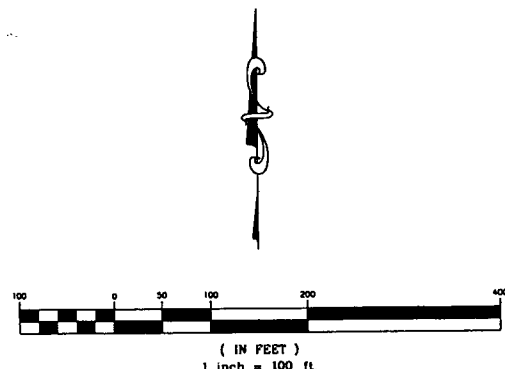

Existing Access

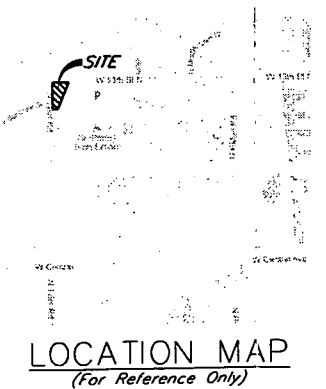

14157

KEMILLER
ENGINEERING PA
117 E. Lewis, Wichita, KS 67202 (316)264-0242