


# SITE PLAN

VAC2014-48

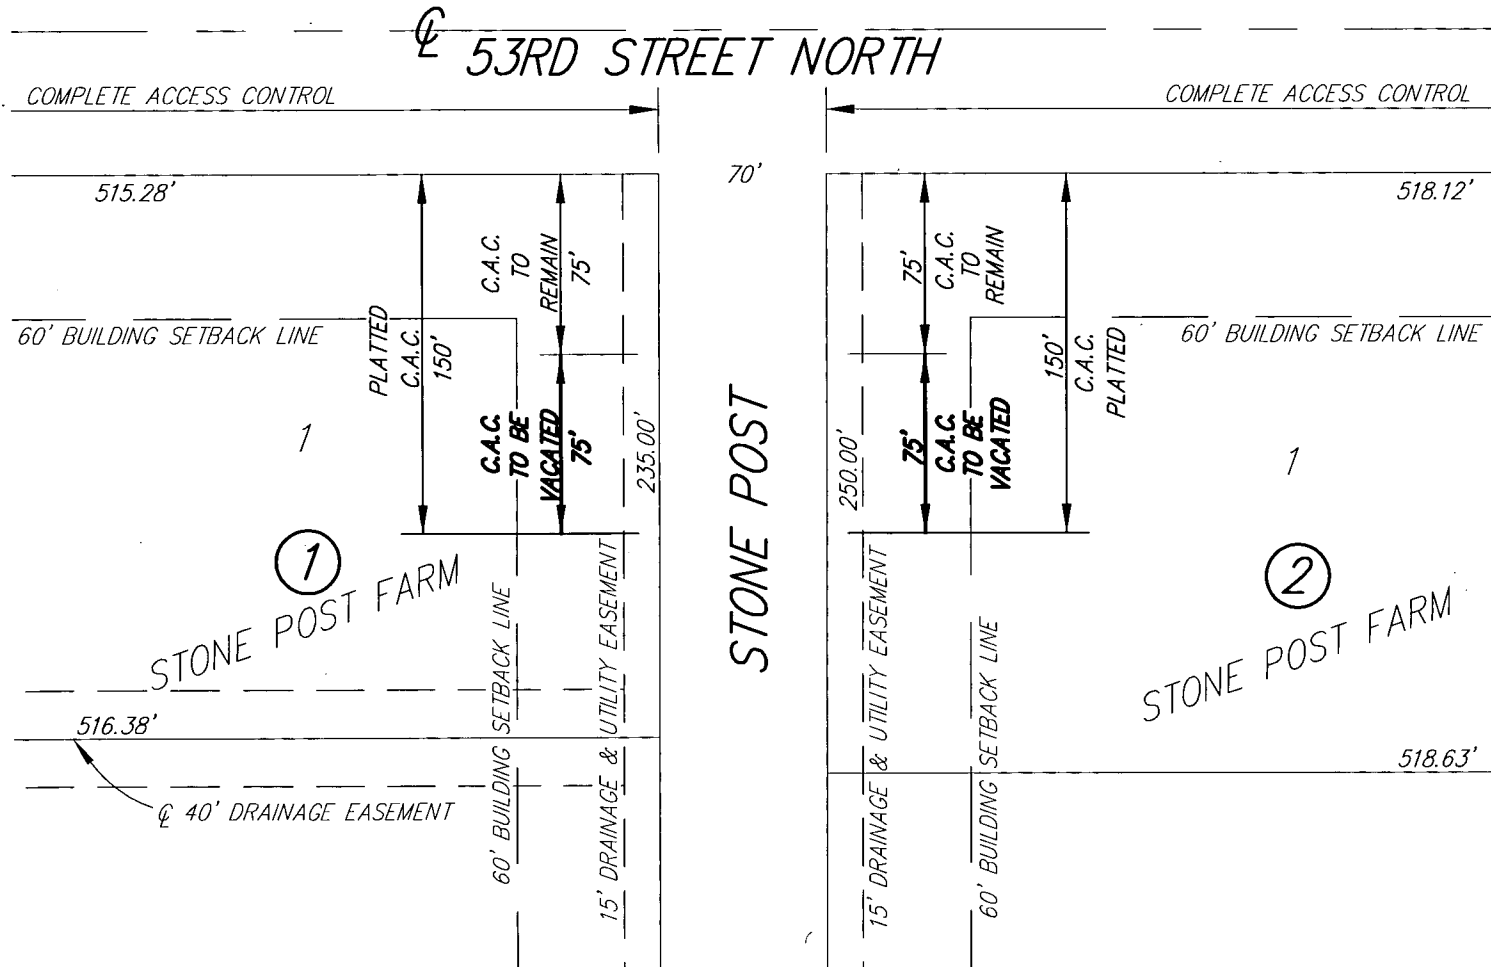


VACATION DESCRIPTIONS

The south 75.00 feet of the 150.00 Complete Access Control platted on Lot 1, Block 1, Stone Post Farm, Sedgwick County, Kansas.

The south 75.00 feet of the 150.00 Complete Access Control platted on Lot 1, Block 2, Stone Post Farm, Sedgwick County, Kansas.

DWG FILE: VACATION EXHIBIT  
PROJECT NO. 4431V

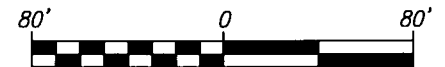

C.A.C. = COMPLETE ACCESS CONTROL