



4/29/15
UST

DOUGLAS

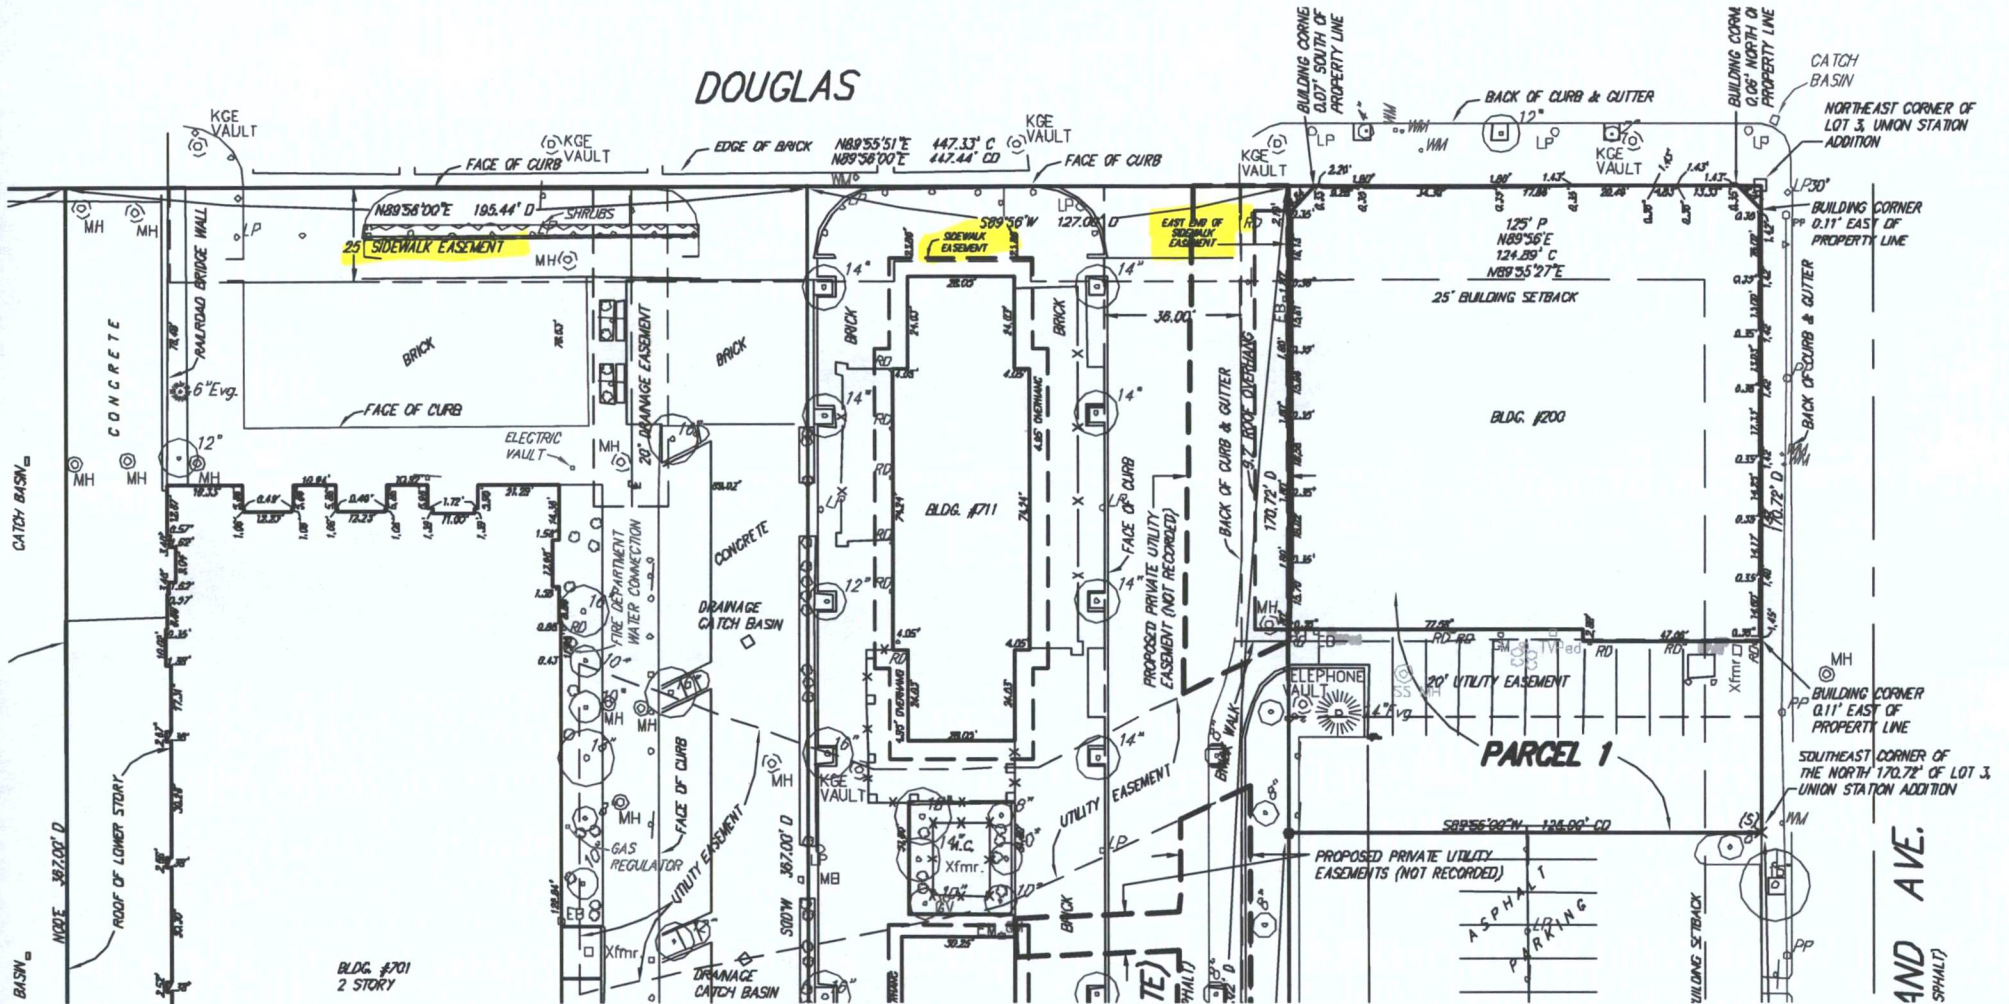

VAC 2015-25

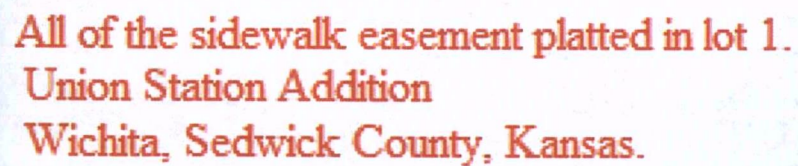

Wichita, Sedwick County, Kansas.