


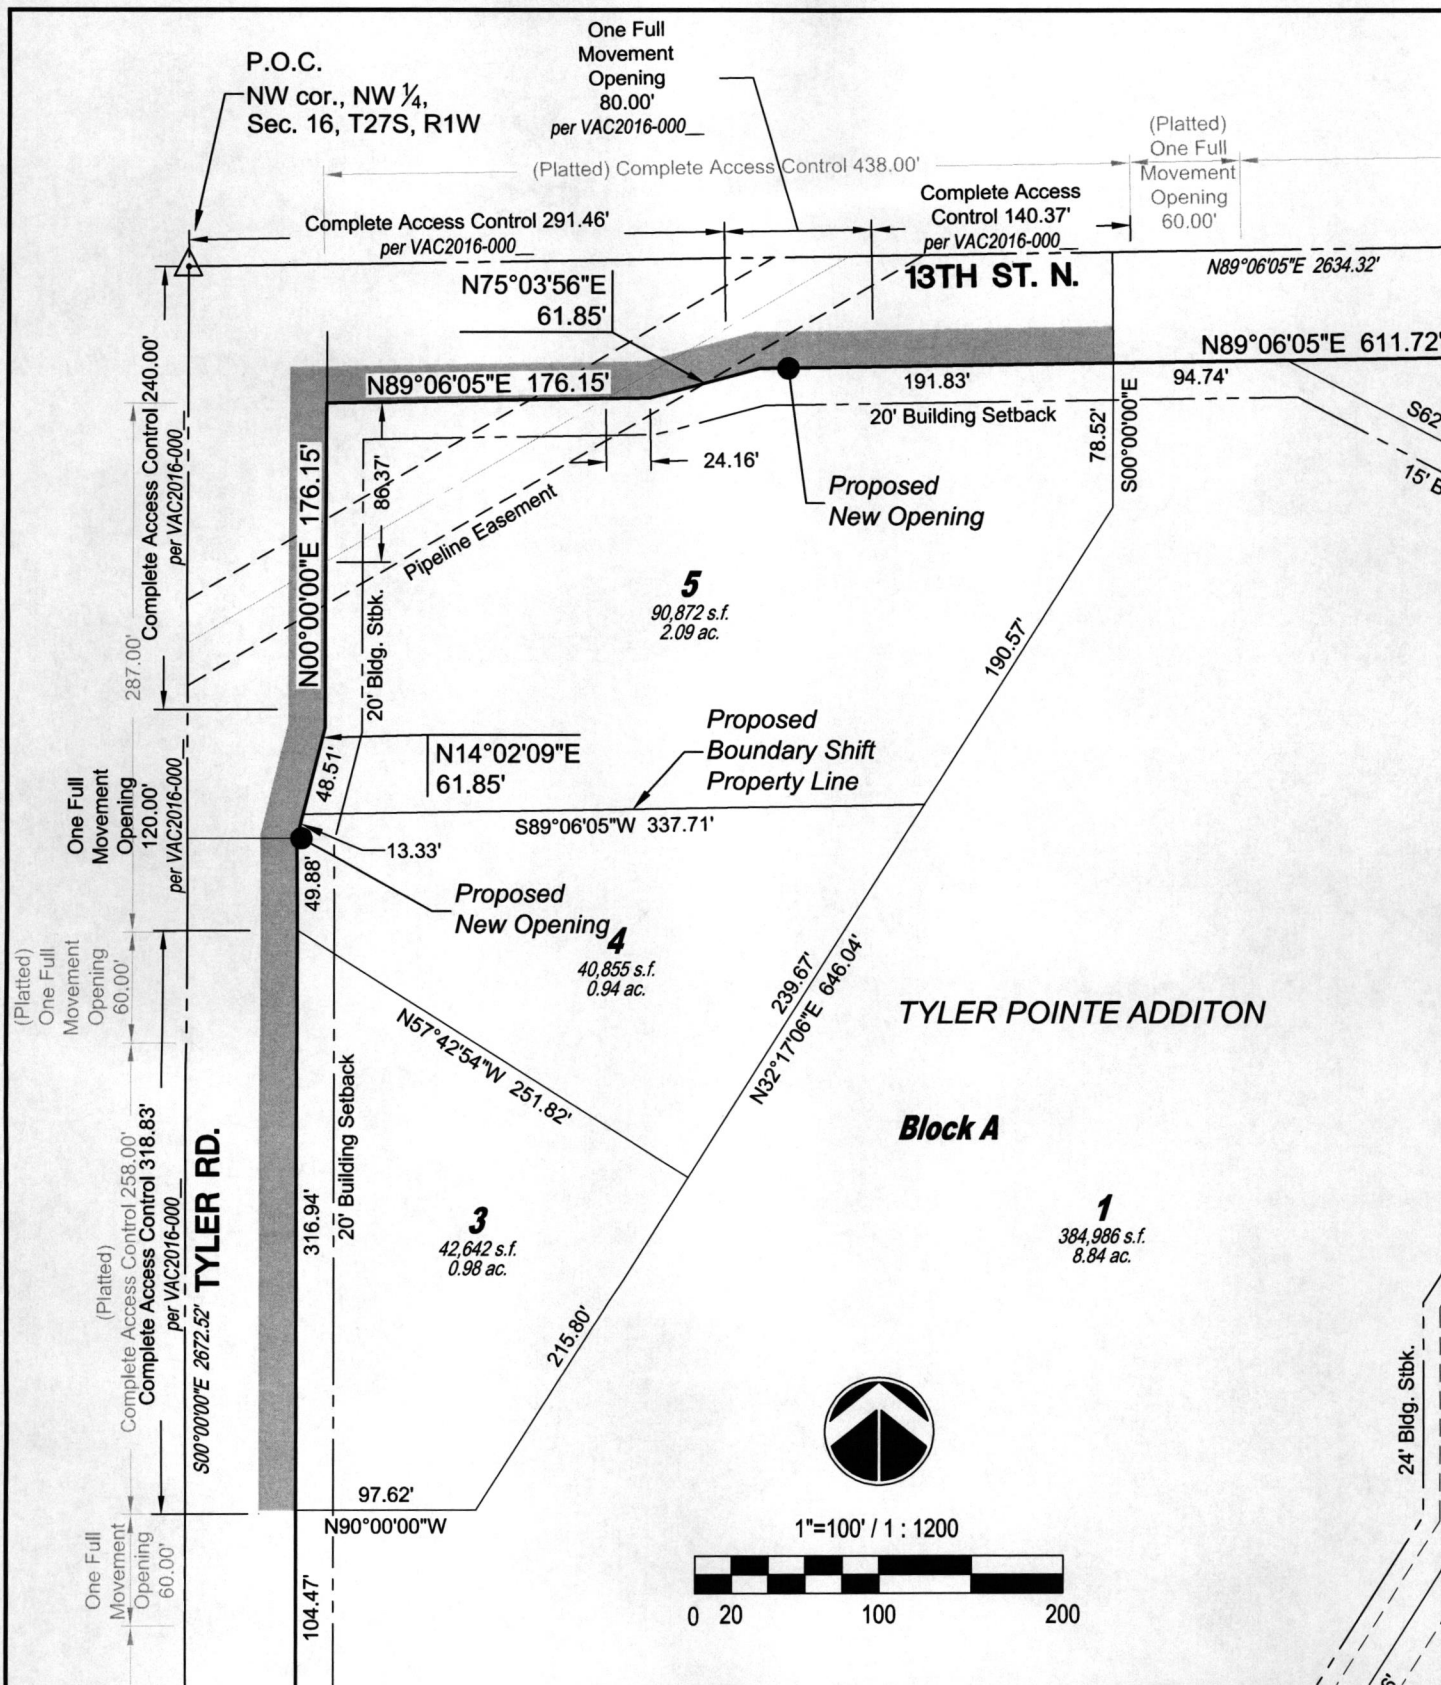

- Vacation Case
Area

©2016
MKEC Engineering
All Rights Reserved
www.mkec.com
These drawings and their contents,
including, but not limited to, all
concepts, designs, & ideas are the
exclusive property of MKEC
Engineering (MKEC), and may not be
used or reproduced in any way without
the express consent of MKEC.



VACATION CASE EXHIBIT
VAC2016-000
TYLER POINTE ADDITION

PROJECT NO. 1501010321	DATE: OCTOBER 2015	SHEET NO.
DRAWN BY: JGD	DESIGNED BY: BDL	APPROVED BY: BDL
		1 OF 1

J:\PROJECTS\2016\1601010441_01_374R DEVELOPMENT SERVICES\160441 CAD\REV\MKEC\05 CIVIL\MODELS\16441FL.DWG