


CENTRAL AVENUE

TALLYRAND STREET

TALLY-
RAND ST.

⊕ site concept plan

0 20'

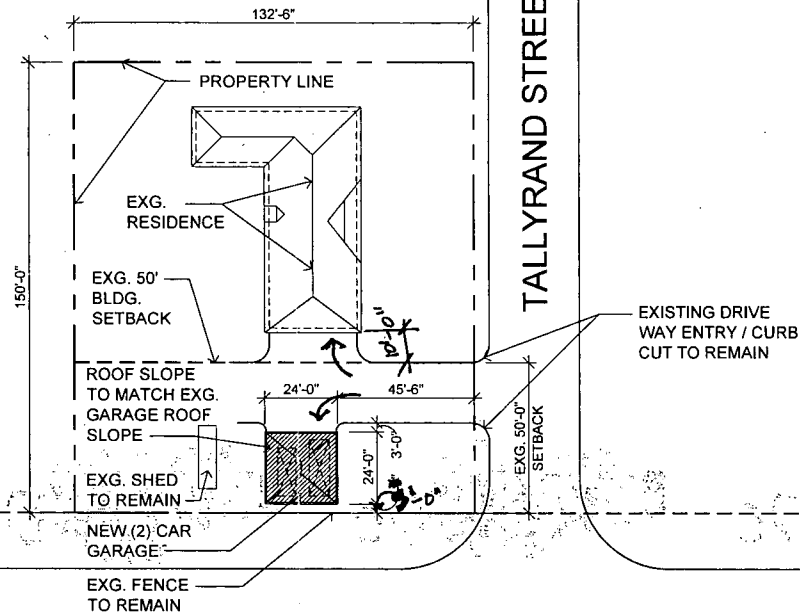

martinez addition

501 N TALLYRAND
10.10.16