
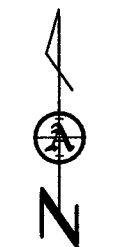


SITE PLAN

LOT 63, BLOCK 2, KRUG SOUTH ADD. TO WICHITA, KS.

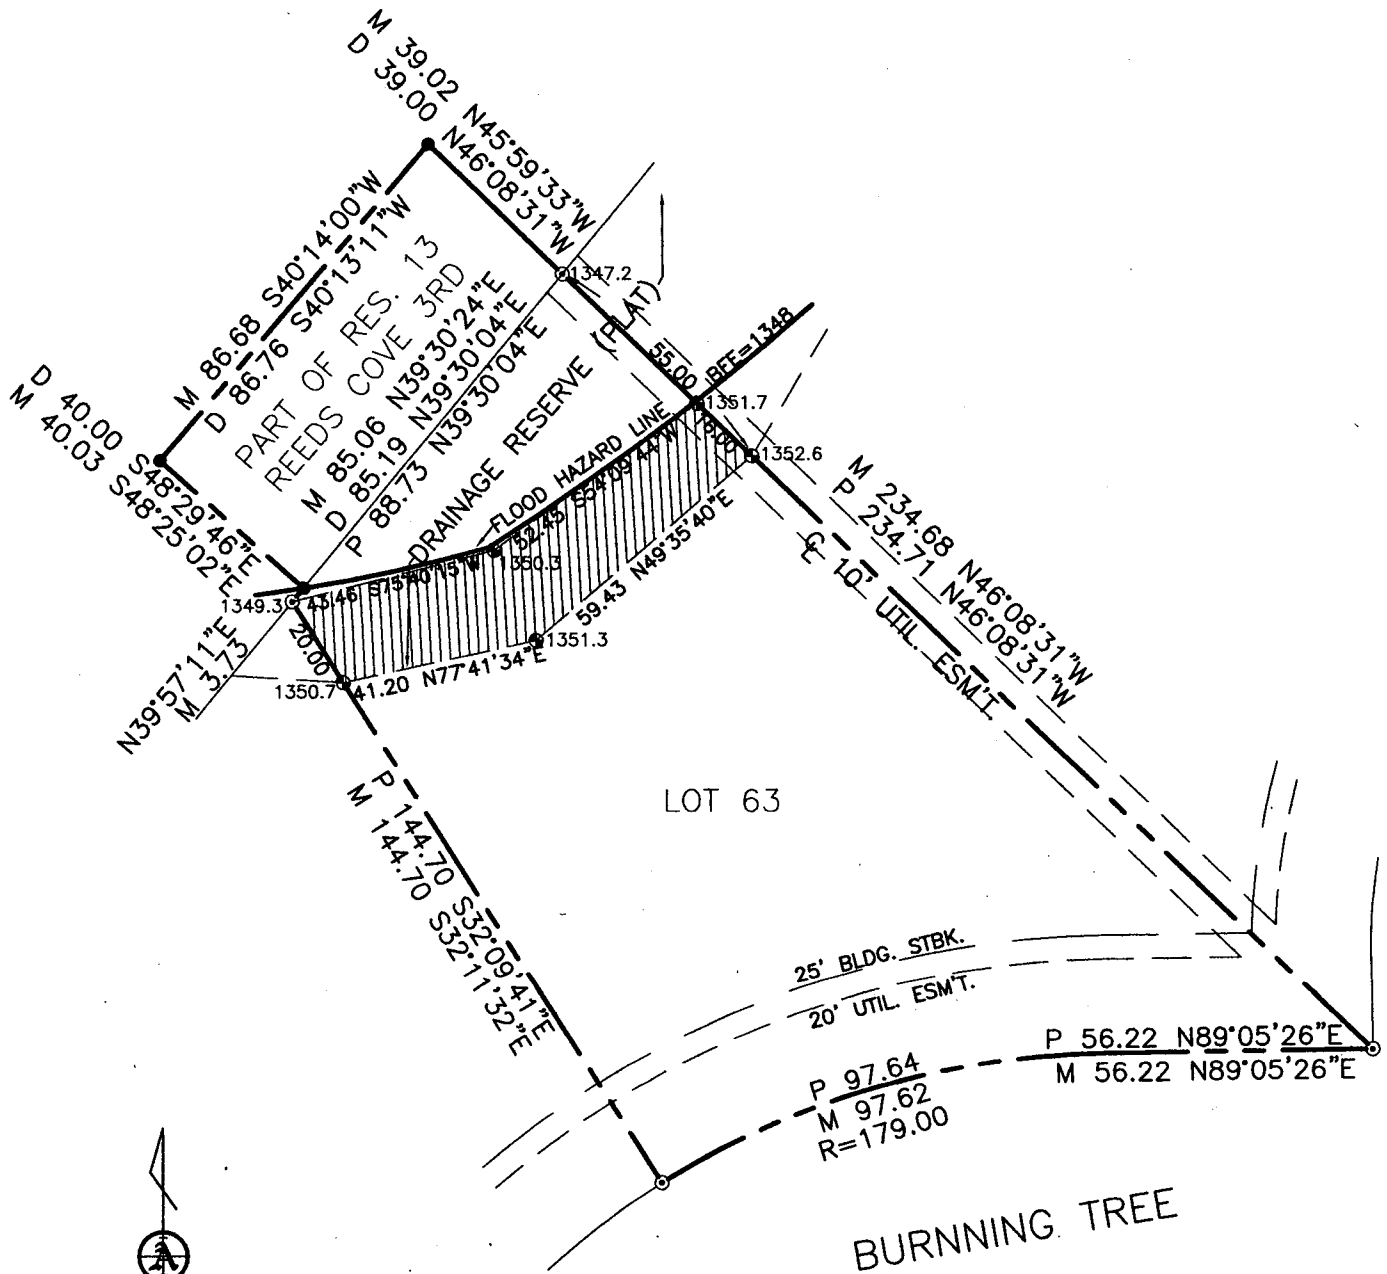

SCALE 1"=40'

- ⊕ - "LS-780" capped rebar set
- - "BAUGHMAN" capped rebar found
- ⊙ - "MKEC" capped rebar found
- M - measured distance
- P - plat distance
- D - deed distance



**ARMSTRONG
LAND SURVEY, P.A.**

1601 E. HARRY
WICHITA, KS 67211
PH. (316) 263-0082
surveys@armstrong.kscoxmail.com

W.O. #38250
Page 2 of 2