



EXHIBIT

**TWO ACCESS OPENINGS OVER AND ACROSS
THE NORTH LINE OF LOT 1, BLOCK 2, PARKSTONE ADDITION
TO WICHITA, SEDGWICK COUNTY, KANSAS**

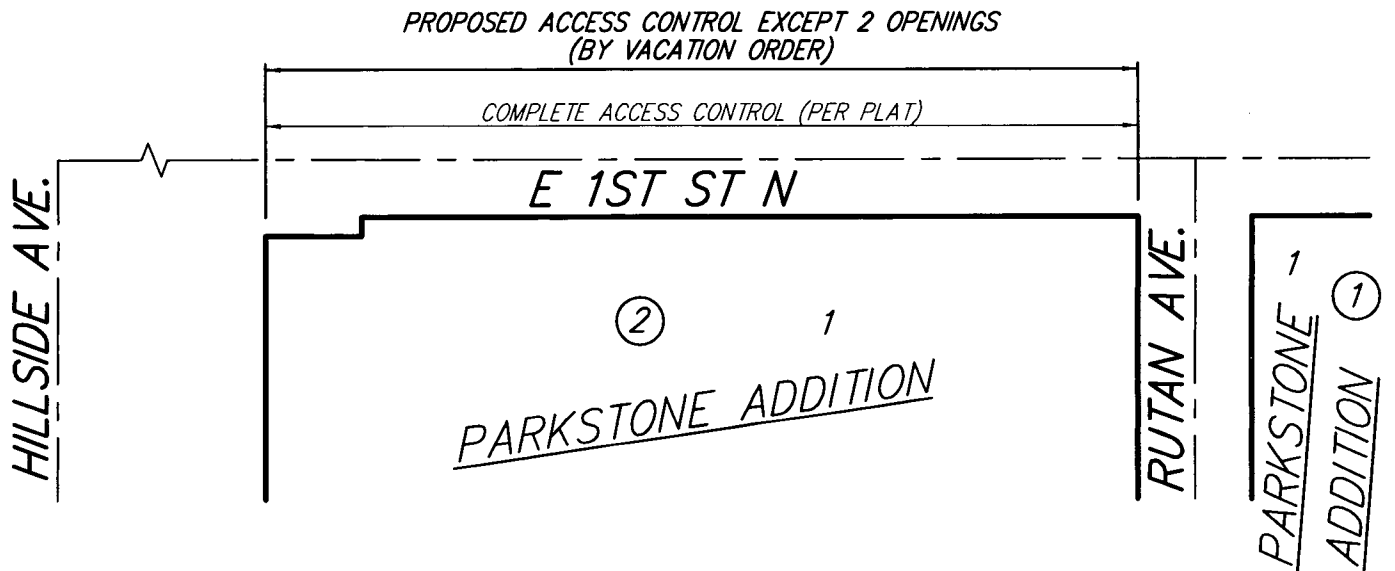

8 JUNE 2017

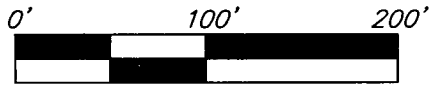