



FILE COPY

Wichita-Sedgwick County Metropolitan Area Planning Department

June 26, 2003

Vi Singleton
11311 W. Murdock
Wichita, KS 67212

Re: **BZA2003-0003²**: Zoning Adjustment to reduce the rear setback from 20 feet to 16 feet.

Legal Description: Lot 14, Block 5, Golden Hills 2nd Addition, Wichita, Sedgwick County, Kansas. Generally located north of Central and east of 119th St. W. (11311 W. Murdock).

We have reviewed your request for a Zoning Adjustment to reduce the rear setback on the above-referenced property. From reviewing your application, we understand that you propose to add a 9-foot x 20-foot sunroom near the southeast corner of the house and that the southeast corner of the sunroom will be set back from the rear property line only 16 feet. Therefore, you have requested a Zoning Adjustment to reduce the rear setback required by the "SF-5" Single-Family zoning district from 20 feet to 16 feet.

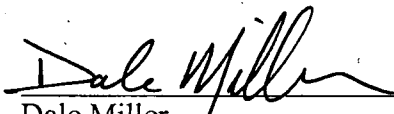
Sec. V-I.2.a. of the Unified Zoning Code allows an adjustment to reduce the rear setback by up to 20 percent when the conditions required by Sec. V-I.6. of the Code are met. We find that the reduction of the rear setback as proposed meets the four conditions required by Sec. V-I.6 of the Code as set out below:

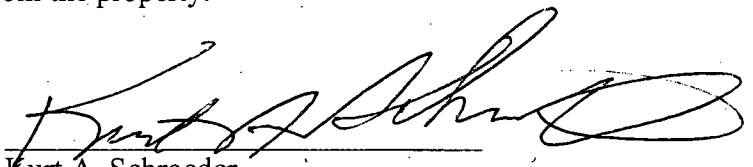
- 1) Impact on safety and convenience of vehicular and pedestrian circulation: The proposed encroachment into the setback should not detrimentally impact the safety and convenience of vehicular and pedestrian circulation in the vicinity, as the rear yard is not used for circulation.
- 2) Impact on existing uses in surrounding areas: There should be no negative impact on the existing uses in surrounding areas as a result of the reduction of the setback, as the addition will compliment the character of the existing single-family residence.
- 3) Compatibility with existing or permitted uses on abutting sites: The design of the addition is compatible with abutting sites, which are developed in a similar fashion with single family residences and sufficient space will remain between structures to maintain compatibility.
- 4) Effect on public health, safety or welfare: There will be no encroachment into public utility easements or right-of-way; therefore, there should not be a negative impact on the public health, safety or welfare nor will properties or improvements in the vicinity be materially injured.

Our signatures below indicate that a Zoning Adjustment to reduce the rear setback from 20 feet to 16 feet for the aforementioned property is hereby granted, subject to the following conditions:

- 1) The site shall be developed in general conformance with the approved site plan.
- 2) The setback reduction shall apply only to the "New 9' x 20' Sunroom Addition" as illustrated on the approved site plan. All other structures or additions on the subject property shall conform to the setbacks permitted by the Unified Zoning Code unless a separate Zoning Adjustment or Variance is granted.
- 3) If the Zoning Administrator finds that there is a violation of any of the conditions of the Zoning Adjustment, the Zoning Administrator, in addition to enforcing the other remedies set forth in Article VIII of the Unified Zoning Code, may, with the concurrence of the Planning Director, declare that the Zoning Adjustment is null and void.

The zoning adjustment sign may now be removed from the property.


Dale Miller
Acting Planning Director


Kurt A. Schroeder
Superintendent of Central Inspection

Enclosure

cc: Dan Allen, All Weather Products, 1011 N. Main, Wichita, KS 67203
Kurt Schroeder, Office of Central Inspection
Paul Hays, Office of Central Inspection
Randy Sparkman, Office of Central Inspection
J.R. Cox, Office of Central Inspection

RESIDENTIAL PLOT PLAN

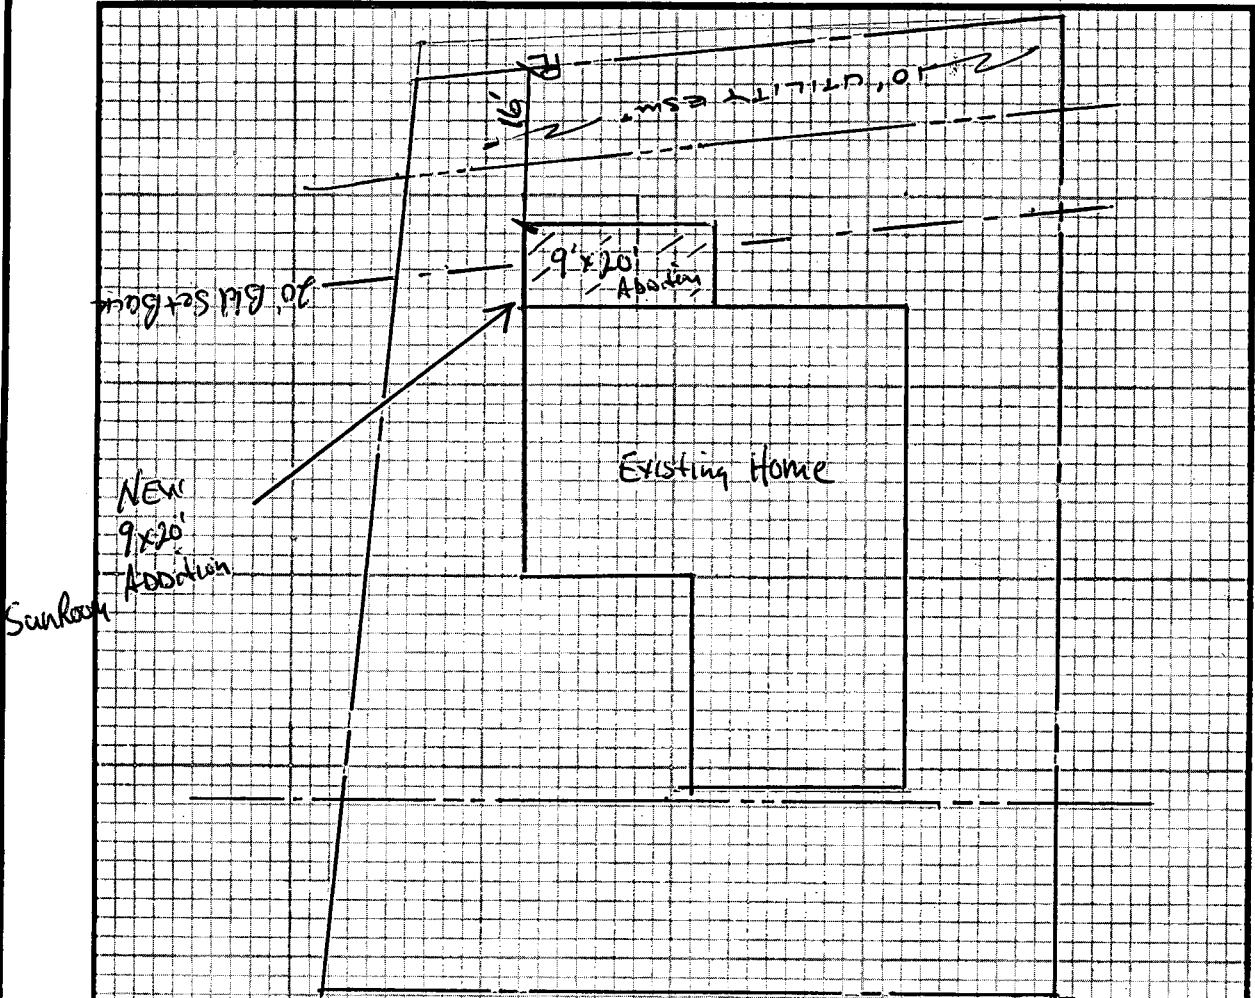
ADDRESS: 11311 W. MURDOCK
 LOT(S): 5 BLK. 14 OF Golden Hills 2nd
 PERMIT NO. _____
 ZONING _____
 REAR 20
 SIDE _____
 SIDE _____
 REQUIRED SETBACKS: FRONT _____
 SIDE _____
 REAR 20

SITE PLAN

B2A2003-00032

Scale: 1" = 10'-0"
 Grid: 1" = 10'-0"

APPROVED 6-26-03 BY *SV*



I certify that the above plat complies with applicable zoning setbacks and subdivision covenants and restrictions.

Signed: _____

(Applicant)

White Copy - File

Yellow Copy - Applicant

Form No. 225-345 (4-85)

Bill Lumsden