



Wichita-Sedgwick County Metropolitan Area Planning Department

December 31, 2003

Joe Hoover
USD 259
3850 N. Hydraulic
Wichita, KS 67219

Re: BZA2003-00072: Zoning Adjustment to allow a parking area for Woodman Elementary School to be located in the street side setback along Glenn on property zoned "SF-5" Single-Family Residential.

Legal Description: Lot 1, Block 9, Glenn Village Addition, Wichita, Sedgwick County, Kansas. Located south of Pawnee and east of Hiram (2500 S. Hiram).

Dear Mr. Hoover:

We have reviewed your request for a Zoning Adjustment to allow parking in the street side setback on the aforementioned property. You state in your application that you plan to use this area for required off-street parking for an elementary school and that you desire to park in the street side setback no closer than 15 feet from the right-of-way line for Glenn to preserve an existing play equipment area and to have the parking area close to the building for better access for parking spaces for persons with disabilities.

Sec. V-I.2.1. of the Unified Zoning Code allows an adjustment to permit parking in residential districts to be located within required front and street side setbacks, but in no case closer to the property line than 8 feet, when the conditions required by Sec. V-I.6. of the Code are met. We find that allowance of parking within the setback as proposed meets the four conditions required by Section V-1.6 of the Unified Zoning Code as set out below:


- 1) Impact on safety and convenience of vehicular and pedestrian circulation: Sufficient open space between the parking area and the property line will remain to prevent vehicles from encroaching upon the right-of-way; therefore, the safety and convenience of vehicular and pedestrian circulation should not be negatively impacted.
- 2) Impact on existing uses in surrounding areas: There should not be a negative impact on the existing uses in the surrounding areas as a result of parking within the setback as no residential front yards are located adjacent to the parking area.

- 3) Compatibility with existing or permitted uses on abutting sites: Schools and associated accessory uses such as parking are permitted in residential zoning districts, and the allowance of parking within the setback should not compromise existing or permitted uses on abutting sites due to the minor nature of the encroachment of the parking area into the setback and the provision of landscaping for the parking lot.
- 4) Effect on public health, safety or welfare: There will be no encroachment into public utility easements or right-of-way; therefore, there should not be a negative impact on the public health, safety or welfare nor will properties or improvements in the vicinity be materially injured.


Our signatures below indicate that a Zoning Adjustment to allow parking in the street side setback along Glenn, but no closer than 15 feet from the property line, is hereby granted subject to the following conditions:

- 1) The parking area shall be developed in general conformance with the approved site plan.
- 2) All parking areas shall be paved and marked.
- 3) The parking area shall be developed in general conformance with the landscape ordinance.
- 4) If the Zoning Administrator finds that there is a violation of any of the conditions of the Zoning Adjustment, the Zoning Administrator, in addition to enforcing the other remedies set forth in the Unified Zoning Code, may, with the concurrence of the Planning Director, declare that the Zoning Adjustment is null and void.

The zoning adjustment sign may now be removed from the property.

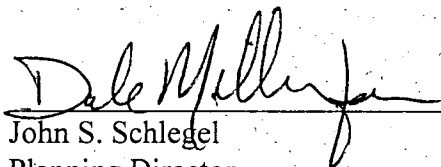

John S. Schlegel
Planning Director

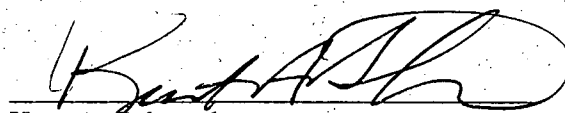


Kurt A. Schroeder
Superintendent of Central Inspection

Enclosure

cc: Kurt Schroeder, Office of Central Inspection
Paul Hays, Office of Central Inspection
Randy Sparkman, Office of Central Inspection
J.R. Cox, Office of Central Inspection

B2A2003-00072
SITE PLAN

APPROVED 12-31-03 BY SK

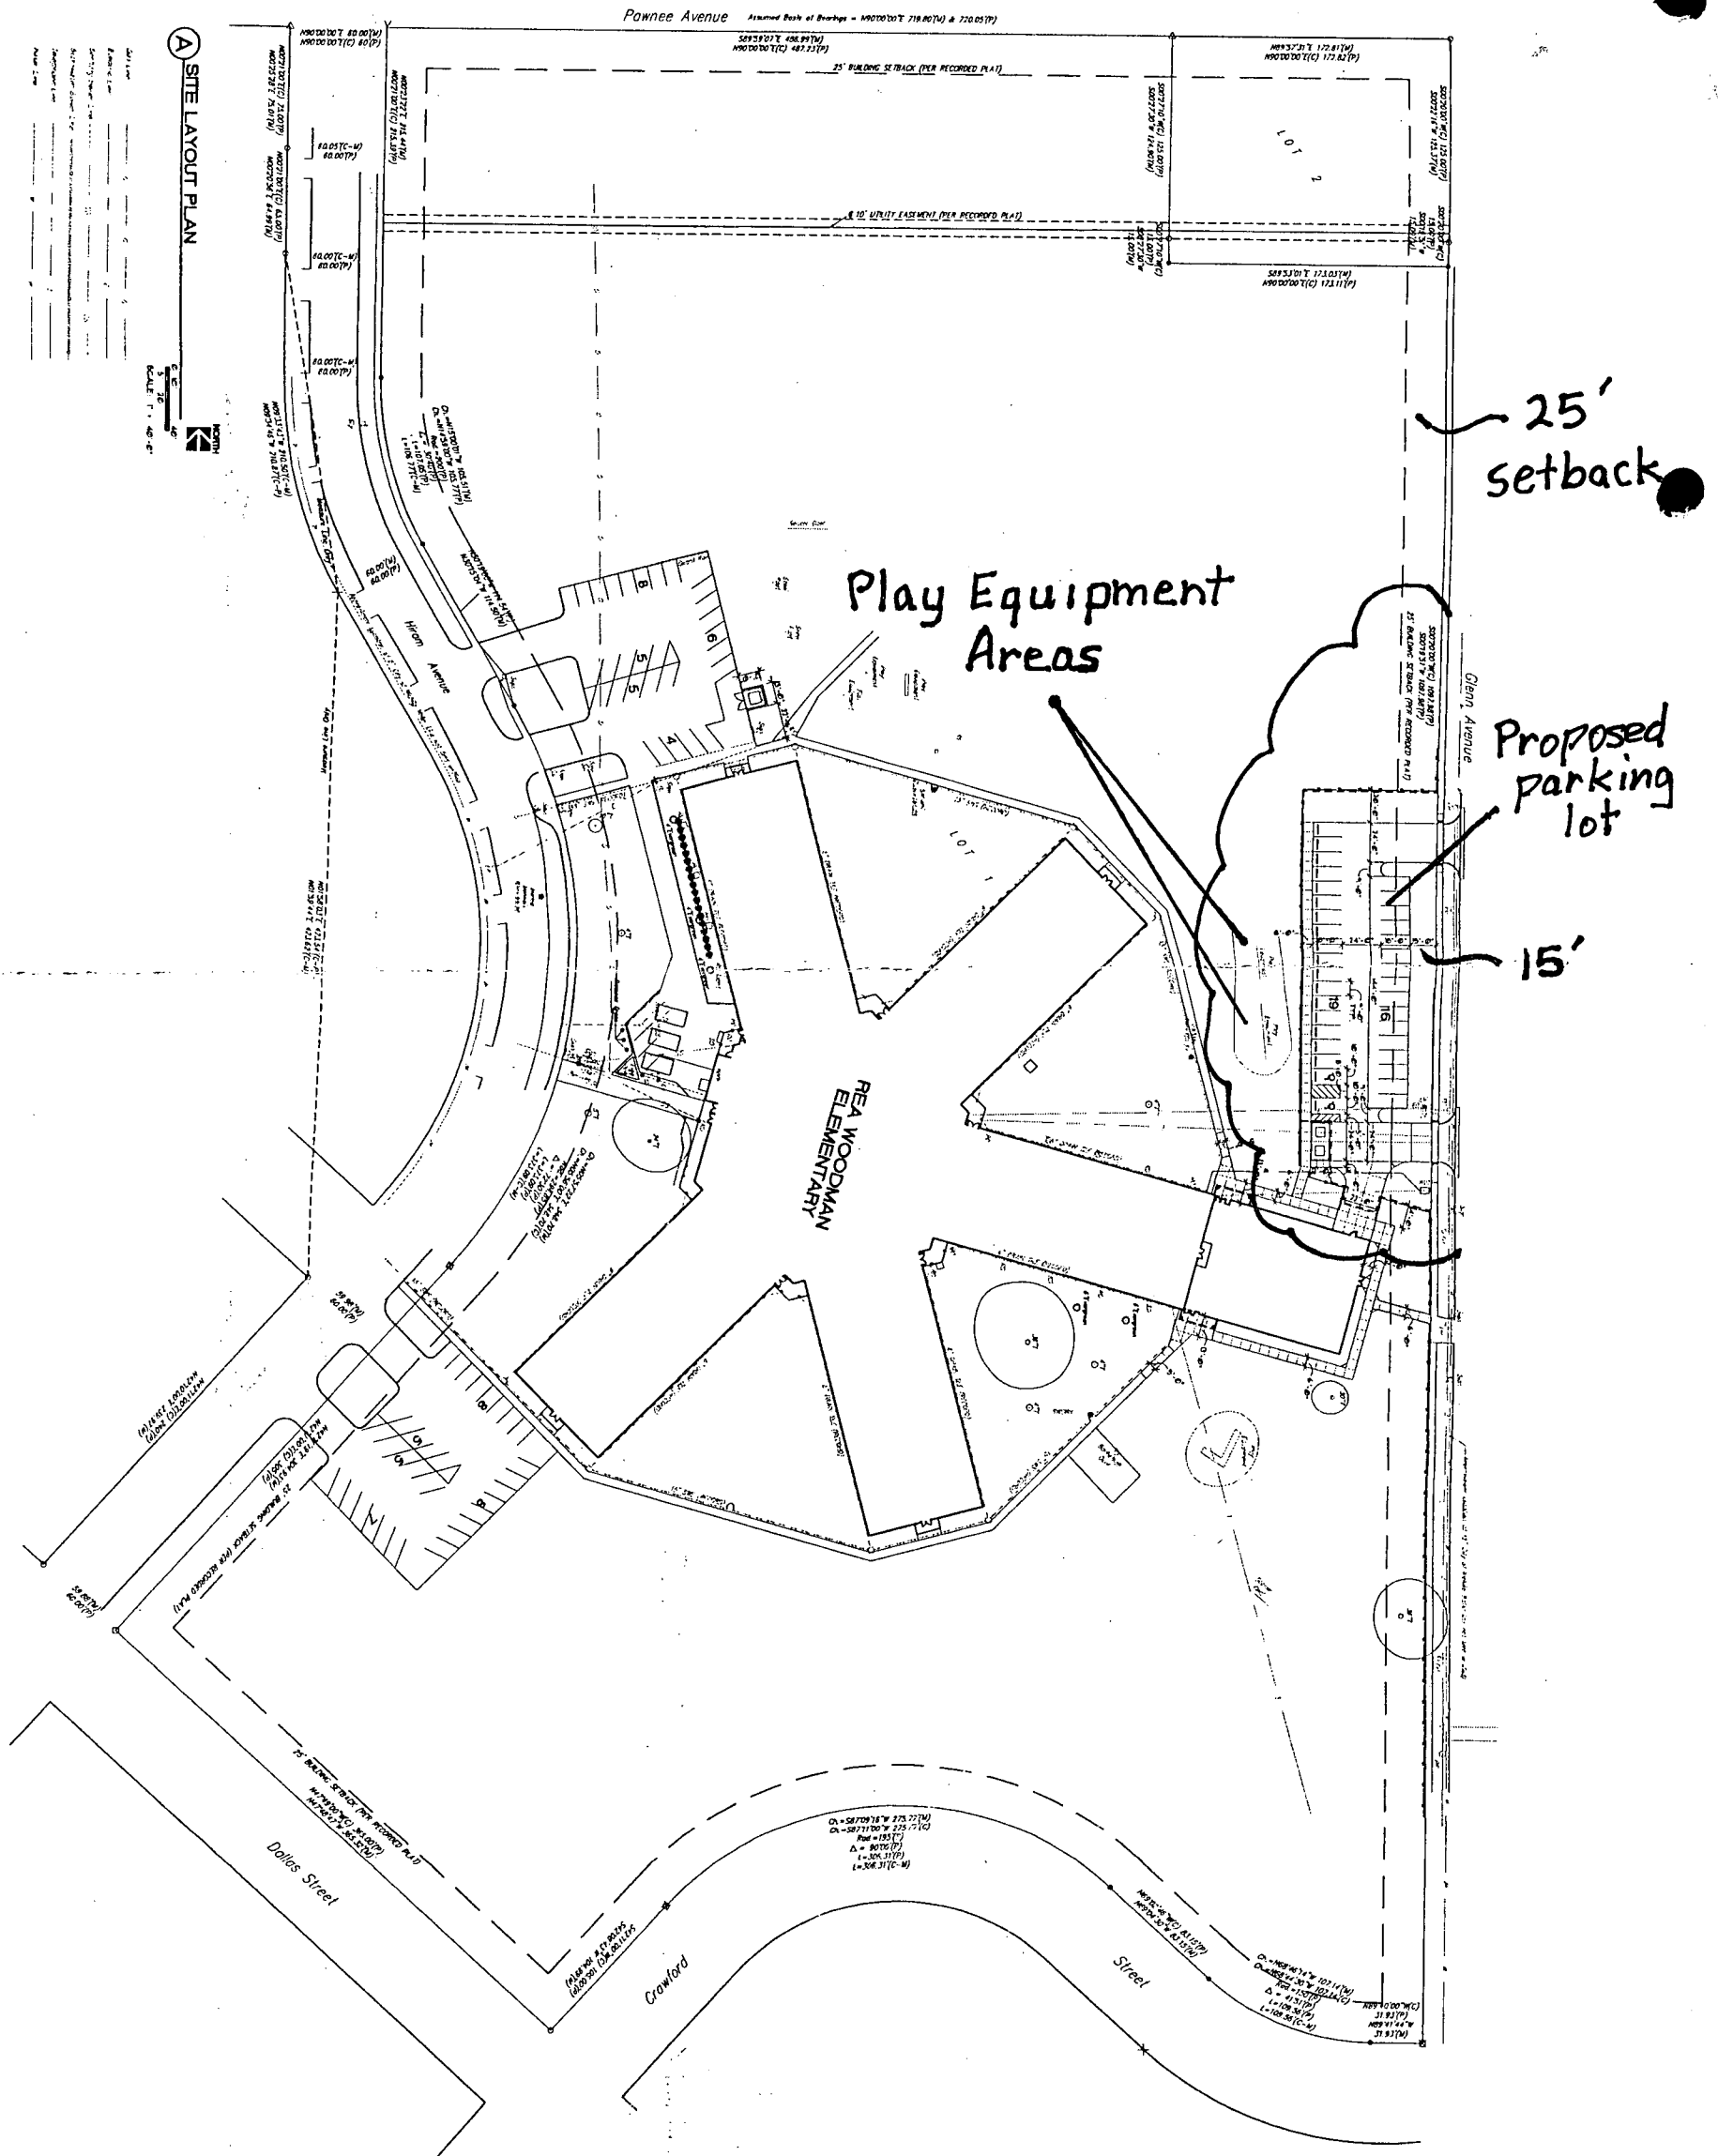

LAYOUT PLAN

SHEET SP3.1 5 OF 30 SHEETS	PROJECT NO. 1806-03 DATE: OCTOBER 31, 2003 REVISED:	WOODMAN ELEMENTARY 2500 HIRAM WICHITA, KS 67217	 WICHITA PUBLIC SCHOOLS	ARCHITECTS - PLANNERS LANDSCAPE ARCHITECTS - INTERIOR DESIGNERS DR. S. WANDERLICH, WICHITA, KANSAS CITY P.O. BOX 300, WICHITA, KANSAS 67201 TEL. 316.261.1000 FAX 316.261.1001	 MCCLUGGAGE VAN SICKLE & PERRY
----------------------------------	---	---	--	--	--