
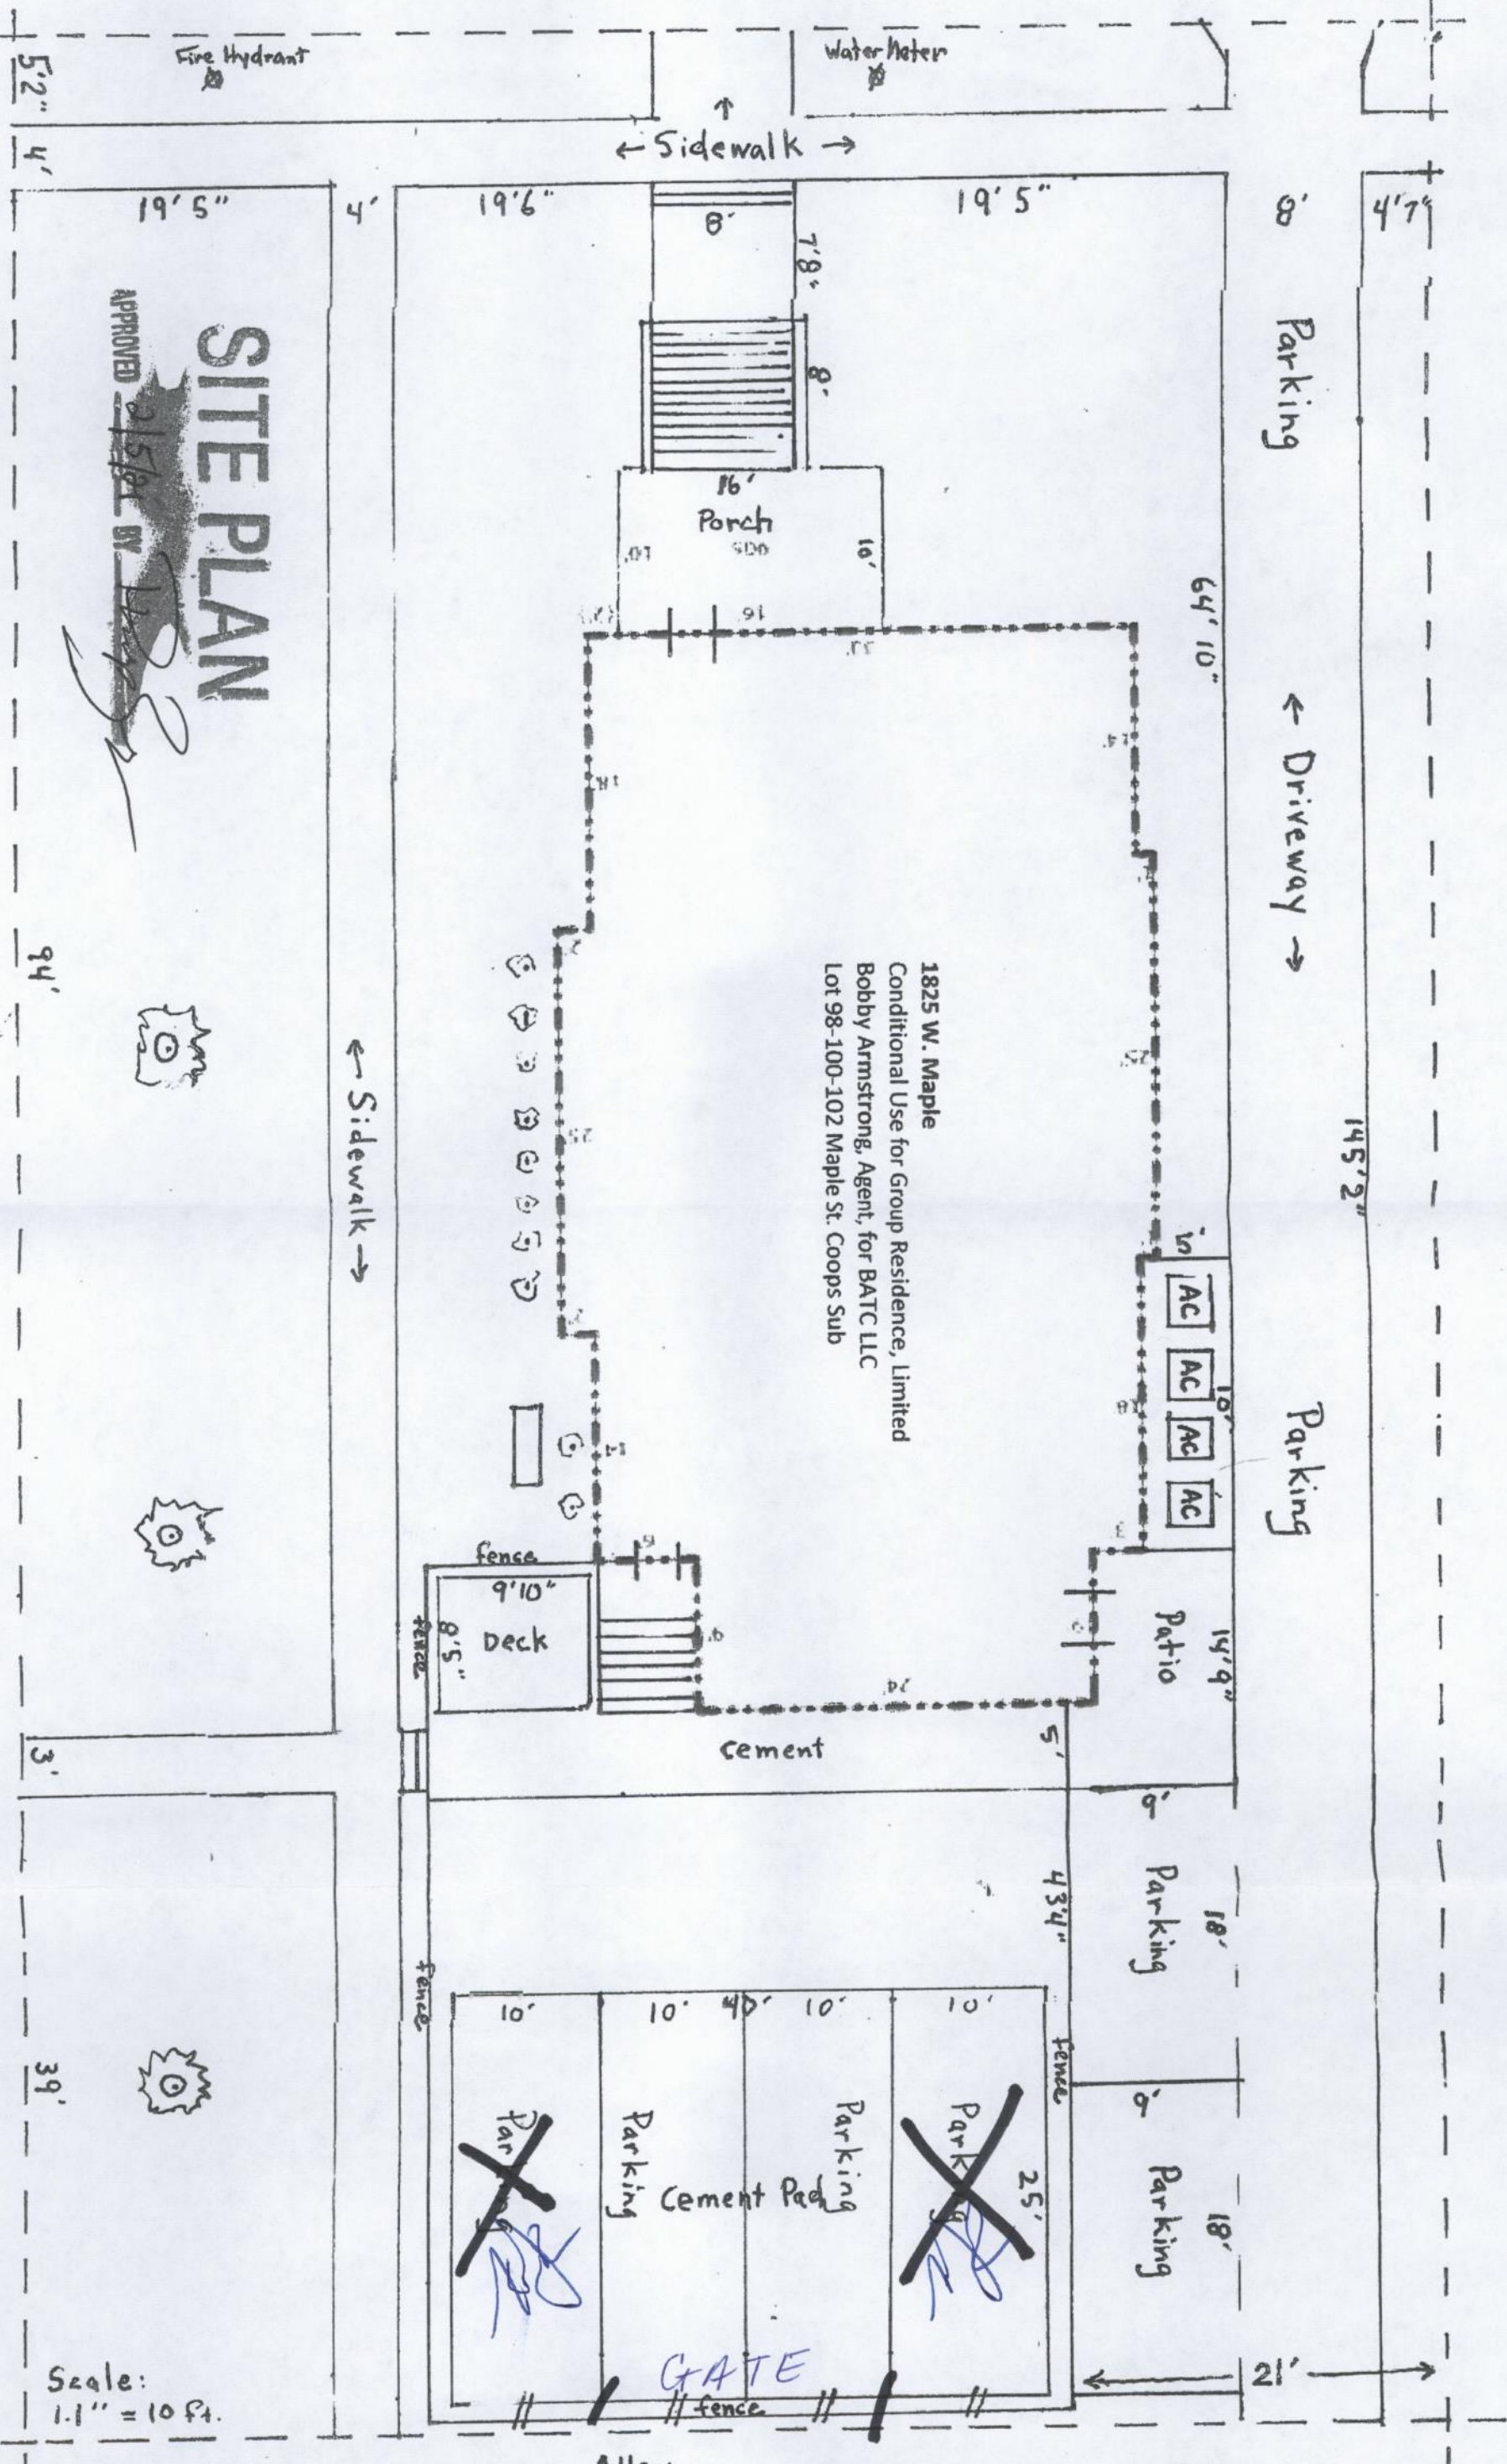


Discover Church

Maple Street

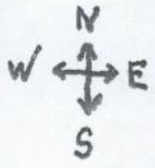

SITE PLAN
APPROVED BY [Signature]

1825 W. Maple
Conditional Use for Group Residence, Limited
Bobby Armstrong, Agent, for BATC LLC
Lot 98-100-102 Maple St. Coops Sub

9'10" Deck
8'5" fence

AC AC AC AC

14'9" Patio

10' 10' 10' 10' 10'
Parking Cement Pad Parking
25'
GATE
fence

Scale:
1.1" = 10 Ft.

Alley